


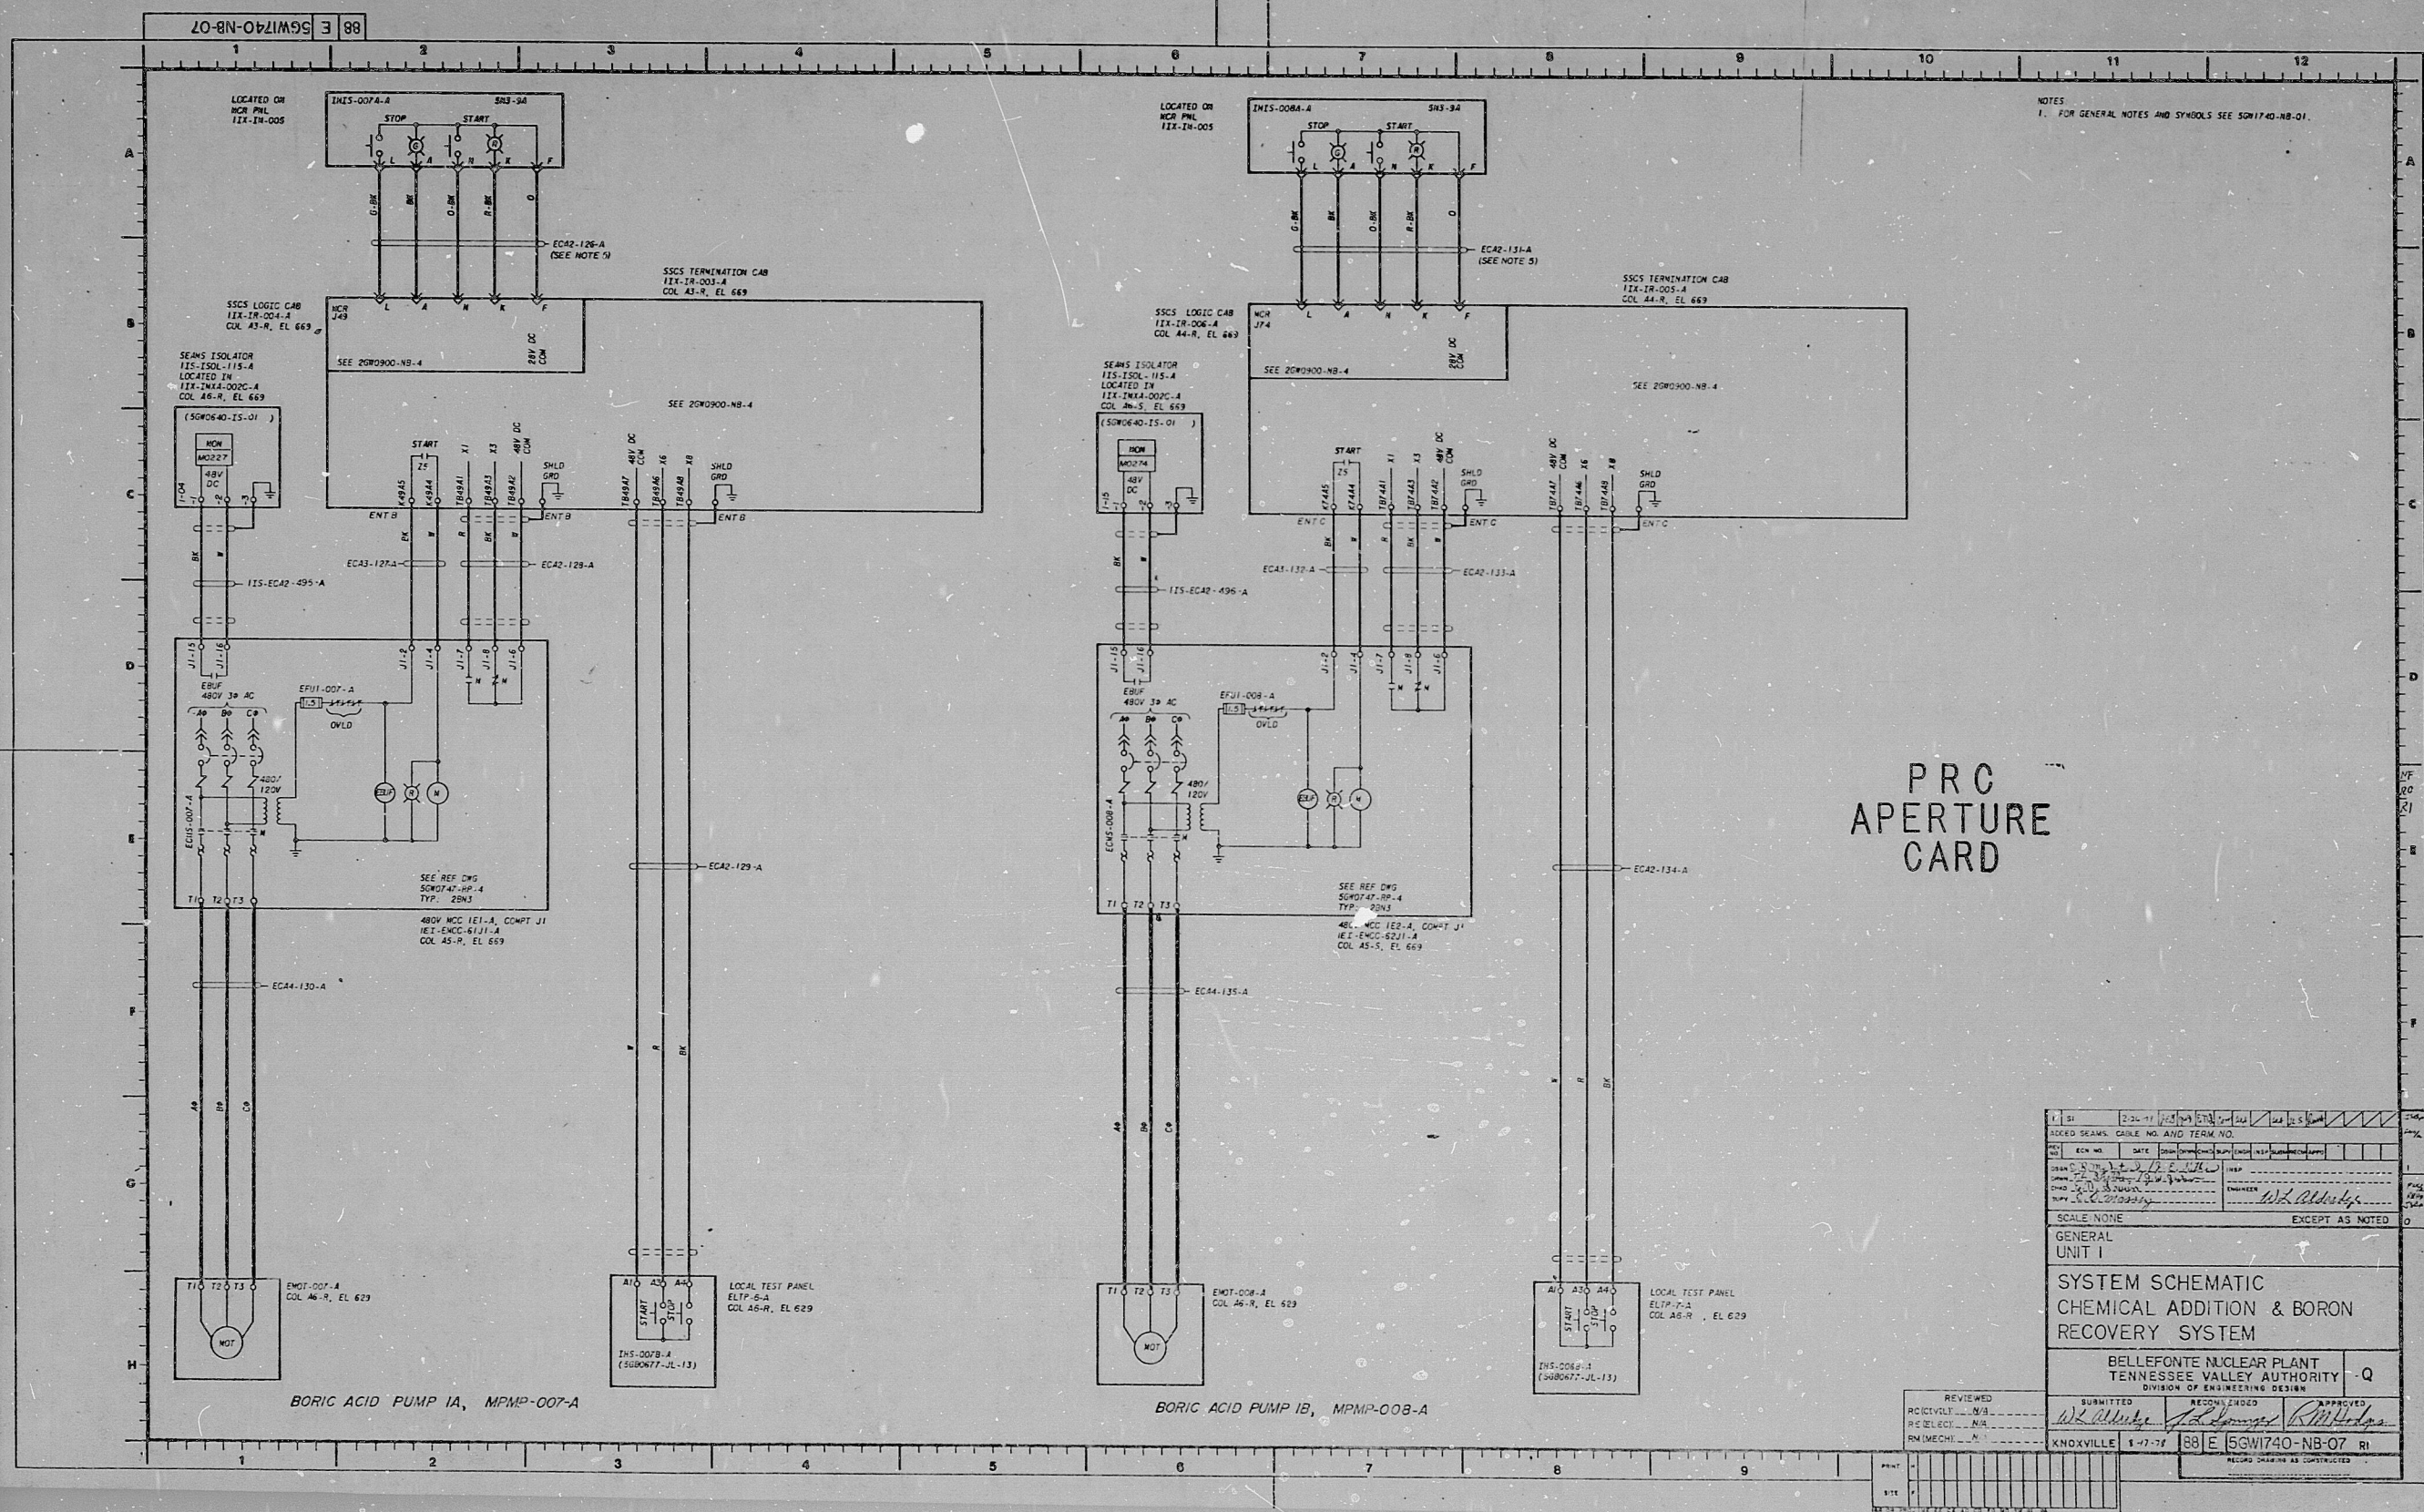



RIDS

8204020115

