


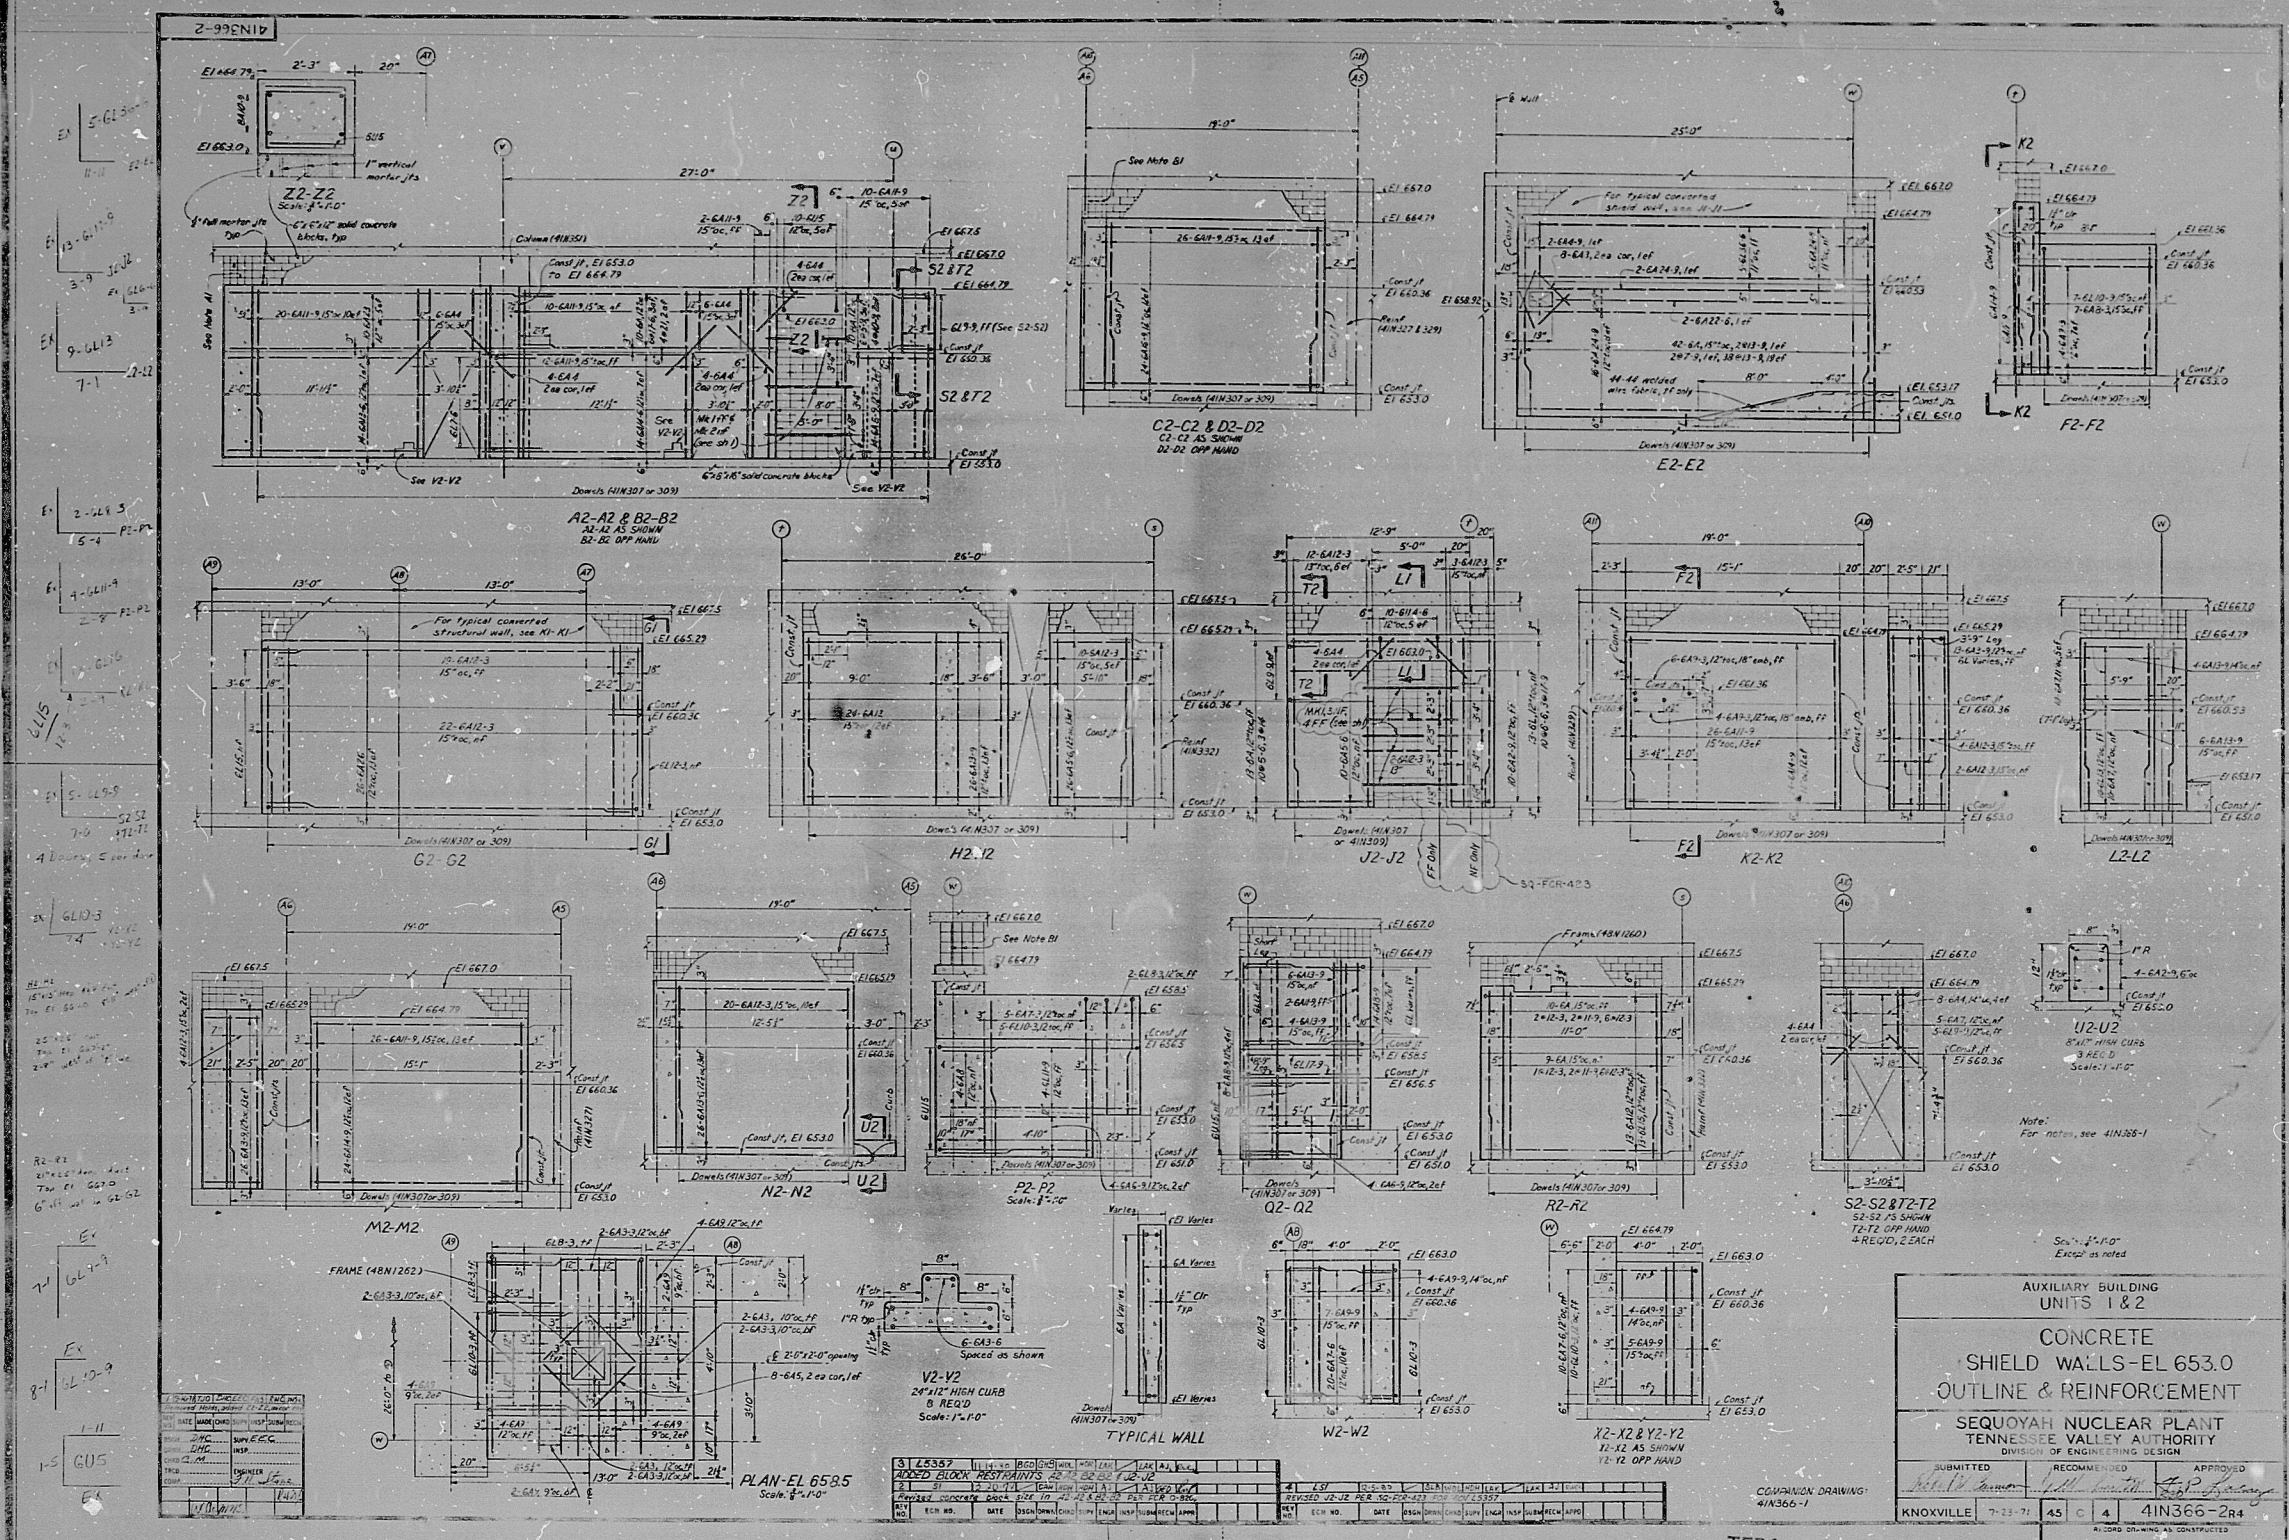



RIPS-

8102040410

