




TI
APERTURE
CARD

PDR RIDS

8503270583

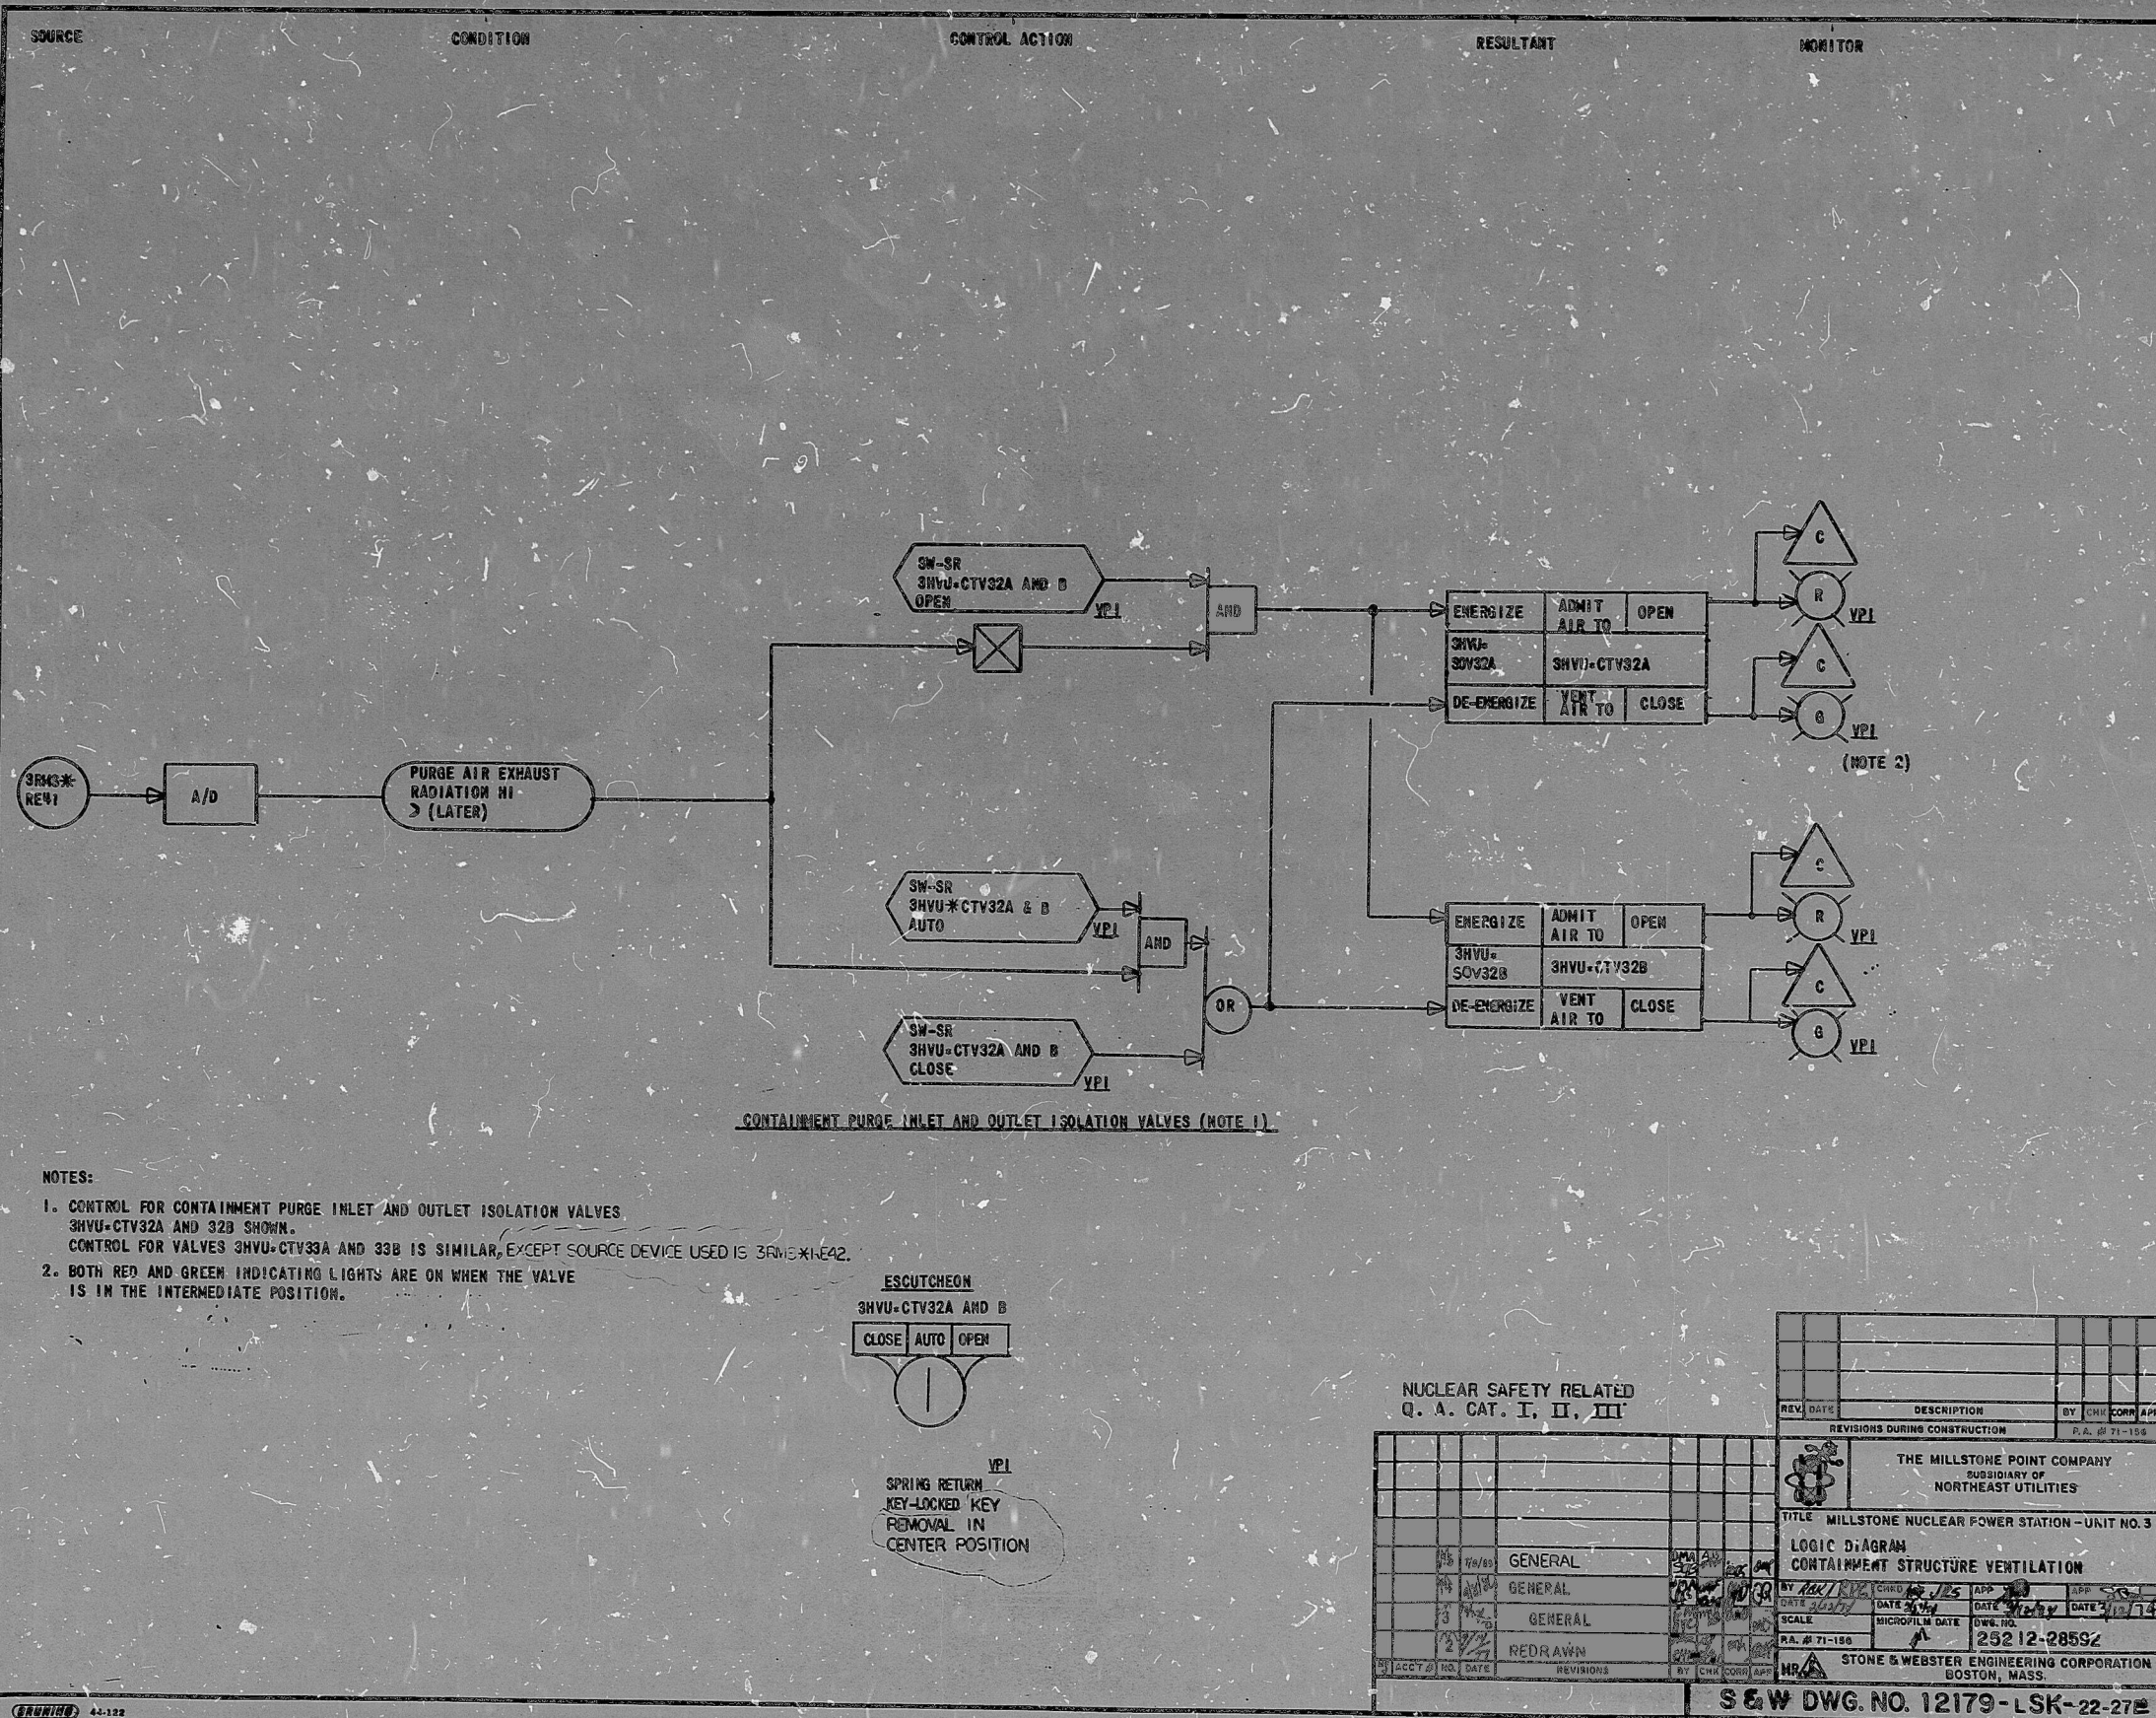