

"L1


"L1

"S8

8.5"

11"

17"

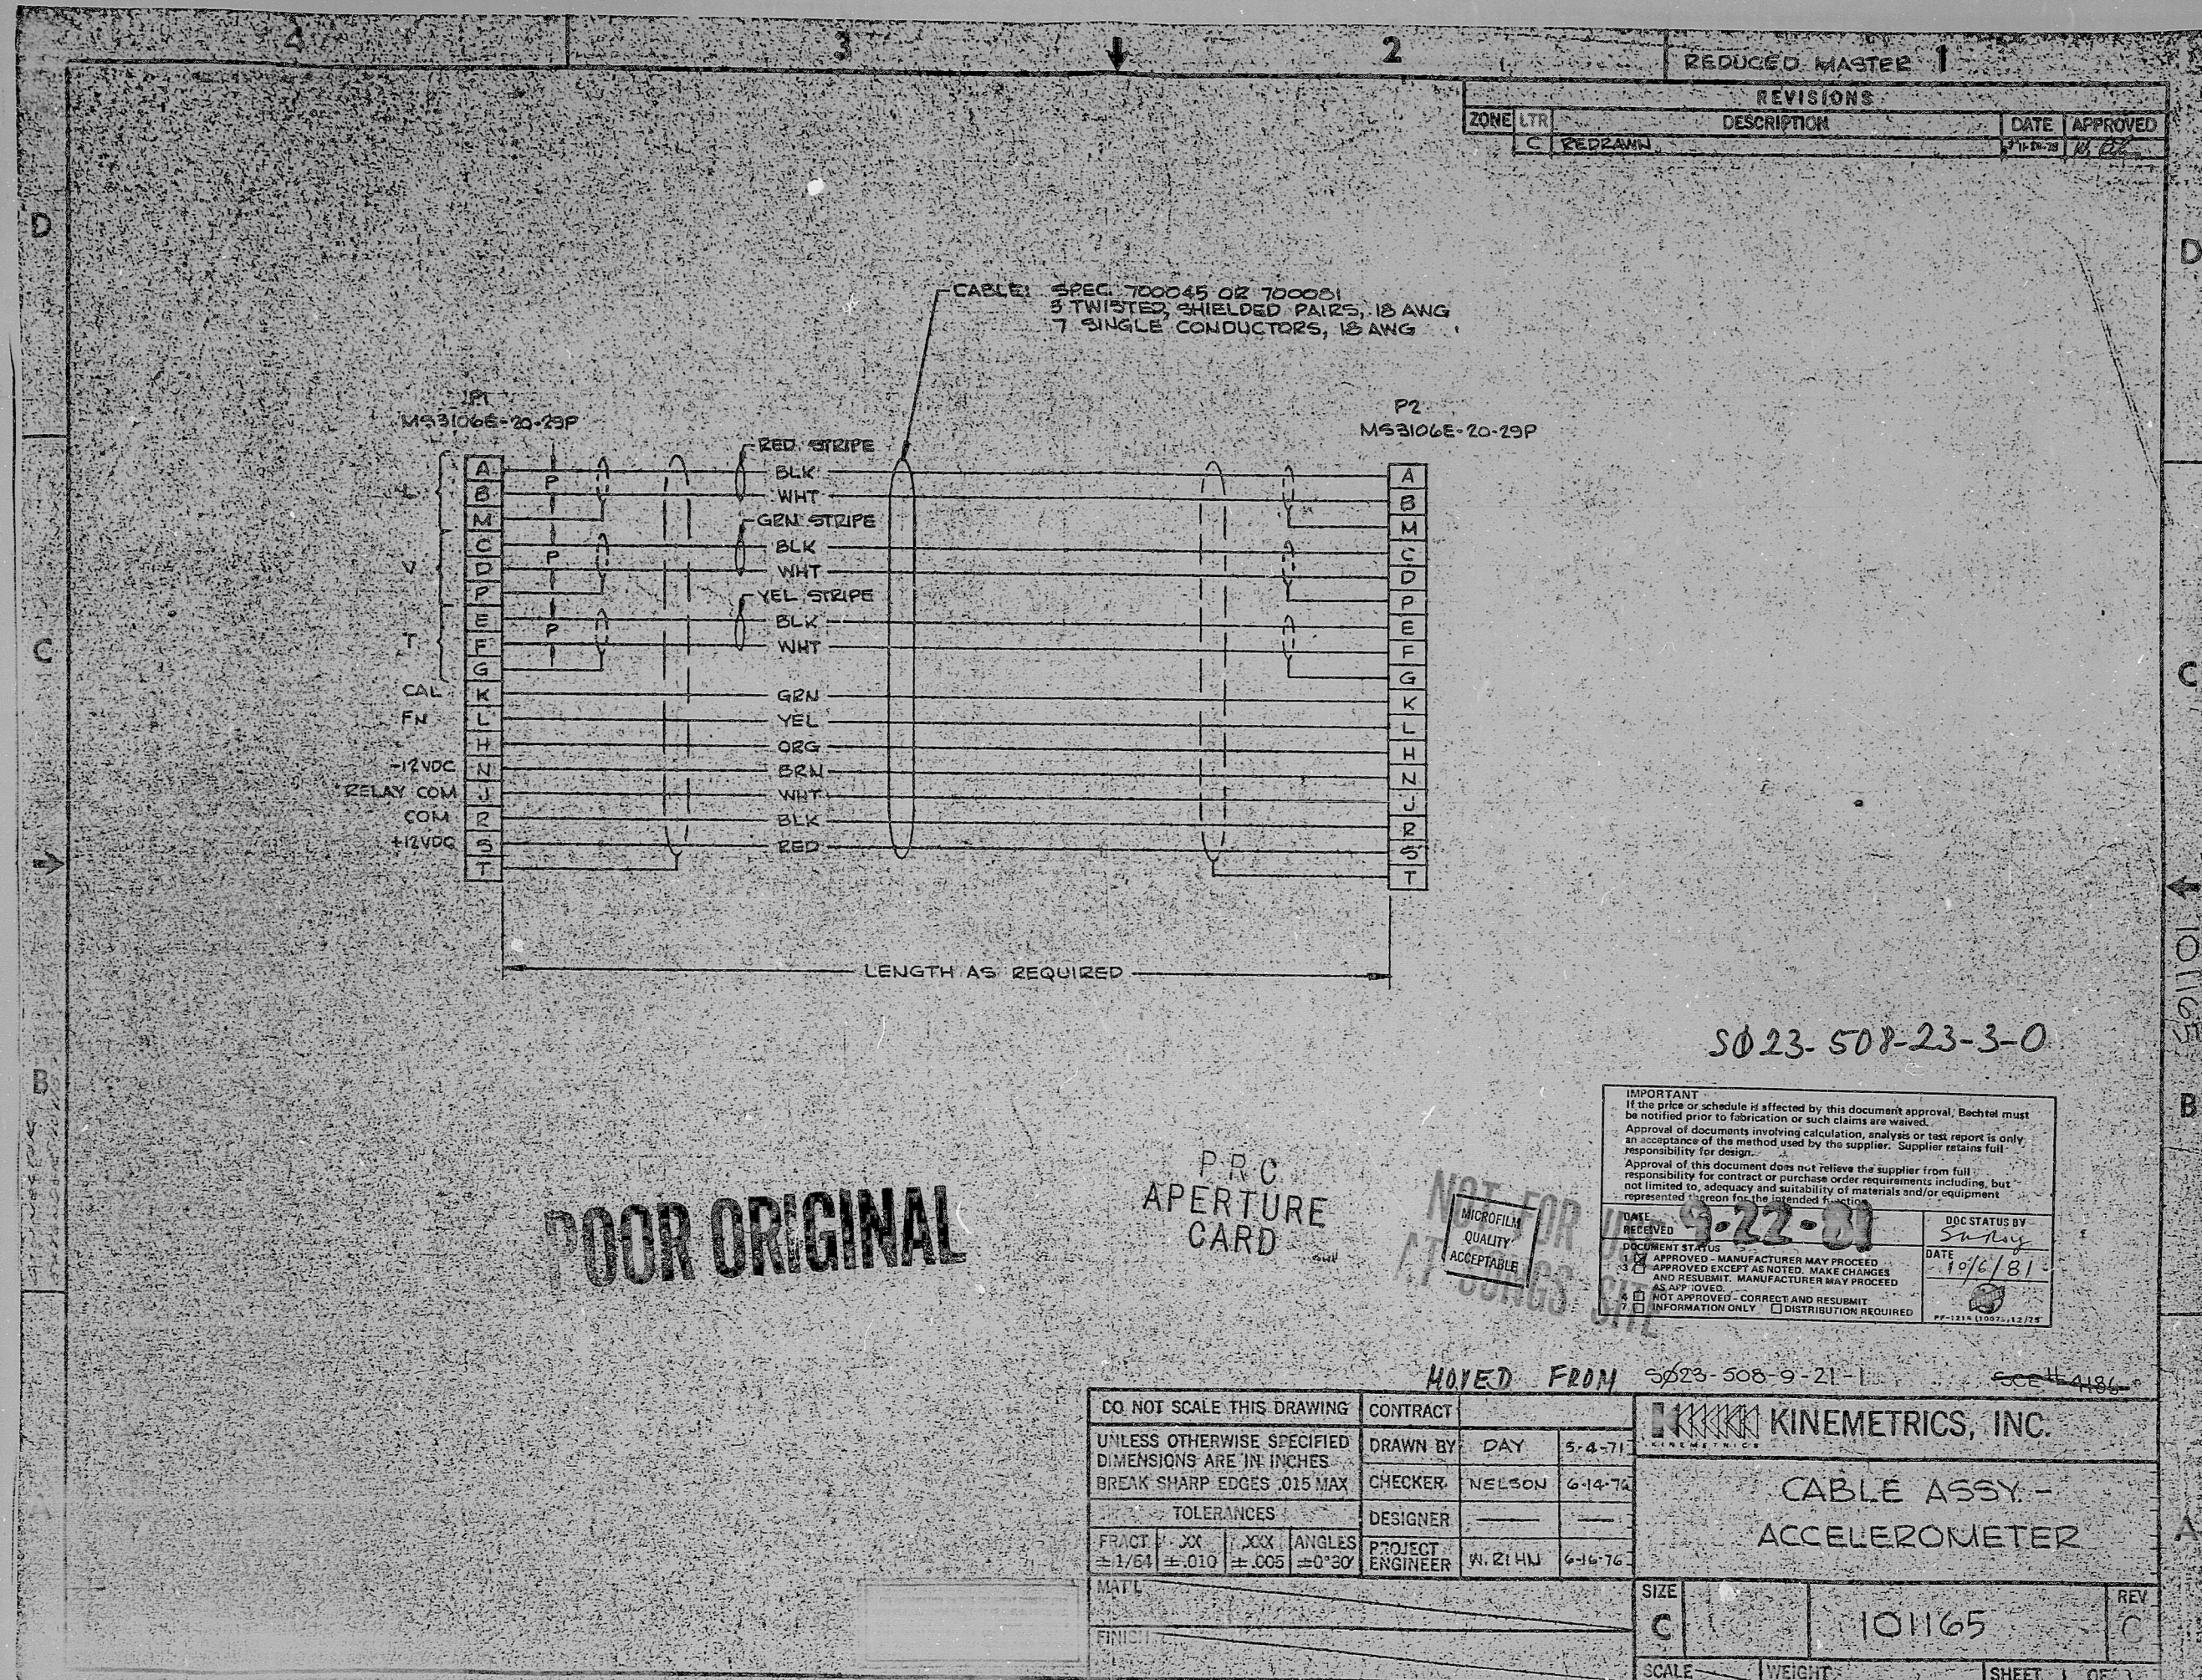

"L1

"S8

8.5"

11"

17"



RIDS

8204050325

