


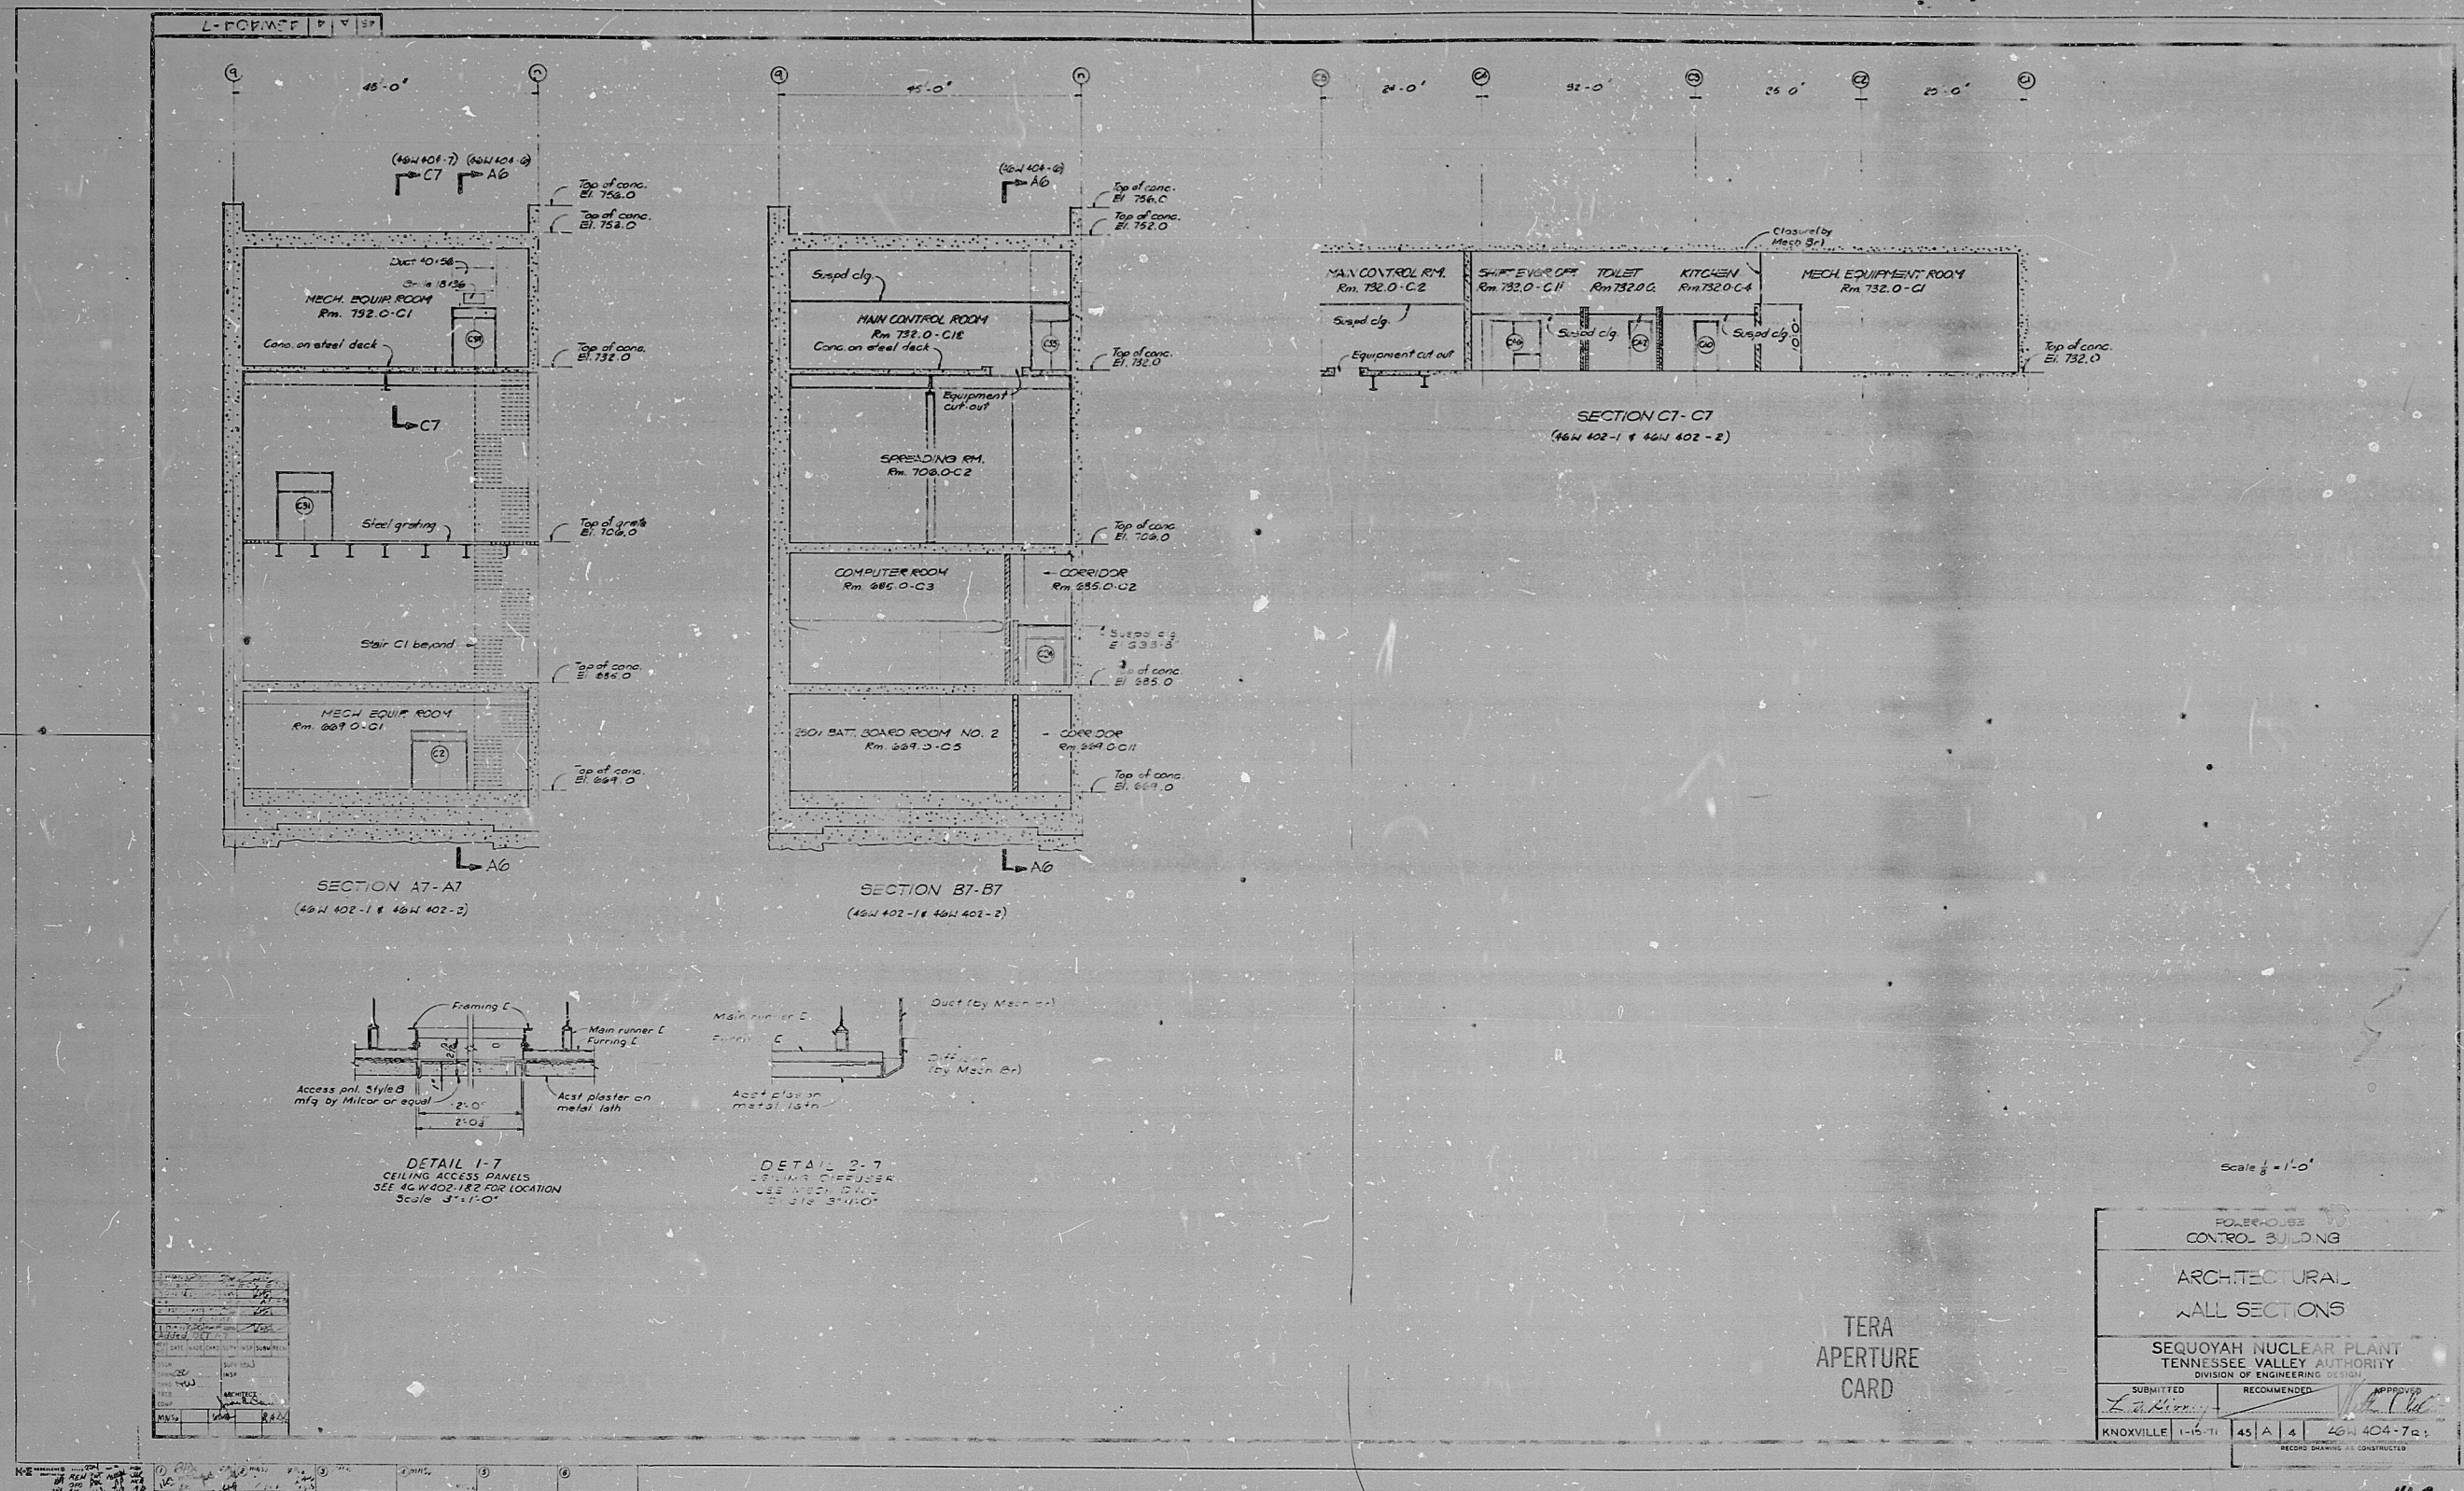

RDS-

8102040463

