


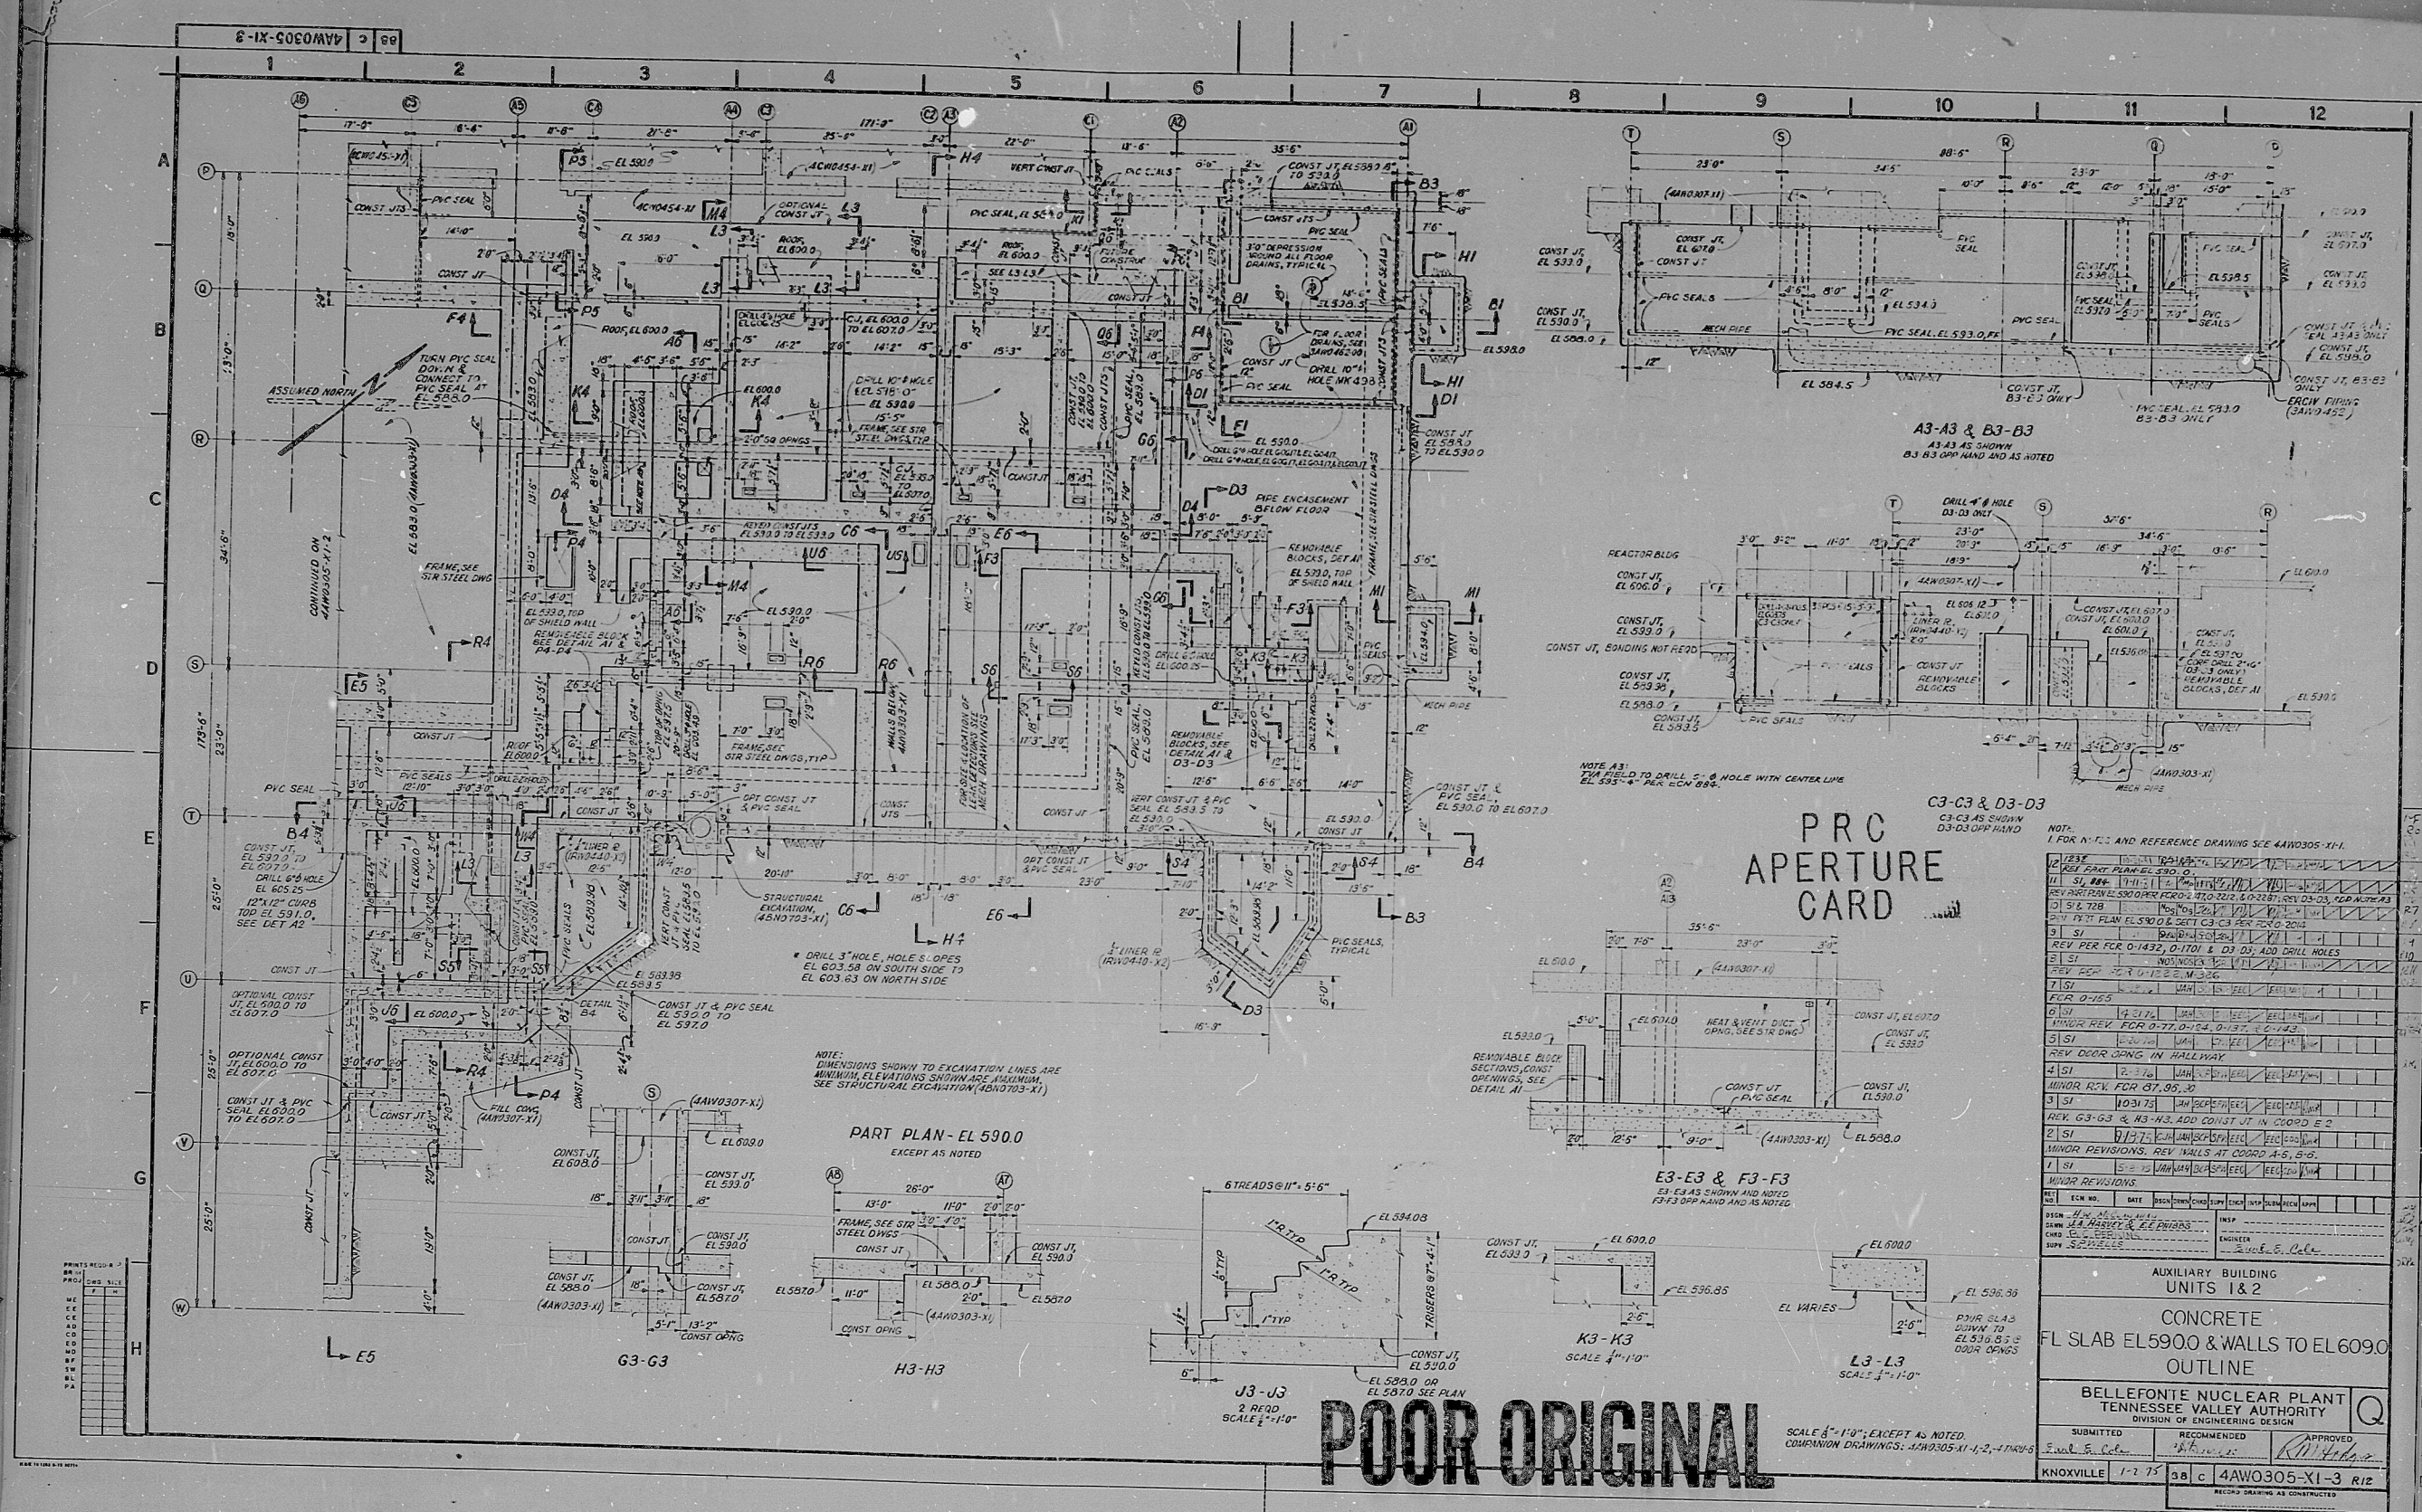

POOR ORIGINAL

AUXILIARY BUILDING UNITS 1 & 2	
CONCRETE FL SLAB EL 590.0 & WALLS TO EL 609.0 OUTLINE	
BELLEFONTE NUCLEAR PLANT	
TENNESSEE VALLEY AUTHORITY	
DIVISION OF ENGINEERING DESIGN	
SUBMITTED	RECOMMENDED
APPROVED	APPROVED
KNOXVILLE	1-7-75
44W0305-X1-3 R12	

RIDS

804070037

