


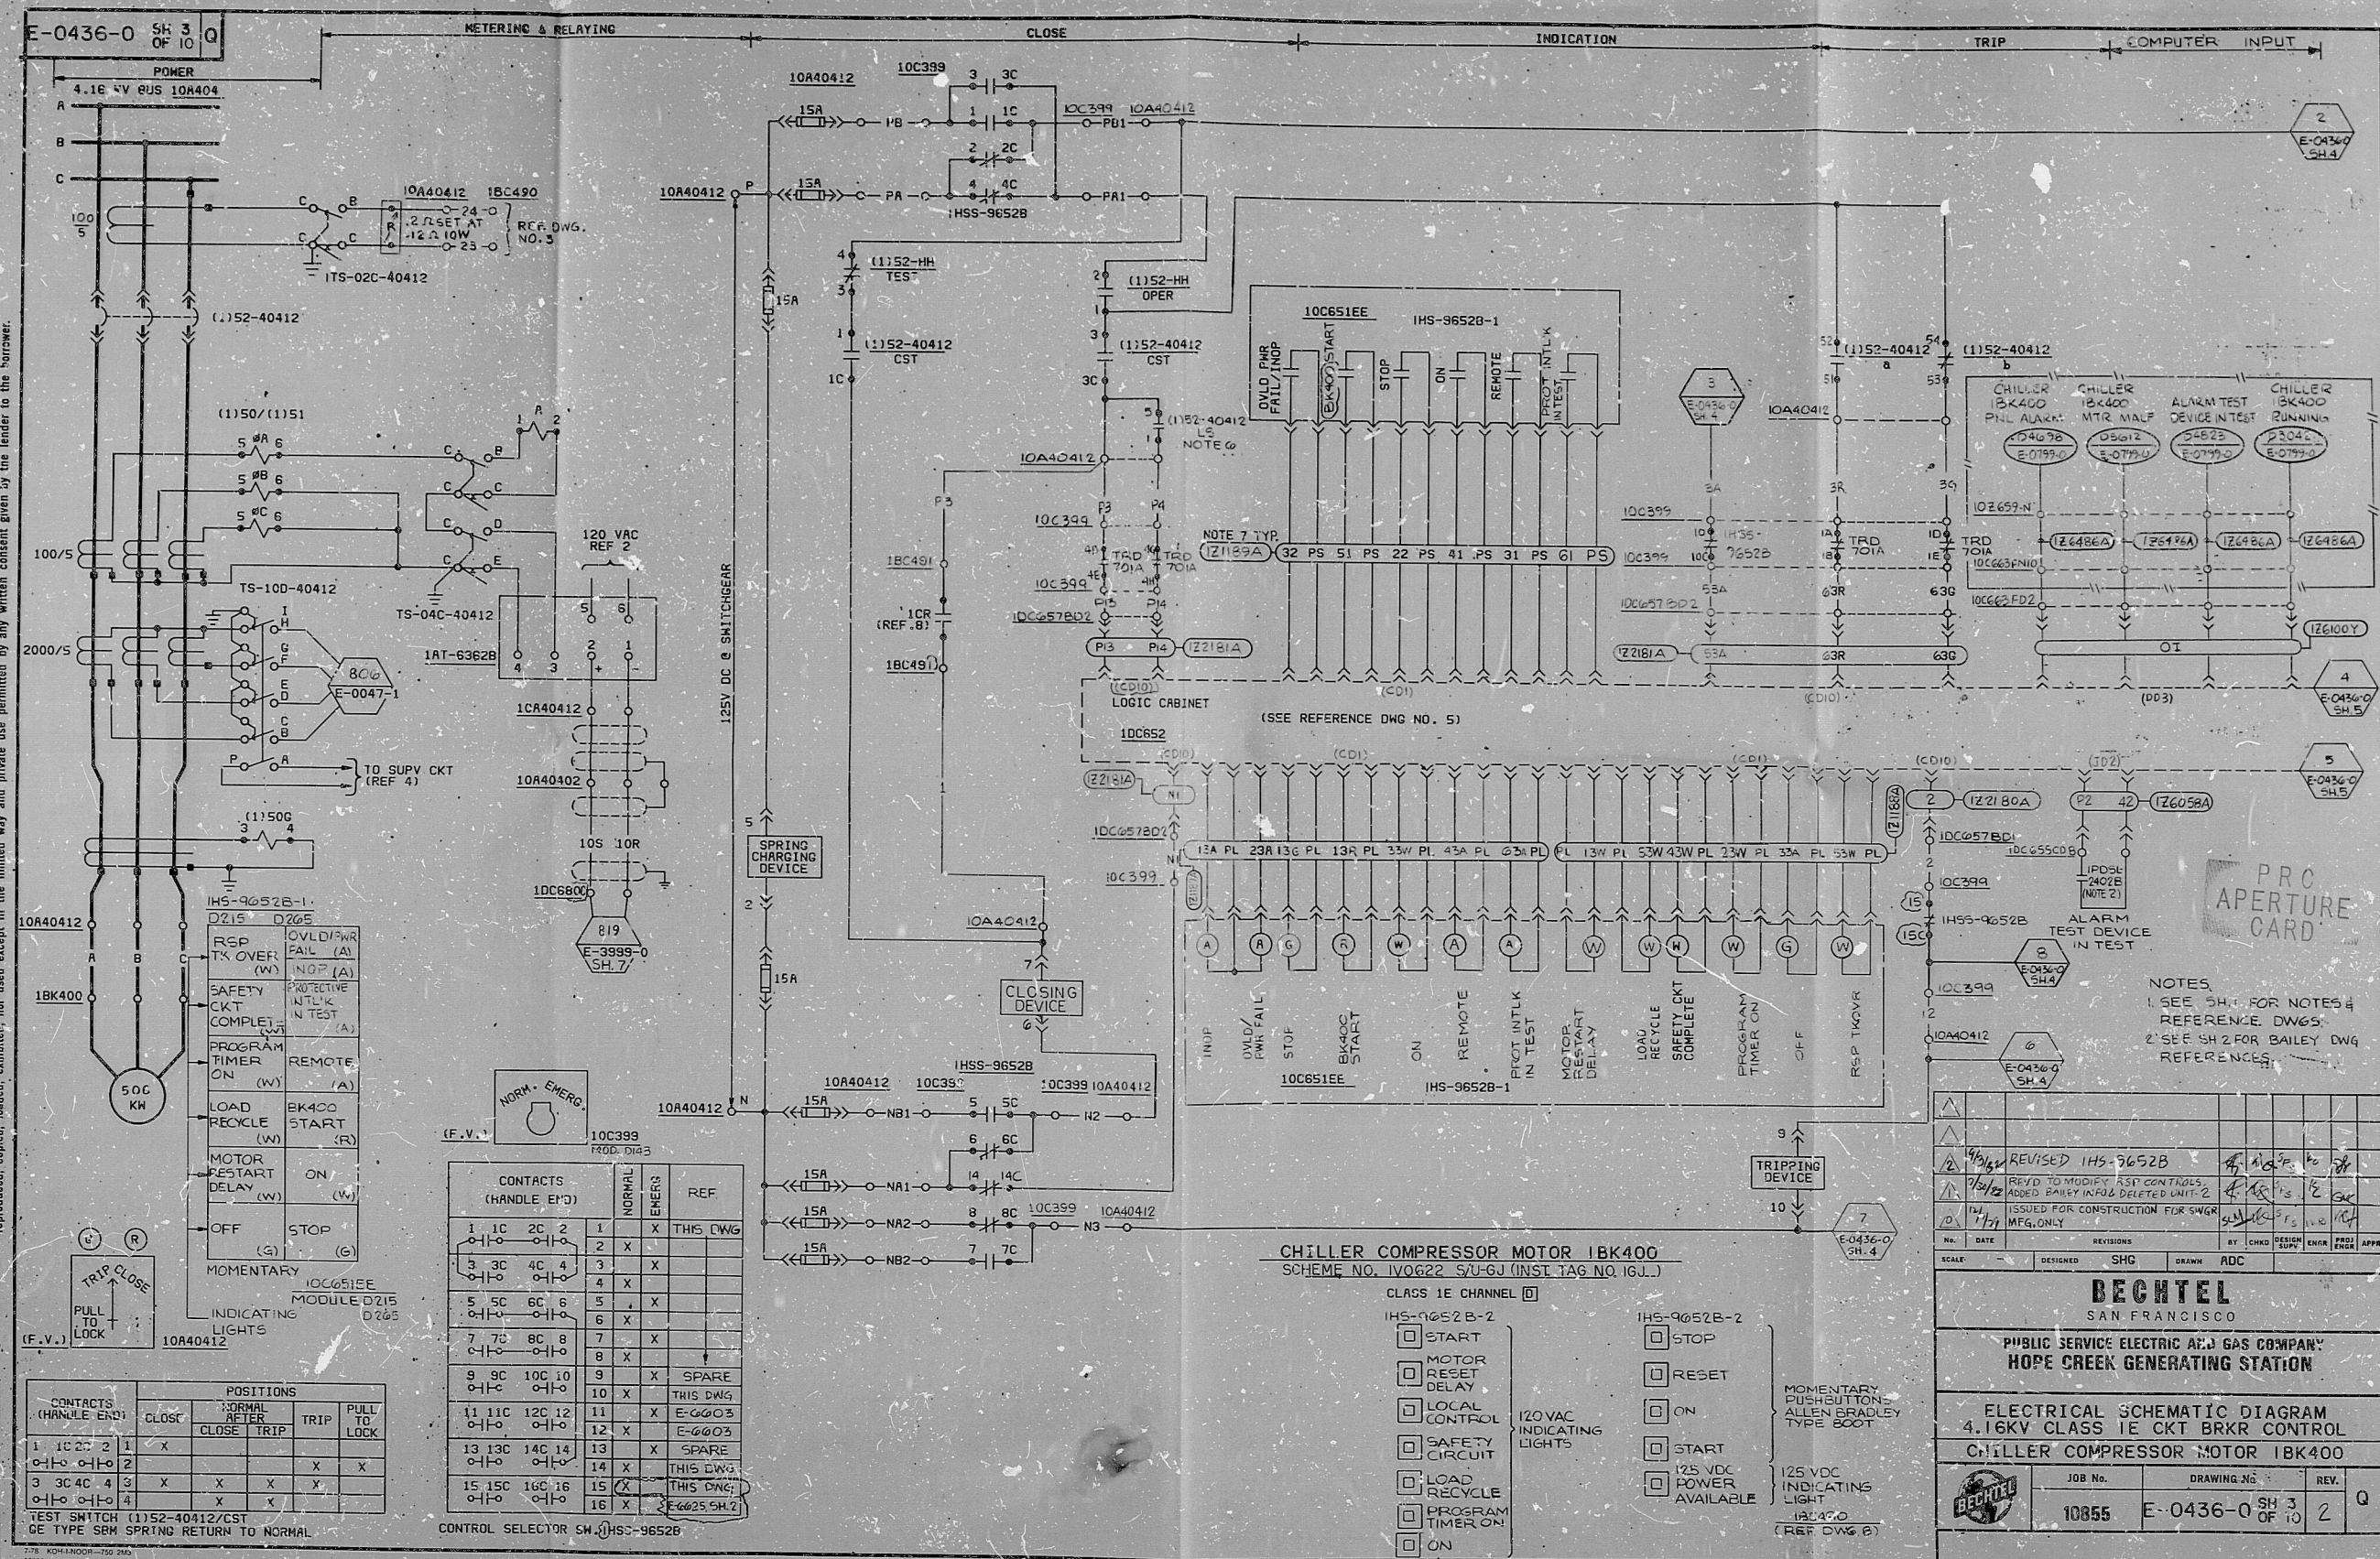

 BECHTEL SAN FRANCISCO			
PUBLIC SERVICE ELECTRIC AND GAS COMPANY HOPE CREEK GENERATING STATION			
ELECTRICAL SCHEMATIC DIAGRAM 4.16KV CLASS 1E CKT BRKR CONTROL CHILLER COMPRESSOR MOTOR 1BK400			
	JOB No.	DRAWING NO.	REV.
	10855	E-0436-Q	SH OF 3 OF 10
			2

RIDS

8308100500

