


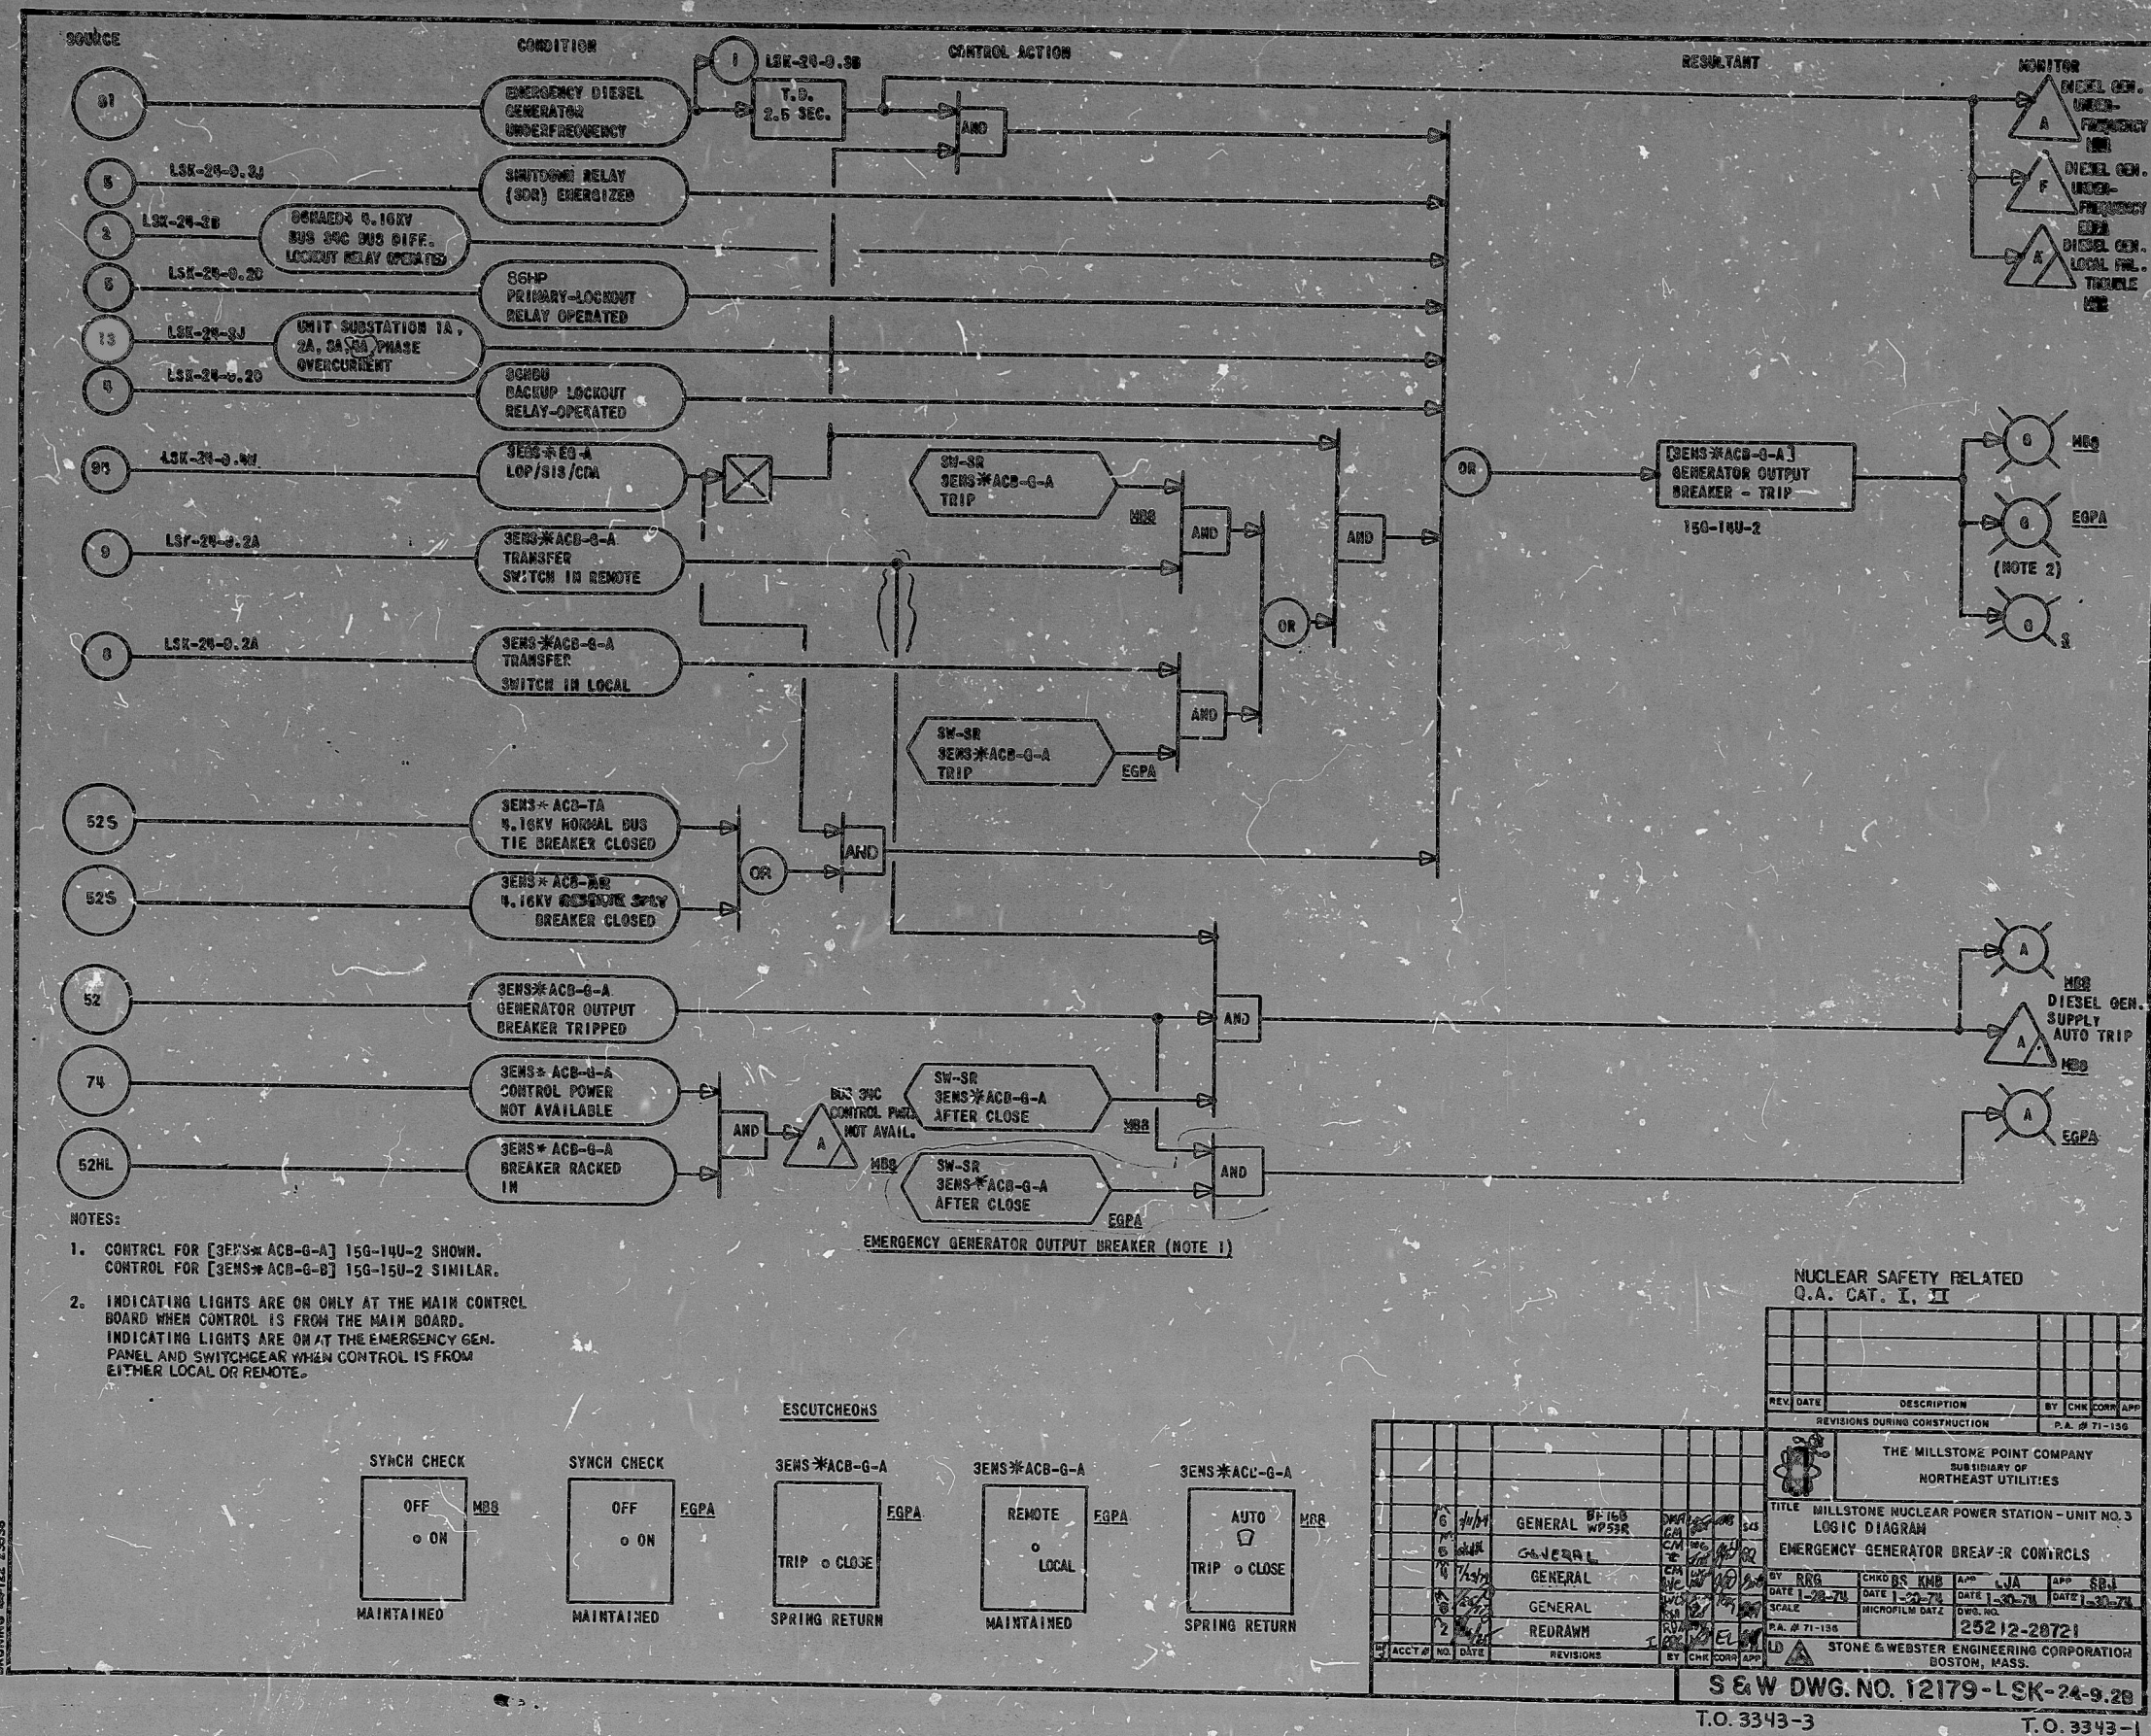

TI
APERTURE
CARD

PDR RIDS

8503280026

