


DEVICE	FUNCTION	WFR / TYPE	REMARKS
49X	AUX. RELAY	2180-ED1A	120V AC

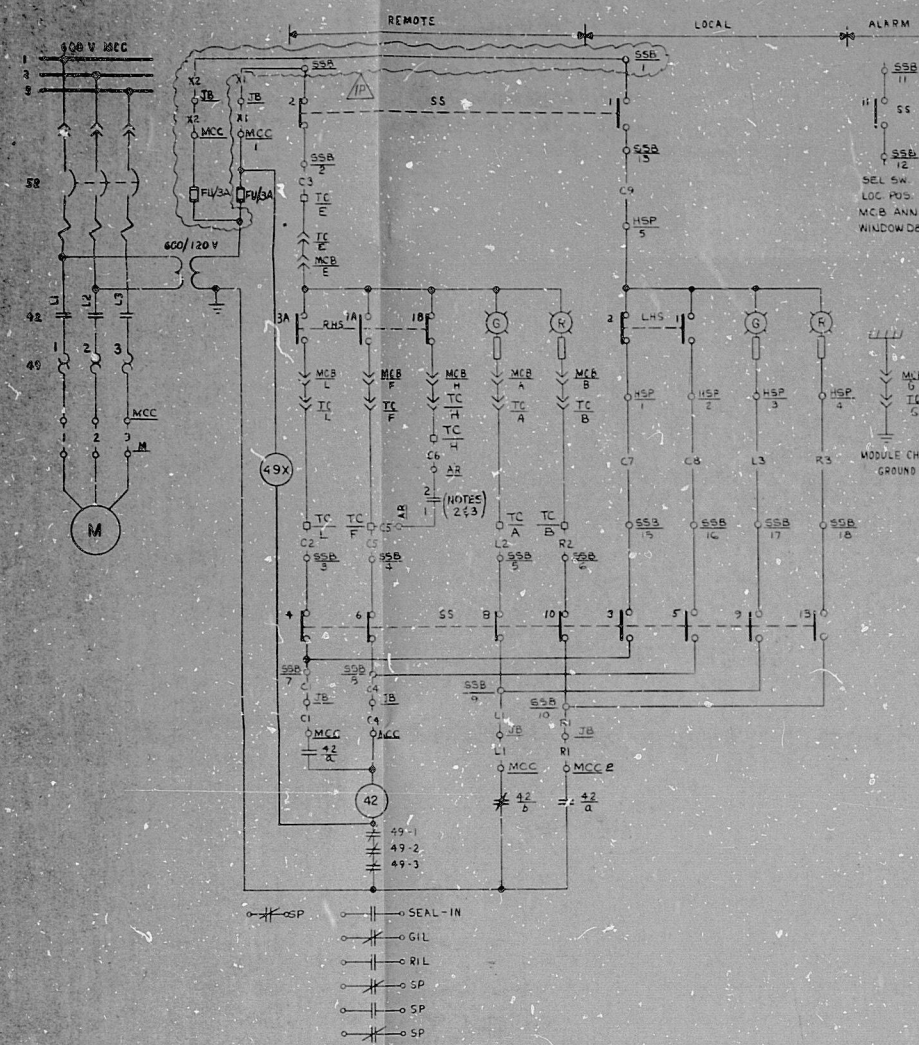


STOP	START	STOP	START	STOP	START
SP	SP	SP	SP	SP	SP

REMOTE HANDSWITCH
GEMCO CAT NA 406534222-Y-007-5M1-7-40
SPRING RETURN TO AUTO FROM START ONLY

LOCAL	REMOTE	STOP	START
SP	SP	SP	SP

SELECTOR SWITCH
GE 5BM TYPE MODEL 1-5
SIMILAR TO 10A0066
MAINTAINED POSITION
OVAL HANDLE

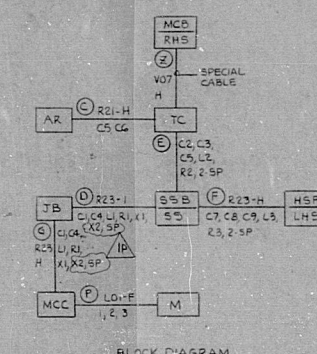

- NOTES
- FOR MOTOR AND STARTER SIZE SEE DWG. B-7556 SHEETS 1 AND 4.
 - FOR RELAY CONTACT SEE TABLE
 - FOR PUMP 1A - SEE DWG. D-207097
FOR PUMP 1B - SEE DWG. D-207098

REFERENCE DRAWINGS
A-177538 - ELECTRICAL GENERAL DETAILS AND NOTES

			MCB	M	TC	MCB	HSP	PHS	AR			HS	SE	SDB	TB	
SERVICE	FAC	SCHEME	MCC CUB/FILE	MOTOR	TERMINATION CABINET	MAIN CONTROL BOARD	LOCAL HOT SHUTDOWN PNL	REMOTE HANDSWITCH	AUXILIARY RELAY RACK	START-UP NUMBER	DRAWING-SSI ACCESS N	RELAY CONT & AR TERM. N	LOCAL HANDSWITCH	SELECTOR SWITCH	SELECTOR SWITCH BOX	JUNCTION BOX
BORIC ACID TRANSFER PUMP MOTOR	2B	2V	8FB-24	FB-24	Q2E21M005B-5	Q2E25L027-B	Q2E21H4B	Q2E21H500M-5	Q2E21H500M-5	40	U-20706-B	AR-2-1-M005B-5 T200-2 1 1 T200-11	Q2E21-H500M-5	Q2E21-H500M-5	Q2E21-H500M-5	BUT000B

SERVICE	TC	TERMINAL	NUMBERS	1	2	3	4	5	6	7	8	9	10	11	12	13	14	15	16	17	18	19	20
BORIC ACID TRANSFER PUMP MOTOR	B	3TB2-7	3TB2-8	3TB2-9	3TB2-10	3TB2-11	3TB2-12	TA-44	TA-45	TA-46	TA-47	TA-48	TA-49	TA-50	TA-51	TA-52	TA-53	TA-54	TA-55	TA-56	TA-57	TA-58	TA-59

PRELIMINARY

TERA APERTURE CARD

BECHTEL CORPORATION
JOB 7597-20
SOUTHERN SERVICES INC.
FOR
ALABAMA POWER COMPANY
JOB JOSEPH M. FARLEY NUCLEAR PLANT UNIT NO. 2
DETAIL ELEMENTARY DIAGRAM
BORIC ACID TRANSFER PUMPS 2A & 2B
SCALE NONE
SHEET 2 OF 2 SHEETS
D-207224
REV 1P

PIDS-PDR

8/02/00307

