


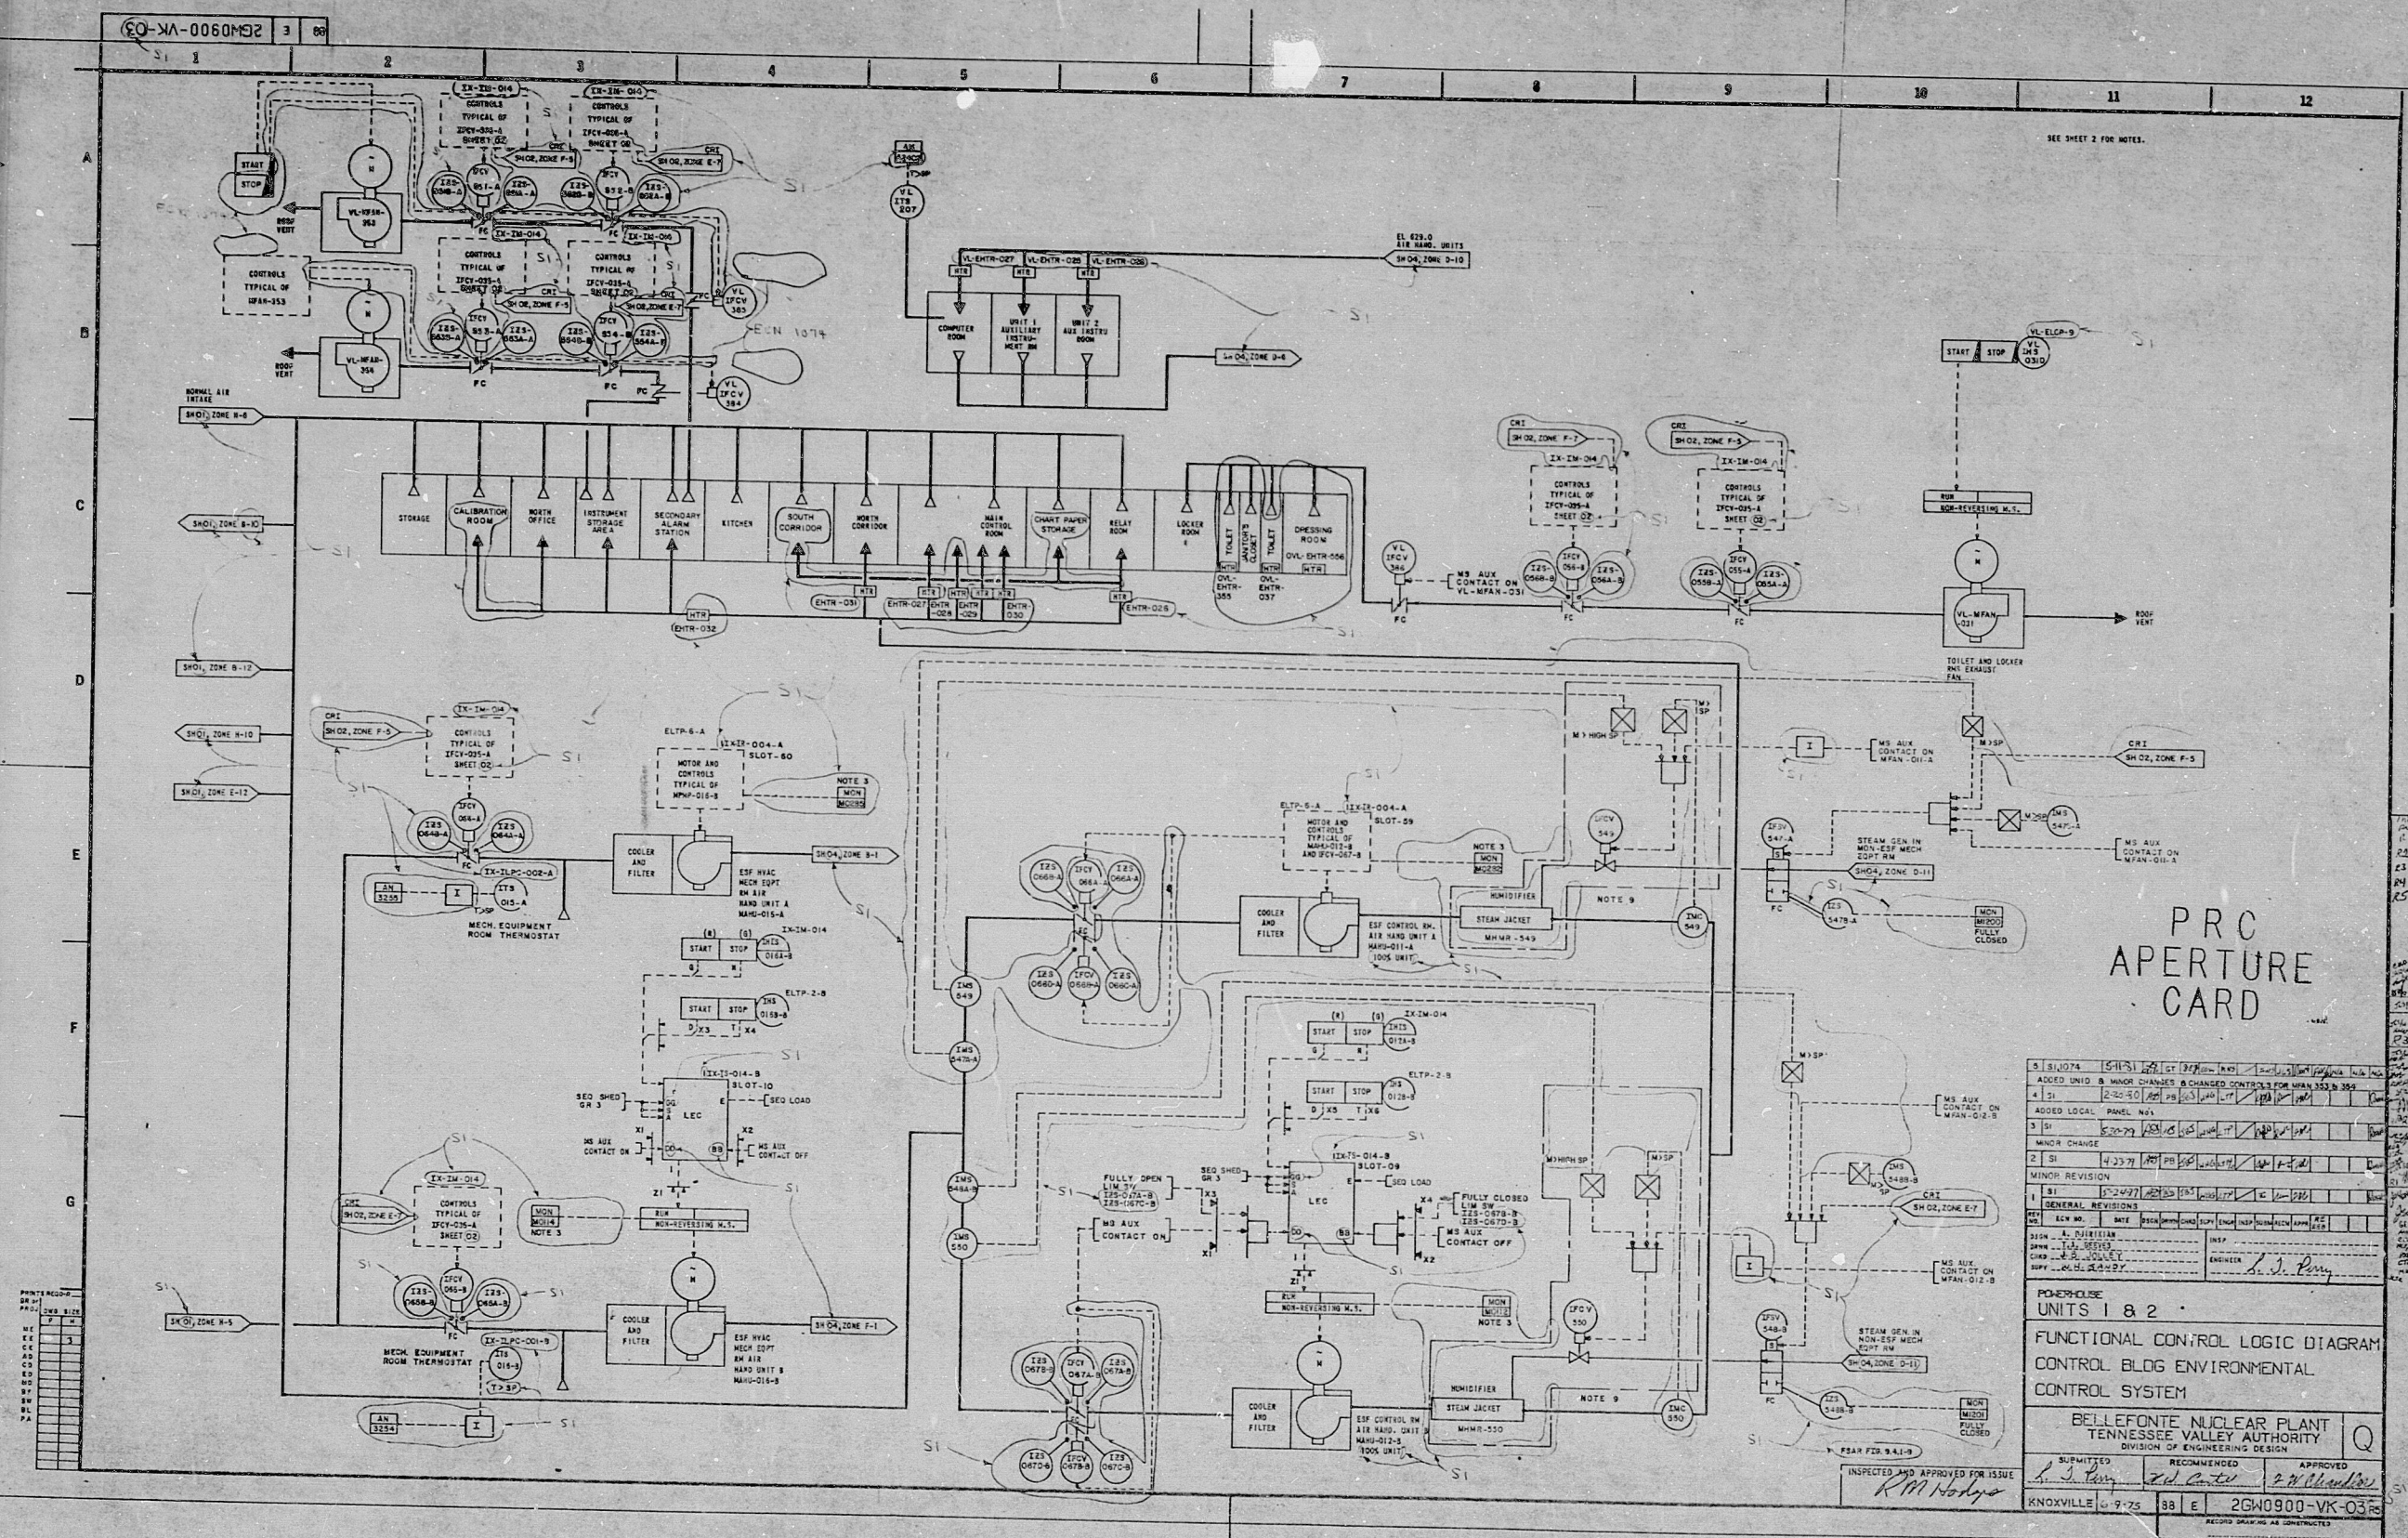

R125

804070196

