


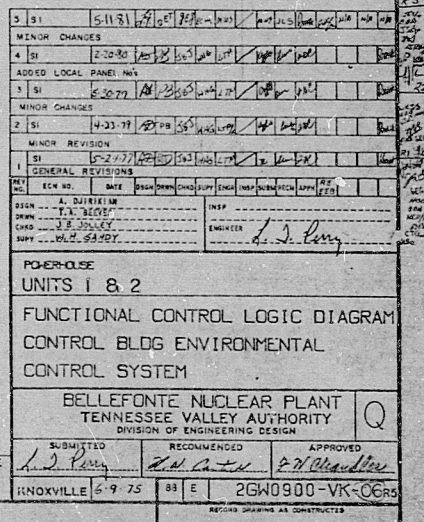

RIDS

8204070203

