


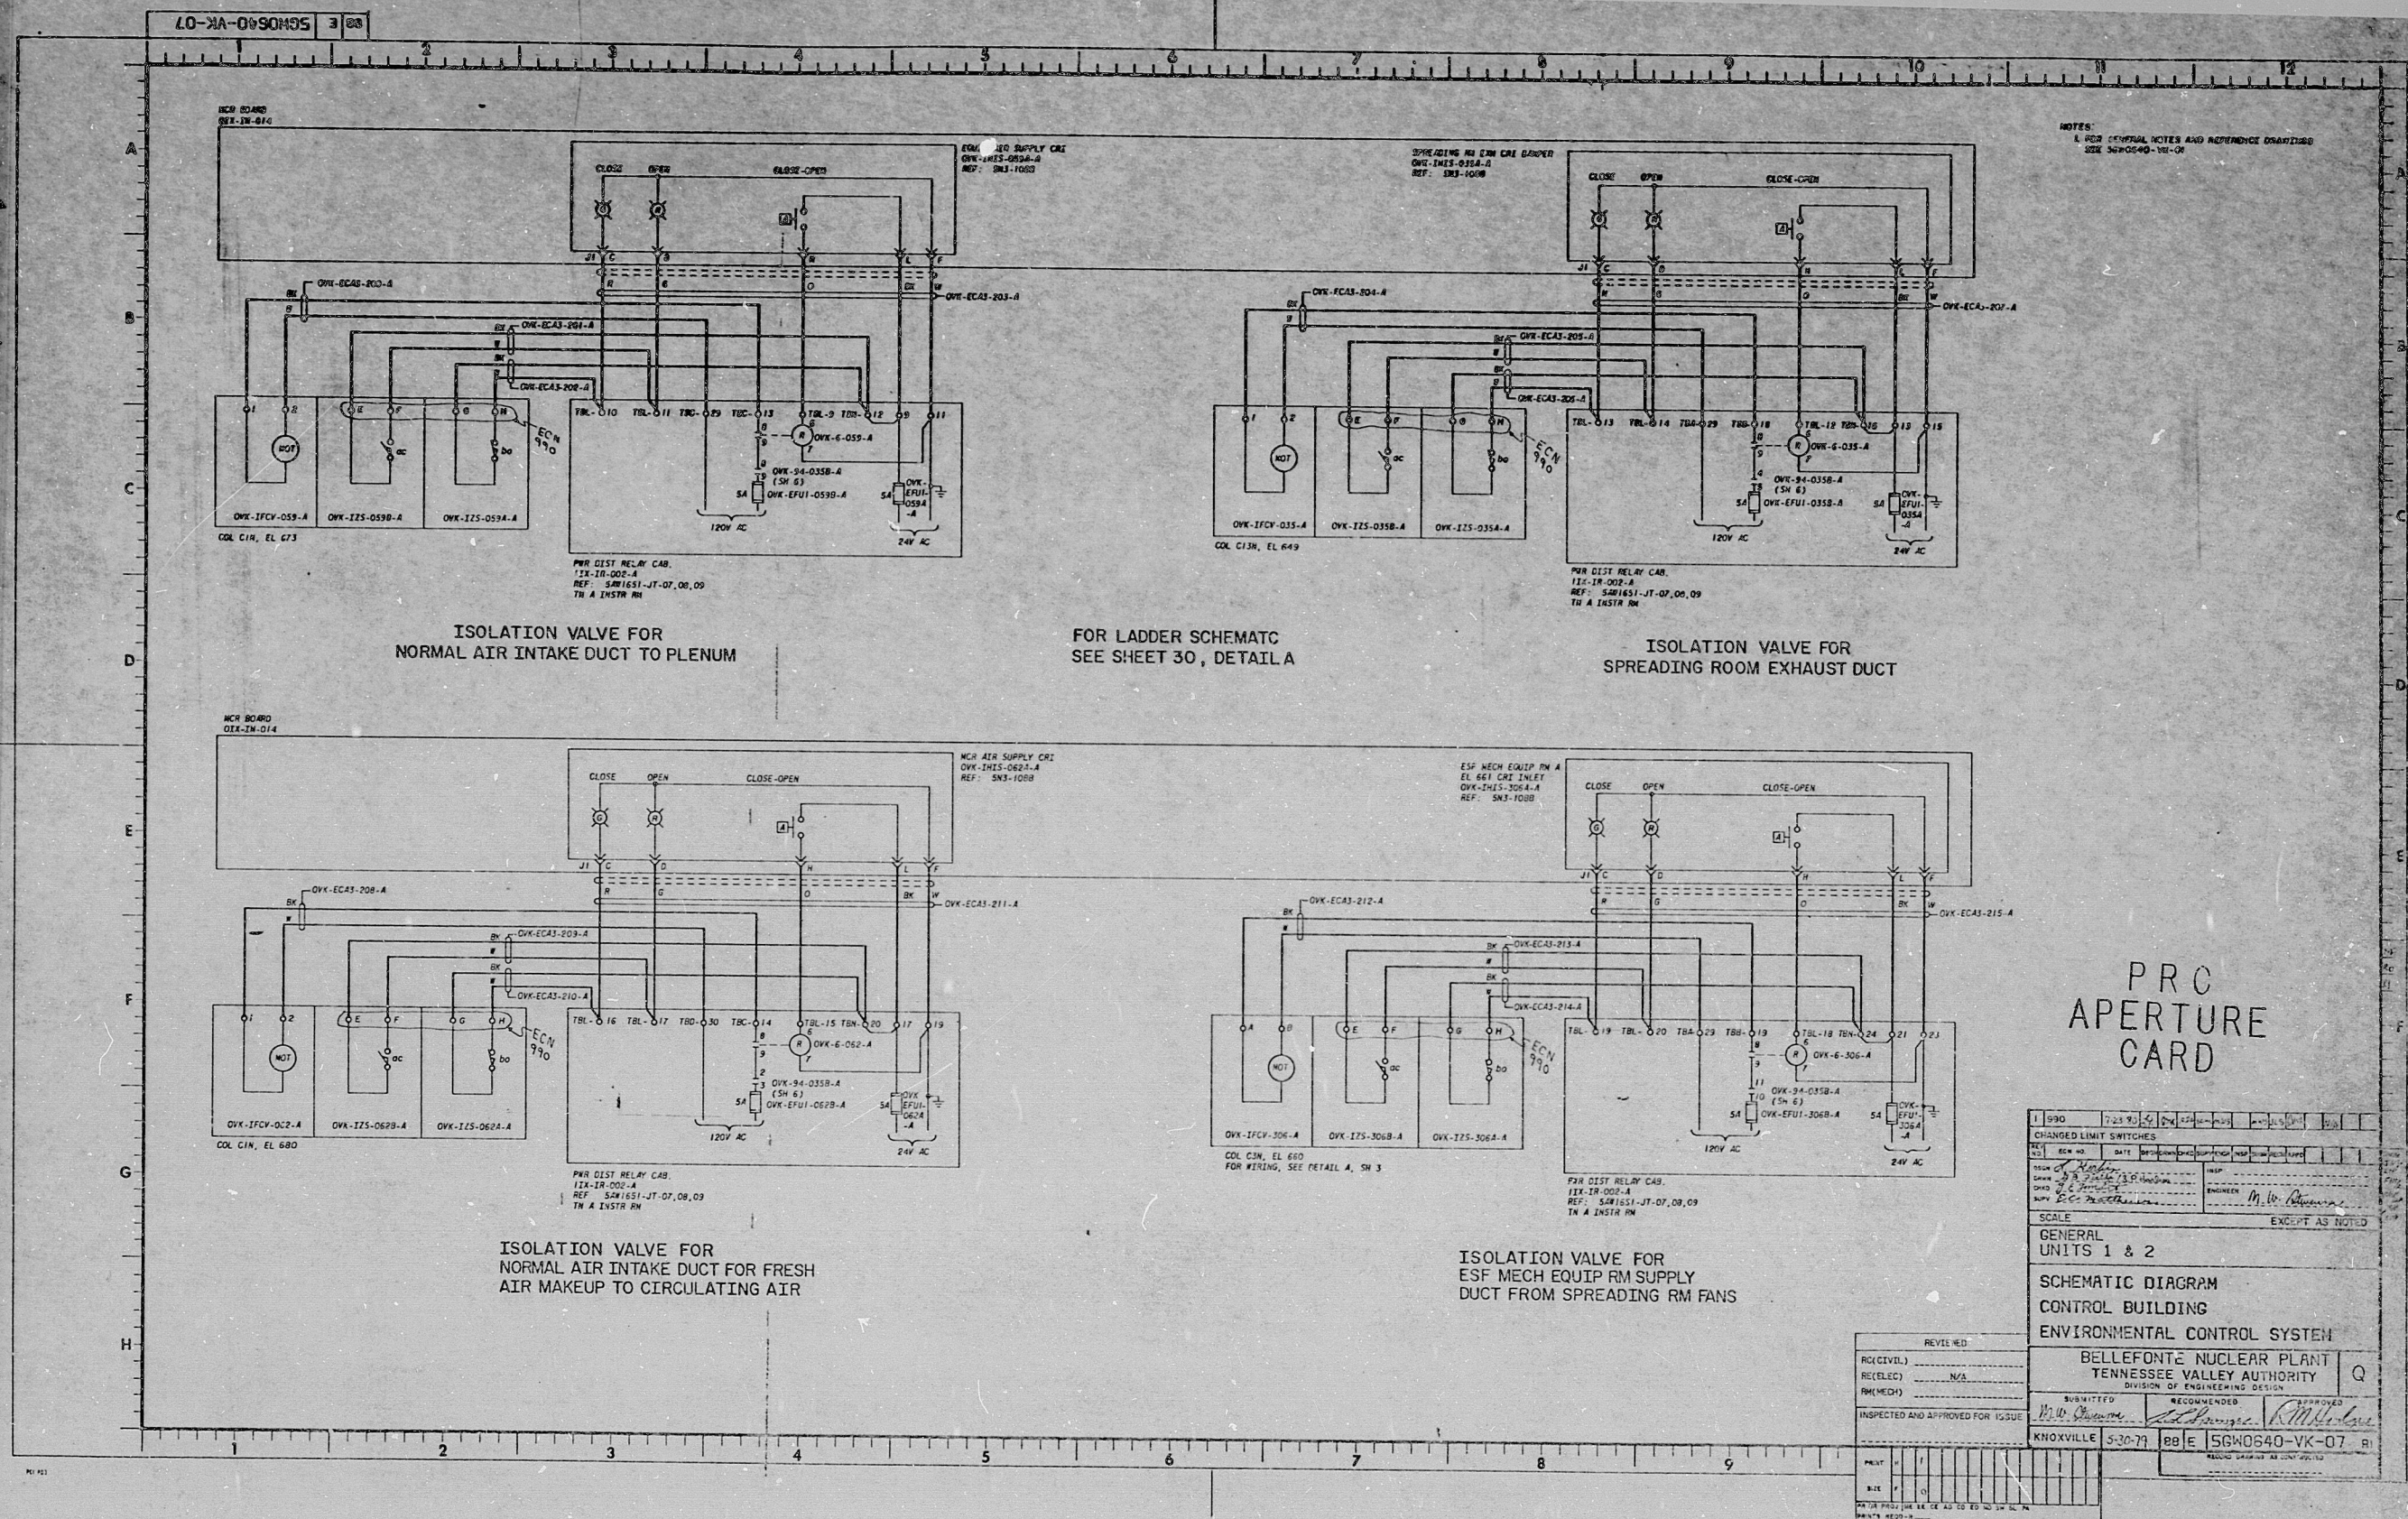

Rips

8204070222

