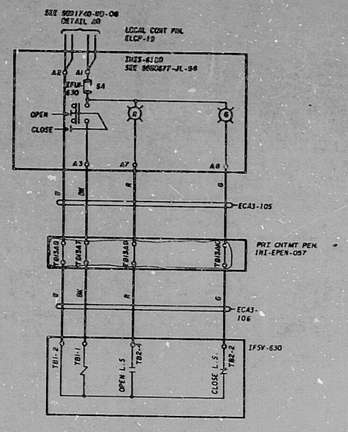

RC PMP MOT OIL DR TK 623
WATER SUP FSV, IFSV-630

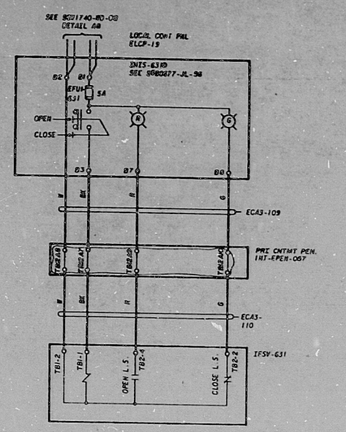

RC PMP MOT OIL DR TK 624
WATER SUP FSV, IFSV-631

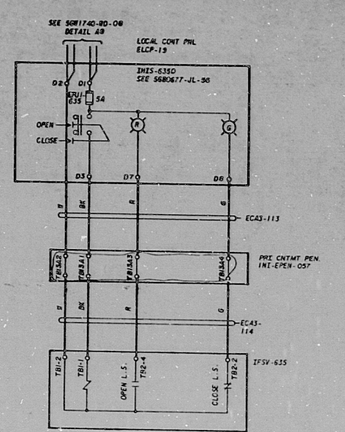

RC PMP MOT OIL DR TK 623
DRAIN FSV, IFSV-635

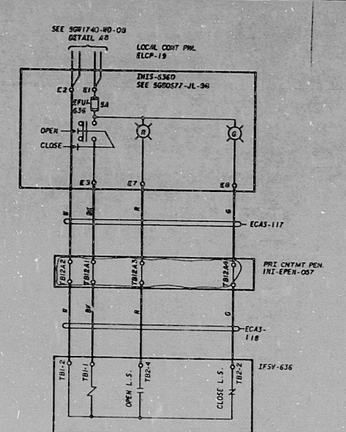

RC PMP MOT OIL DR TK 624
DRAIN FSV, IFSV-636

NOTES:
1. FOR GENERAL NOTES AND SYMBOLS, SEE SGW1740-WD-01.

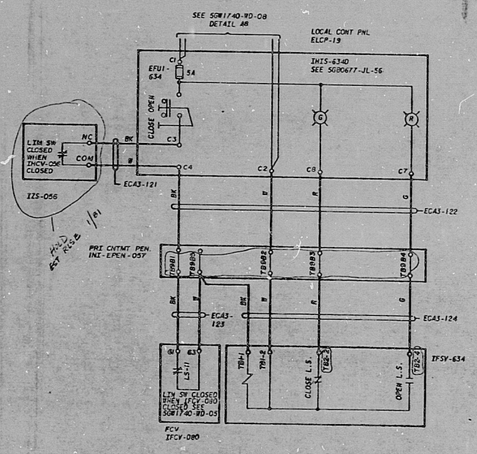

RC PMP MOT OIL DR TK 623
OIL DISCHG FSV, IFSV-634

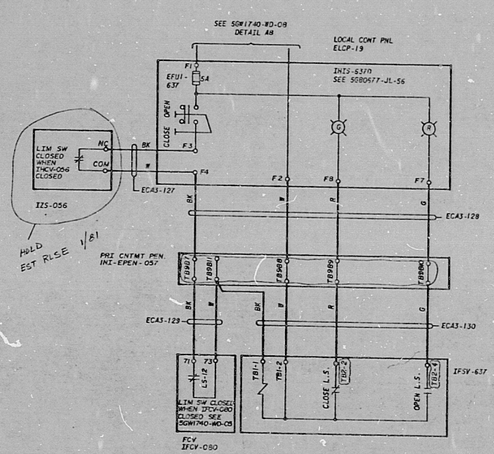

RC PMP MOT OIL DR TK 624
OIL DISHG FSV, IFSV-637

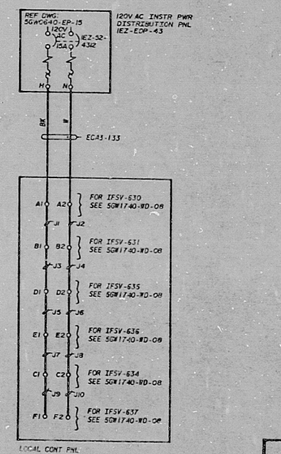

DETAIL AB

PRC APERTURE CARD

NO.	ECN NO.	DATE	DRAWN	CHKD	DSGN	PROJ	SUPV	APPD	ENGR	INSP
3	51	7-7-80								
CHANGED VARIOUS TERM. NO., REMOVED EL.& COIL AND MADE REVISED CHANGES										
2	51	5-1-79								
ADDED VARIOUS TERMINAL NO.										
1	51	1-31-79								
ADDED VARIOUS TERMINAL NO.										

DRAWN R.D.Miller
DESIGN R.C.Mowbray
CHKD R.C.Mowbray
SUPV D.C.Mowbray
ENGR W.L.Abbey Jr.

GENERAL
UNIT 1

SYSTEM SCHEMATIC
WASTE DISPOSAL SYSTEM

BELLEFONTE NUCLEAR PLANT
TENNESSEE VALLEY AUTHORITY
DIVISION OF ENGINEERING DESIGN

REVIEWED	
NDQCV(L)	N/A
PEB(ELEC)	N/A
PAL(MECH)	N/A

INSPECTED AND APPROVED FOR ISSUE
DESIGN PROJECT MANAGER

SUBMITTED	RECOMMENDED	APPROVED
D.L.Gibbs	L.T.Spangler	R.M.Hodges
KNOXVILLE 8-7-72	88 E 5GW1740-WD-08 R3	

RECORD DRAWING AS CONSTRUCTED

PRINTS NEED B... SIZE
PROJ DWG SIZE
F B
INI EPEN
EX EPEN
ES EPEN
EG EPEN
HO EPEN
EV EPEN
SW EPEN
WL EPEN
PA EPEN

RIDS

8204070339

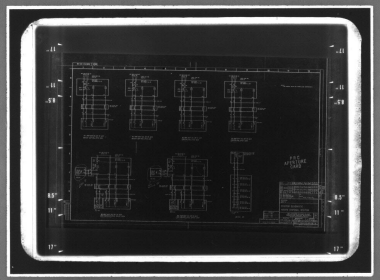

M*M 5824 — FILMSORT® Brand Aperture & Camera Cards and DUPLICARD® Brand Copy Cards — Product of 3M Company, St. Paul, Minn.