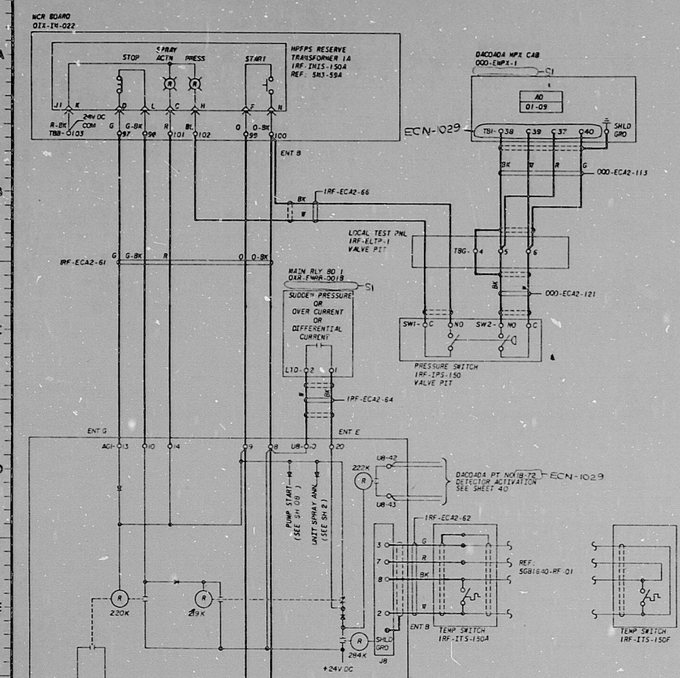

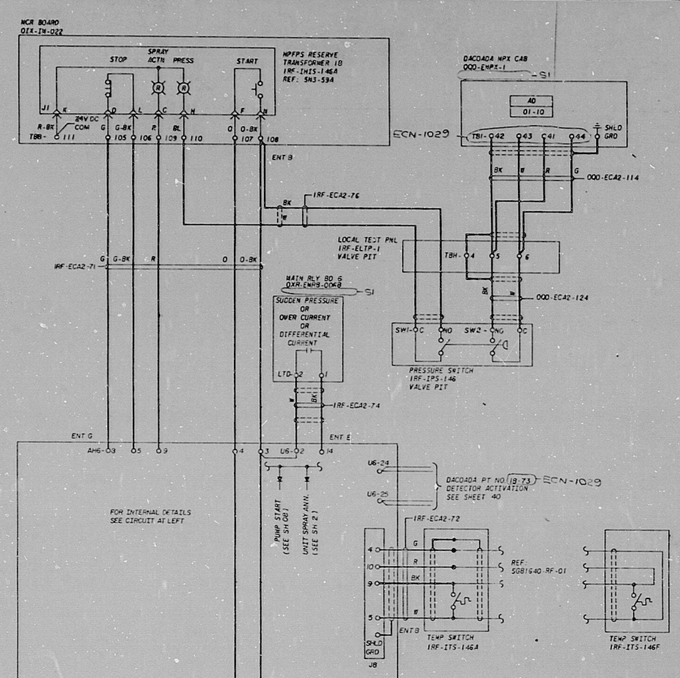

NOTES:
1. FOR GENERAL NOTES AND REFERENCE DRAWINGS SEE 5GW0640-RF-01.

PRC APERTURE CARD

NO	ECN NO.	DATE	DSN	DRWN	CHKD	SUPV	ENGR	SUP
2	1019	12-6-79						
CHANGED DACOADA PT. NO. & TERM. & MINOR CHANGES.								
1	SI	11-21-79						
CHANGE DET & SOIL TERMINATION & MINOR CHANGES.								

SCALE: EXCEPT AS NOTED

GENERAL
UNITS 1 & 2

SCHEMATIC DIAGRAM
HP FIRE PROTECTION SYSTEM

REVIEWED
RC (CIVIL) N/A
RE (ELEC) N/A
RM (MECH)
INSPECTED AND APPROVED FOR ISSUE

BELLEFONTE NUCLEAR PLANT
TENNESSEE VALLEY AUTHORITY
DIVISION OF ENGINEERING DESIGN
Q

SUBMITTED	RECOMMENDED	APPROVED
D.W. Stevens	J.T. Spencer	R.M. Hodges
KNOXVILLE 9-9-79	88 E 5GW0640-RF-15 R2	

RECORD DRAWING AS CONSTRUCTED

RIDS

8204070378

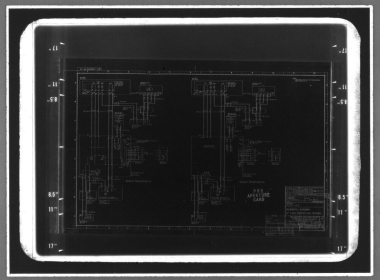

M*M 5824 — FILMSORT* Brand Aperture & Camera Cards and DUPLICARD* Brand Copy Cards — Product of 3M Company, St. Paul, Minn.