


M-221  
SHEET 1  
OF 2

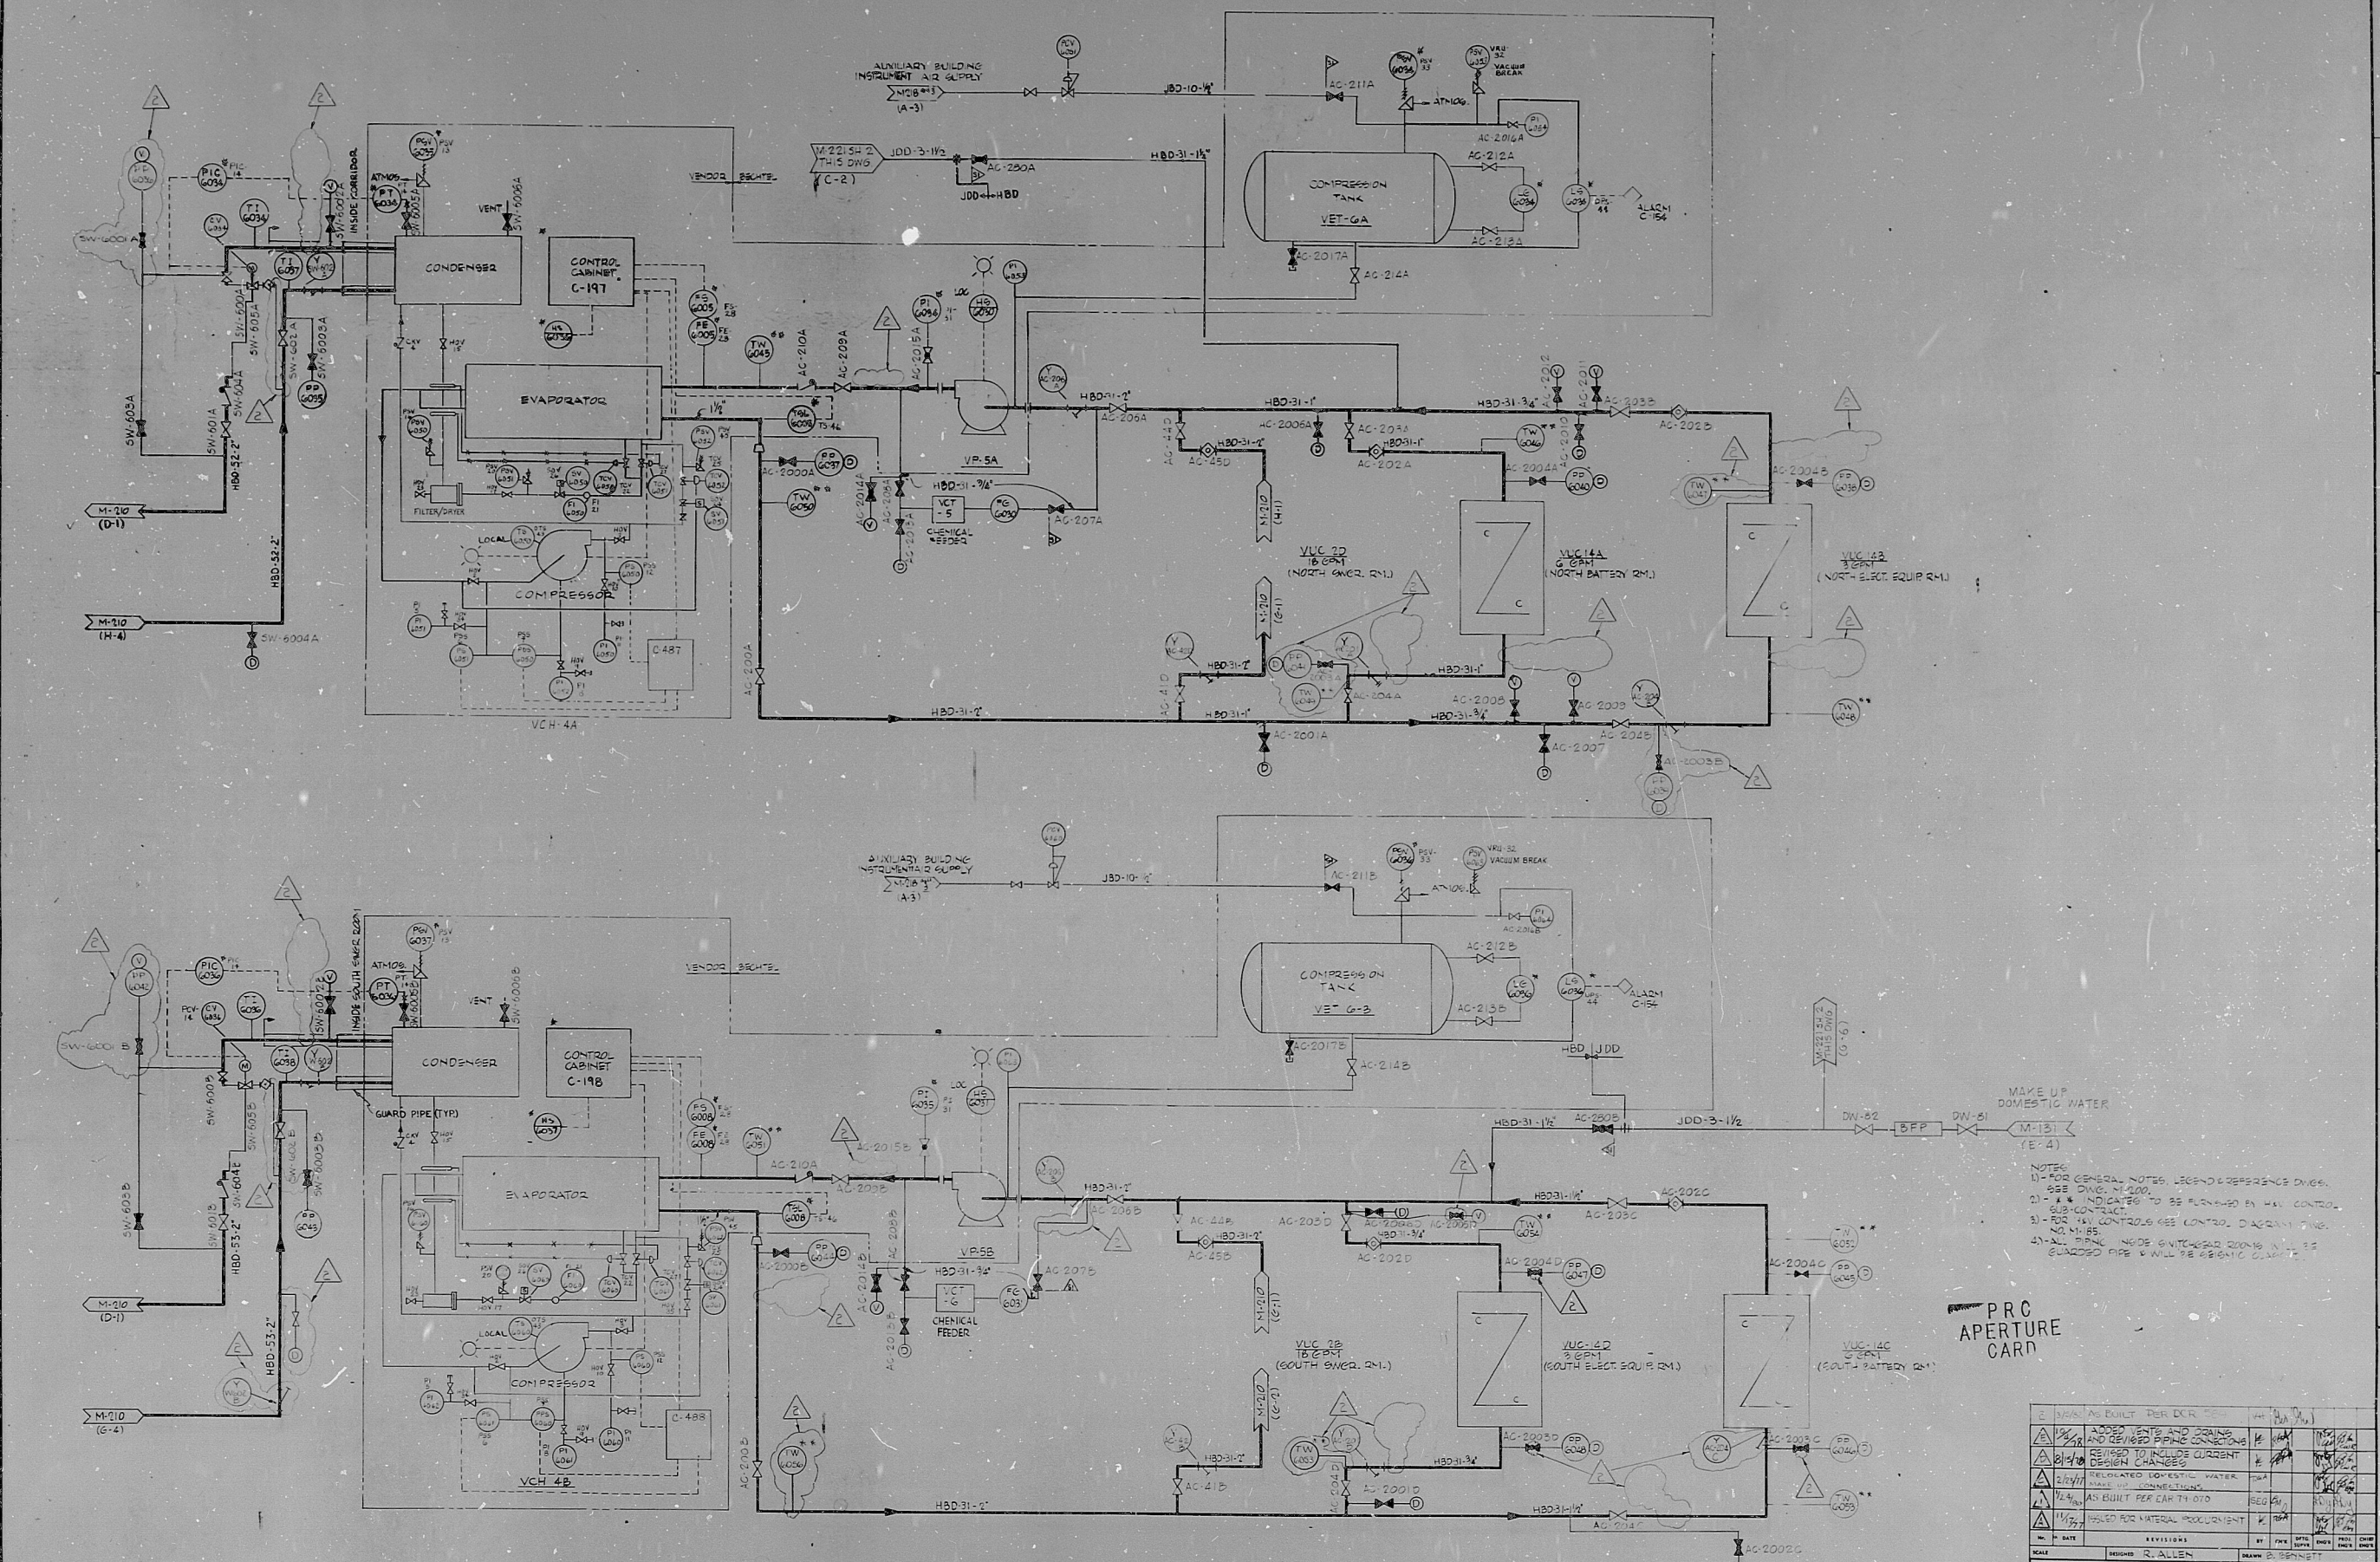

NOTES:  

PRC APERTURE CARD

NO.	DATE	REVISIONS	BY	DATE	REVISIONS	BY	DATE
1							
2							
3							
4							
5							
6							
7							
8							

**NRC BECHTEL CORPORATION**  
 SAN FRANCISCO

**ARKANSAS POWER & LIGHT COMPANY**  
 ARKANSAS NUCLEAR ONE  
 UNIT 2

PIPING & INSTRUMENT DIAGRAM  
 EMERGENCY CHILLED WATER SYSTEM  
 AUXILIARY BUILDING ELECTRICAL ROOMS

6600-1 M-221 SHEET 1 OF 2

8804080569 1



RIDS

8204080559

