


PANEL	INSTR. NO.	MANUAL VLV NO.
C-361	6431	SS-201A, S
C-362	6432	282A, B
C-363	6433	282A, B
C-364	6434	282A, B
C-365	6435	282A, B
C-366	6436	282A, B
C-367	6437	207A, B

BY CALGON

PANEL	TYPE
C302-1	MULTI POINT
C302-2	SINGLE POINT
C302-3	SINGLE POINT
C302-4	MULTI POINT
C302-5	MULTI POINT

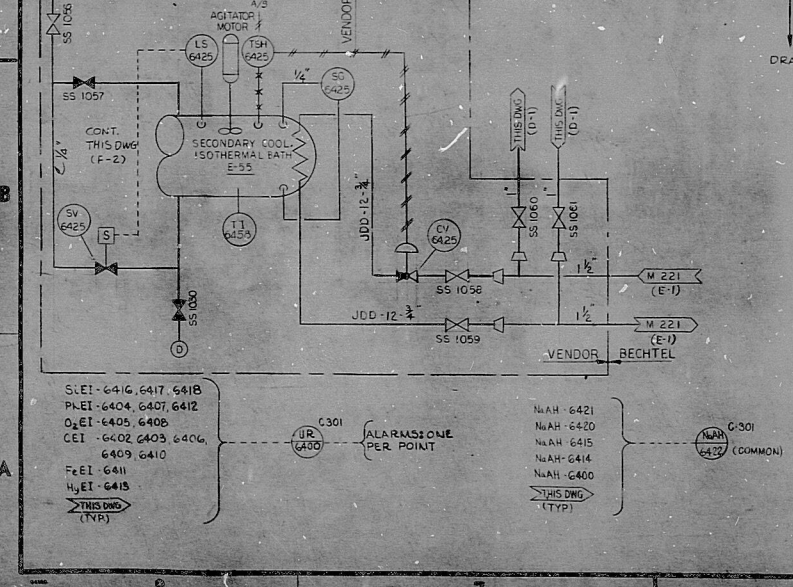


NRC

REV	DATE	BY	CHKD	DESCRIPTION
10	10/14/64	REV PER DCR 814'S DC 416	SCG	W
20	11/10/64	CORRECTED AS BUILT PER DCR 854	W	W
17	9/16/64	REV PER DCR 516C	W	W
16	8/20/64	REV PER DCR 75-10	W	W

BECHTEL CORPORATION
SAN FRANCISCO

SAN FRANCISCO

PIPING INSTRUMENT DIAGRAM
TO HYDRAZINE PUMPS
STROKE CONTROL MECHANISM

REV: 20

RIDS

8204080560

