


600-116

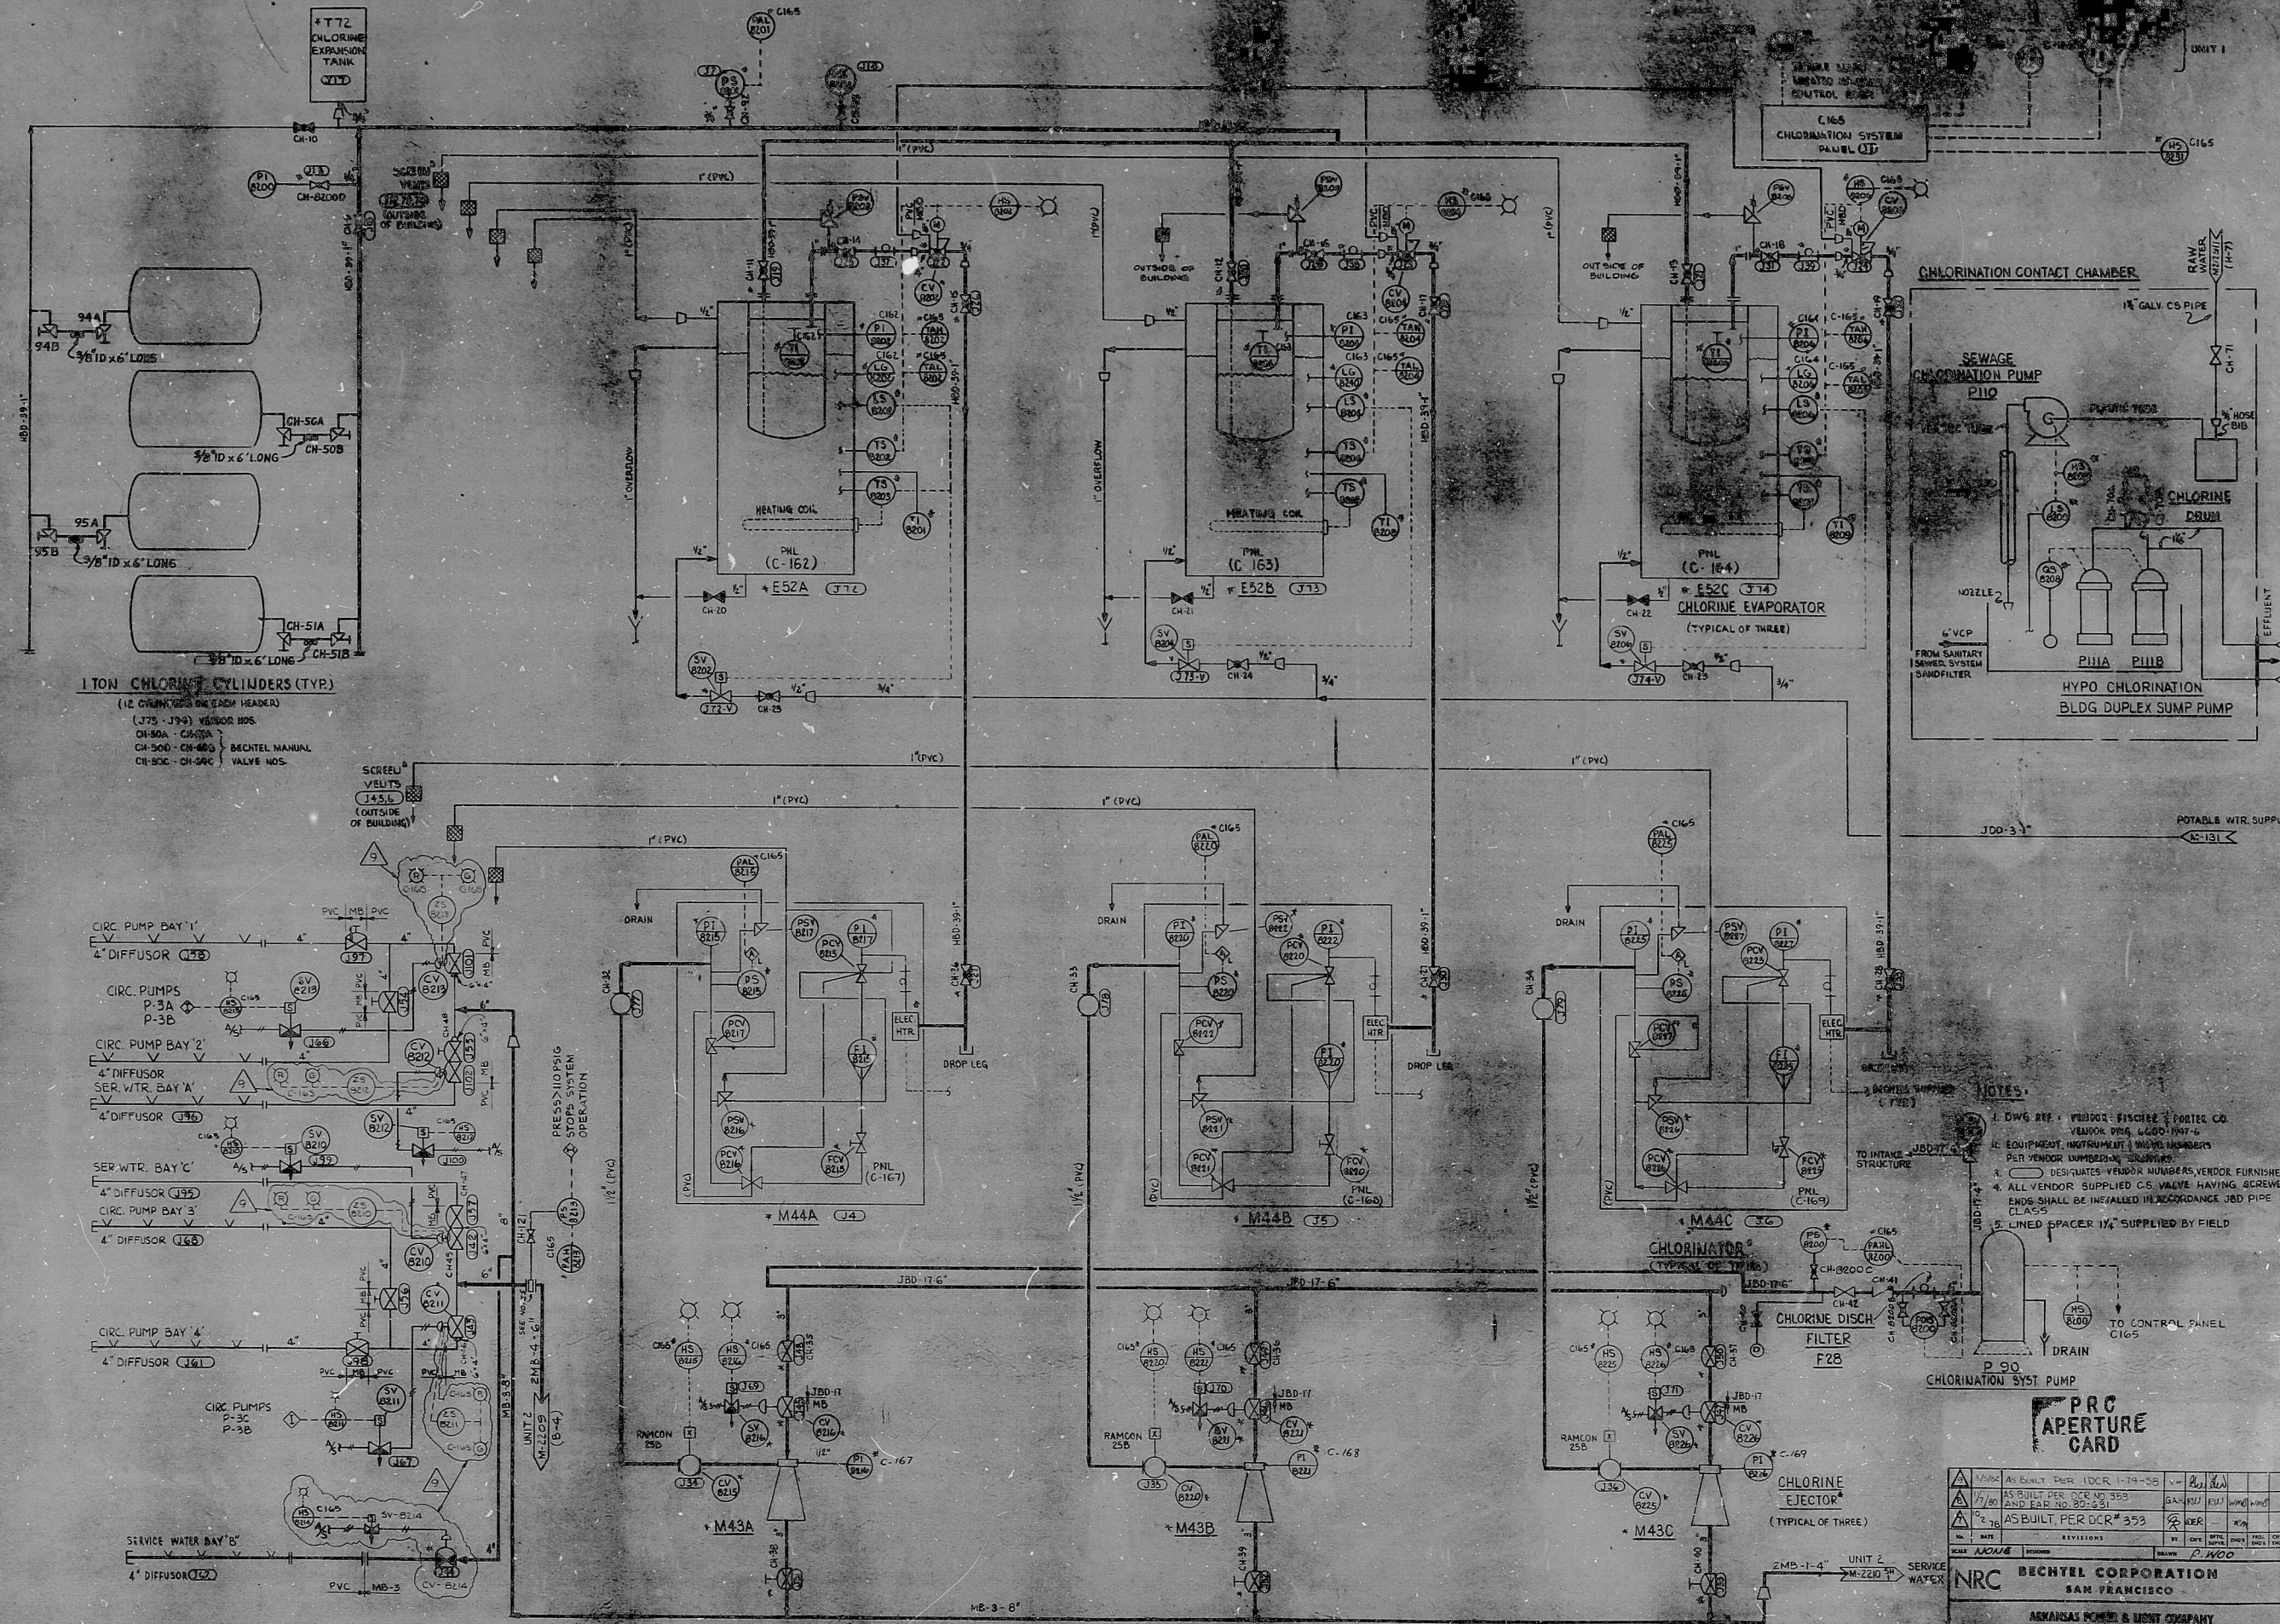

1 TON CHLORINE CYLINDERS (TYP.)
 (12 CYLINDERS PER BAY)
 (175 - 174) VENDOR NOS.
 CH-50A - CH-50C
 CH-50D - CH-50E BECHTEL MANUAL
 CH-50F - CH-50G VALVE NOS.

CIRC. PUMP BAY 1
 4" DIFFUSOR (P-35)
 CIRC. PUMPS
 P-3A
 P-3B

CIRC. PUMP BAY 2
 4" DIFFUSOR (P-36)
 SER. WTR. BAY 'A'
 4" DIFFUSOR (P-37)

SER. WTR. BAY 'C'
 4" DIFFUSOR (P-38)
 CIRC. PUMP BAY 3
 4" DIFFUSOR (P-39)

CIRC. PUMP BAY 4
 4" DIFFUSOR (P-40)
 CIRC. PUMPS
 P-3C
 P-3D

SERVICE WATER BAY 'B'
 4" DIFFUSOR (P-41)

NOTES:

1. DWG. REF. - VENDOR: BECHTEL PORTER CO. VENDOR DWG. 6600-1047-6 PER VENDOR INSTRUMENTATION DRAWINGS.
2. EQUIPMENT INSTRUMENTATION NUMBERS PER VENDOR INSTRUMENTATION DRAWINGS.
3. ALL VENDOR SUPPLIED CS VALVES HAVING SCREWED ENDS SHALL BE INSTALLED IN ACCORDANCE WITH PIPE CLASS.
4. LINED SPACER 1/2" SUPPLIED BY FIELD.

PRC APERTURE CARD

NO.	DATE	DESCRIPTION	BY	CHKD.
1	11/10/58	AS BUILT PER DCR 1-79-58
2	11/10/58	AS BUILT PER DCR NO. 388
3	11/10/58	AS BUILT PER DCR NO. 393

NRC BECHTEL CORPORATION
 SAN FRANCISCO

ARKANSAS POWER & LIGHT COMPANY
 ARKANSAS POWER PLANT

PIPING & INSTRUMENTATION DIAGRAM
 CHLORINATION SYSTEM





RIDS

8204080562

