
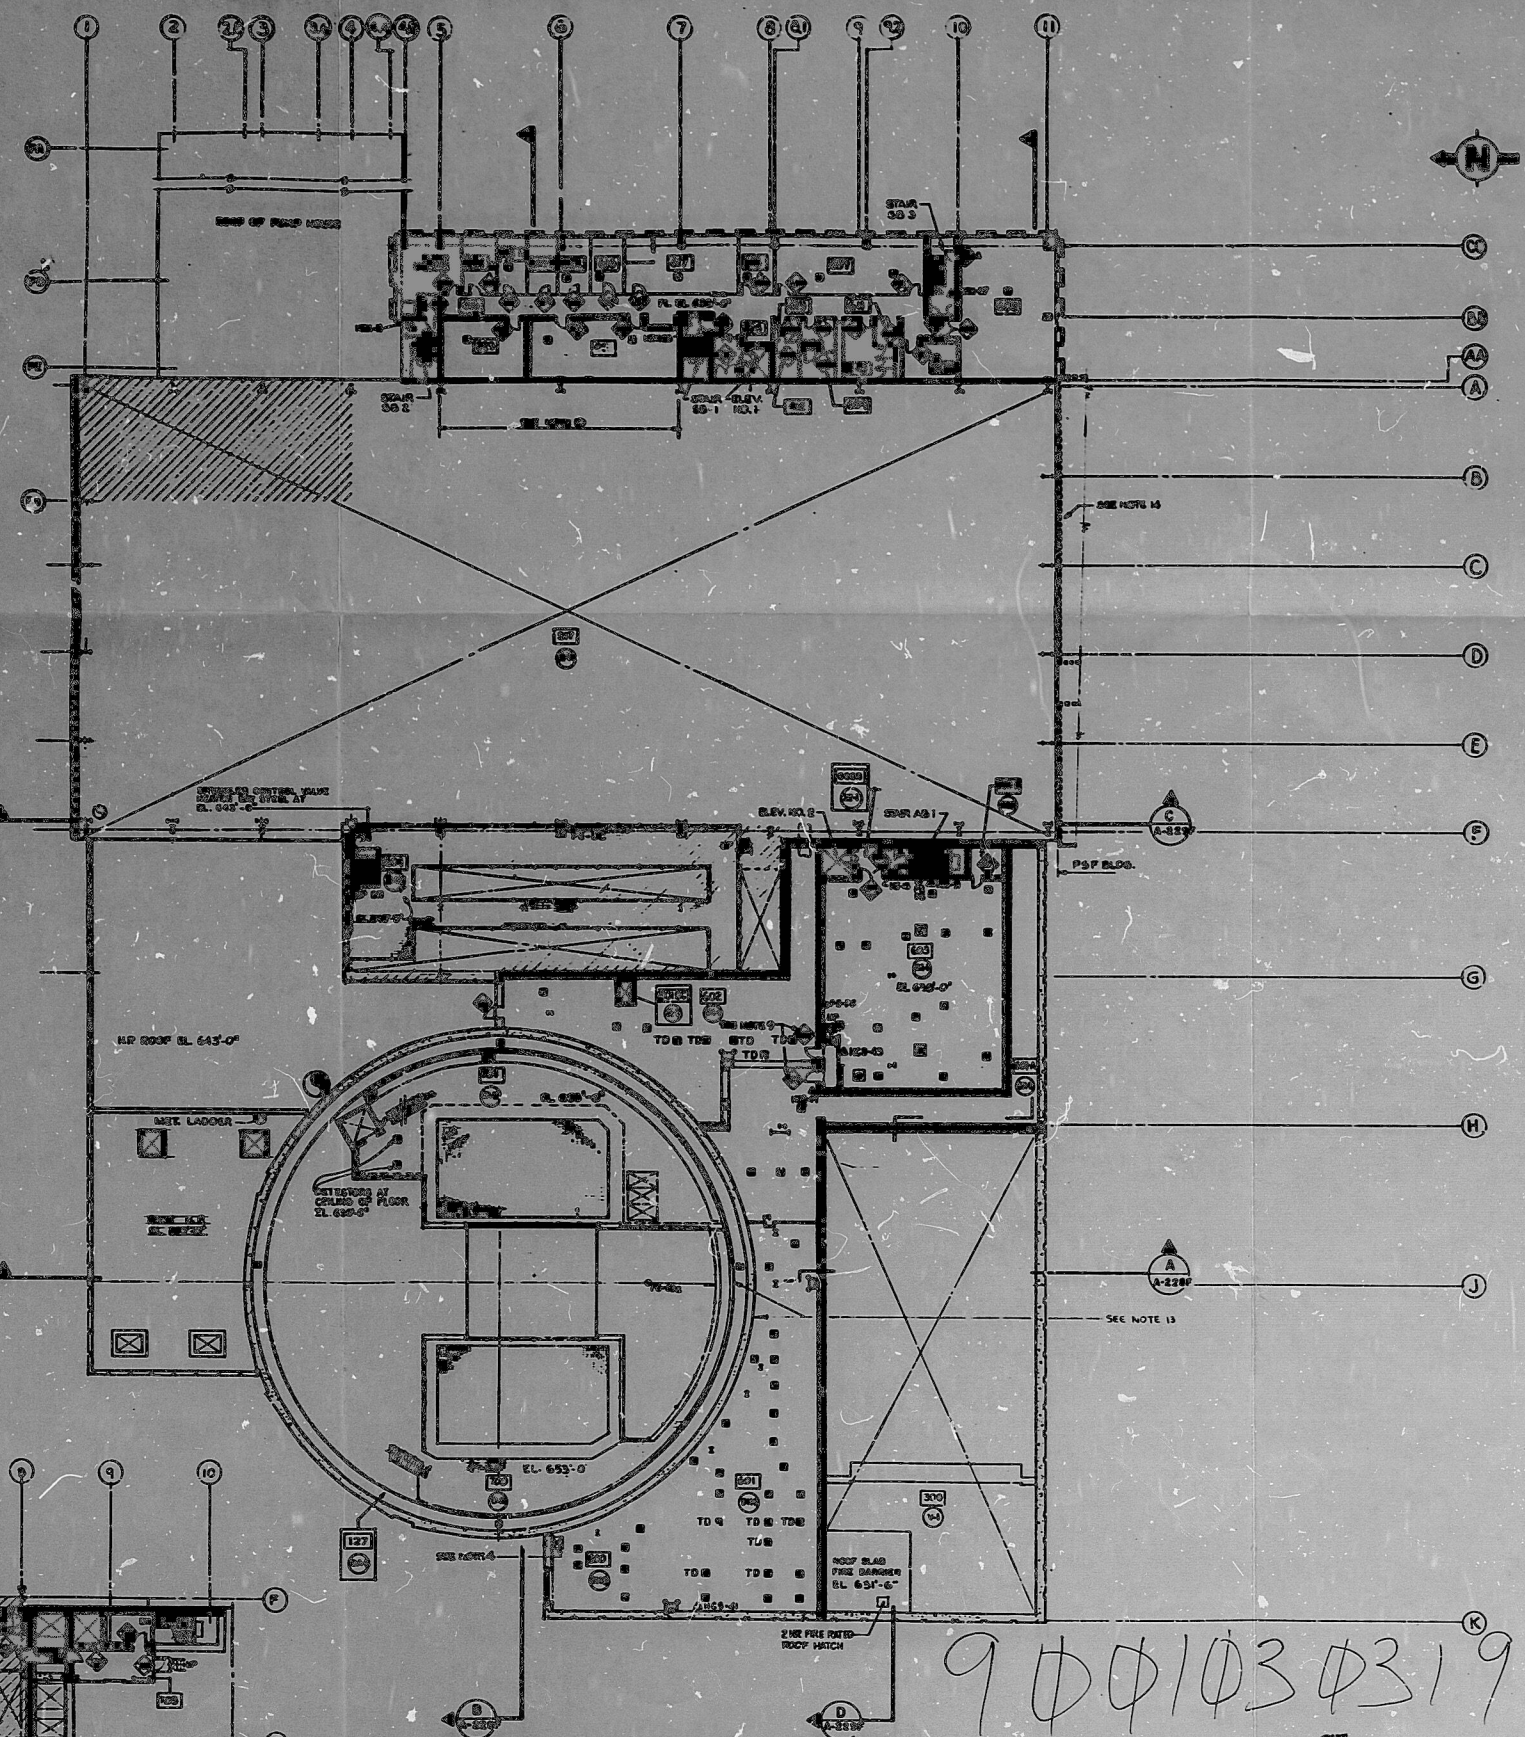


| SPACE NO. | SPACE DESCRIPTION | FIRE AREA @ 200 LB/FT ² | ROOF SLAB |
|-----------|-------------------|------------------------------------|-----------|
| NOSE STATION NUMBER | TYPE OF NOSE STATION | DESIGN NOSE LENGTH (FT) SEE NOTE 7 |
|---------------------|----------------------|------------------------------------|
| HC-31 | CABINET | 7.5 |
| HC-43 | CABINET | 7.5 |
| HC-45 | CABINET | 7.5 |
| HC-41 | CABINET | 7.5 |
| HR-27 | RACK | 7.5 |
| HR-25 | RACK | 7.5 |
| HR-11 | RACK | 7.5 |
| HC-16 | CONNECTION | N/A |

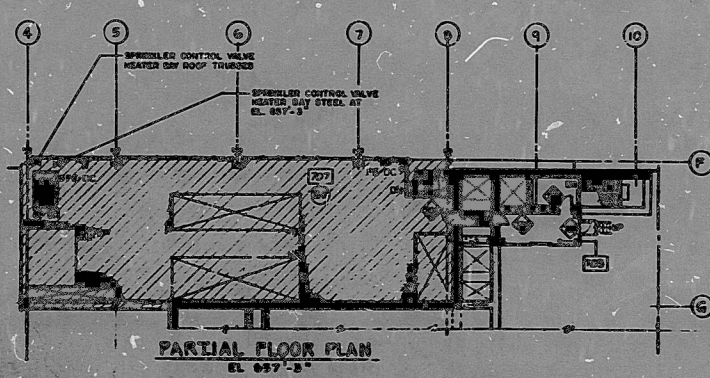

1. THIS DRAWING SHOWS THE GENERAL FIRE PROTECTION SYSTEM AND THE LOCATION OF THE FIRE PROTECTION SYSTEM COMPONENTS.

LEGEND

- 1. ALPHABETICAL SYMBOLS INDICATE THE FIRE AREA, THE GENERAL FIRE PROTECTION SYSTEM AND THE LOCATION OF THE FIRE PROTECTION SYSTEM COMPONENTS.
- 2. WATER CONTROL SYSTEMS PROTECTED AGAINST
- 3. 3/4" RATED FIRE DAMPER
- 4. 1/2" RATED FIRE DAMPER
- 5. AUTOMATIC SPRINKLER SYSTEM
- 6. STRUCTURAL STEEL ROOF PROTECT
- 7. AUTOMATIC SPRINKLER SYSTEM AND STRUCTURAL STEEL PROTECT
- 8. CONCRETE STRUCTURE IN COMPLIANCE WITH FIRE PROTECT REQUIREMENTS
- 9. AUTOMATIC SPRINKLER SYSTEM AND CONCRETE STRUCTURE IN COMPLIANCE WITH FIRE PROTECT REQUIREMENTS
- 10. SPRINKLER CONTROL VALVE
- 11. 2 HR FIRE RATED LOUVER
- 12. 1 HR FIRE RATED LOUVER
- 13. CLASS A TYPE FIRE DOOR
- 14. CLASS B TYPE FIRE DOOR
- 15. FIRE DETECTION IN RESTROOM - TYPE
- 16. SMOKE DETECTOR
- 17. FUSED TEMPERATURE
- 18. FUSE ELEMENTS PER TYPE
- 19. FUSE ELEMENTS PER TYPE
| | | | | |
|--|--------|----|---------|----------|
| NO. 100 | DATE | BY | CHECKED | APPROVED |
| 100 | | | | |
| BECHTEL COMPANY BETHESDA, MARYLAND | | | | |
| DAVIS-BESSE NUCLEAR POWER STATION THE YOUNG ENGINE COMPANY THE CLEVELAND ELECTRIC ILLUMINATING COMPANY | | | | |
| FIRE PROTECTION GENERAL FLOOR PLAN EL. 643'-0" | | | | |
| JOB NO. | DATE | BY | CHECKED | APPROVED |
| 12501 | A-226F | | | |

9001030319

NOTE:
THE FIRE EXTINGUISHER SYMBOLS REFLECT THE AS-INSTALLED CONDITION WHICH HAS BEEN DOCUMENTED AS DEFICIENT WITH RESPECT TO NFPA 10 REQUIREMENTS BY PCAQ 89-0015.

SI
APERTURE
CARD

THIS DWG. REPLACES
DWG. A-206F REV. 3

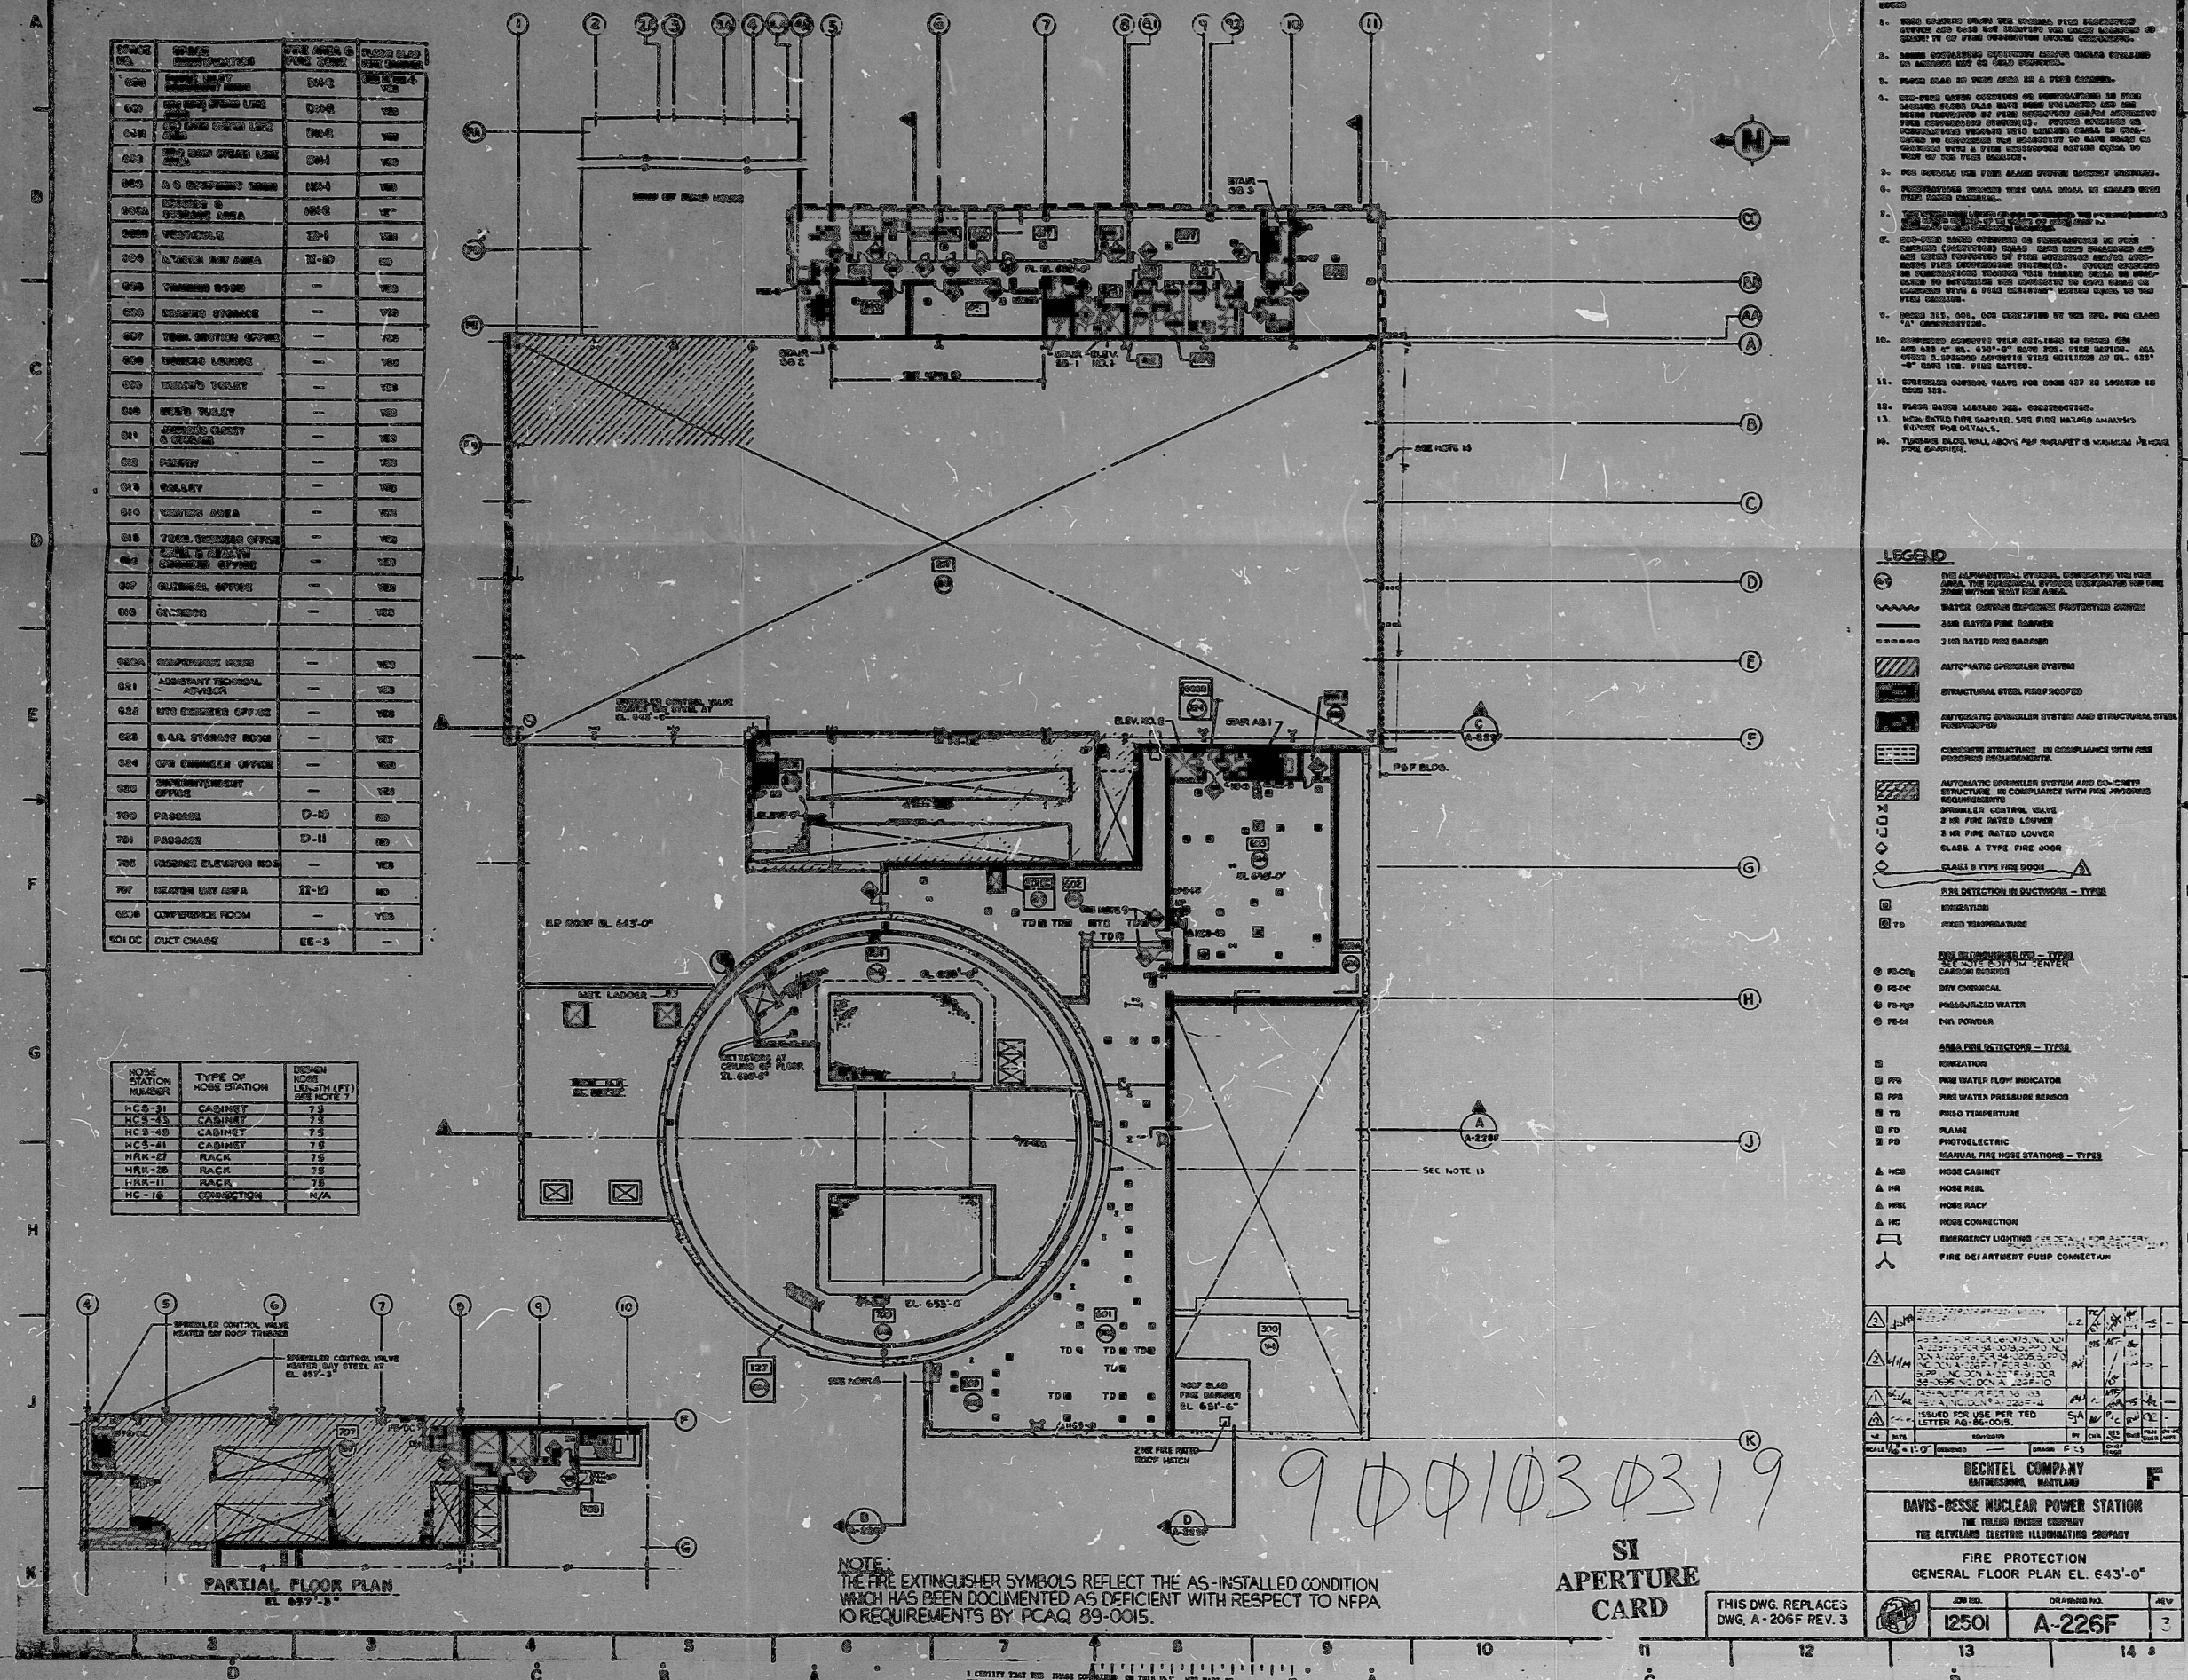

PDR RIDS

9001030319

