


NOISE STATION NUMBER	TYPE OF NOISE STATION	DESIGN NOISE LEVEL (DB) SEE NOTE 7
NS-0	CABINET	75
NS-10	CABINET	75
NS-15	REEL	100
NS-21	REEL	100

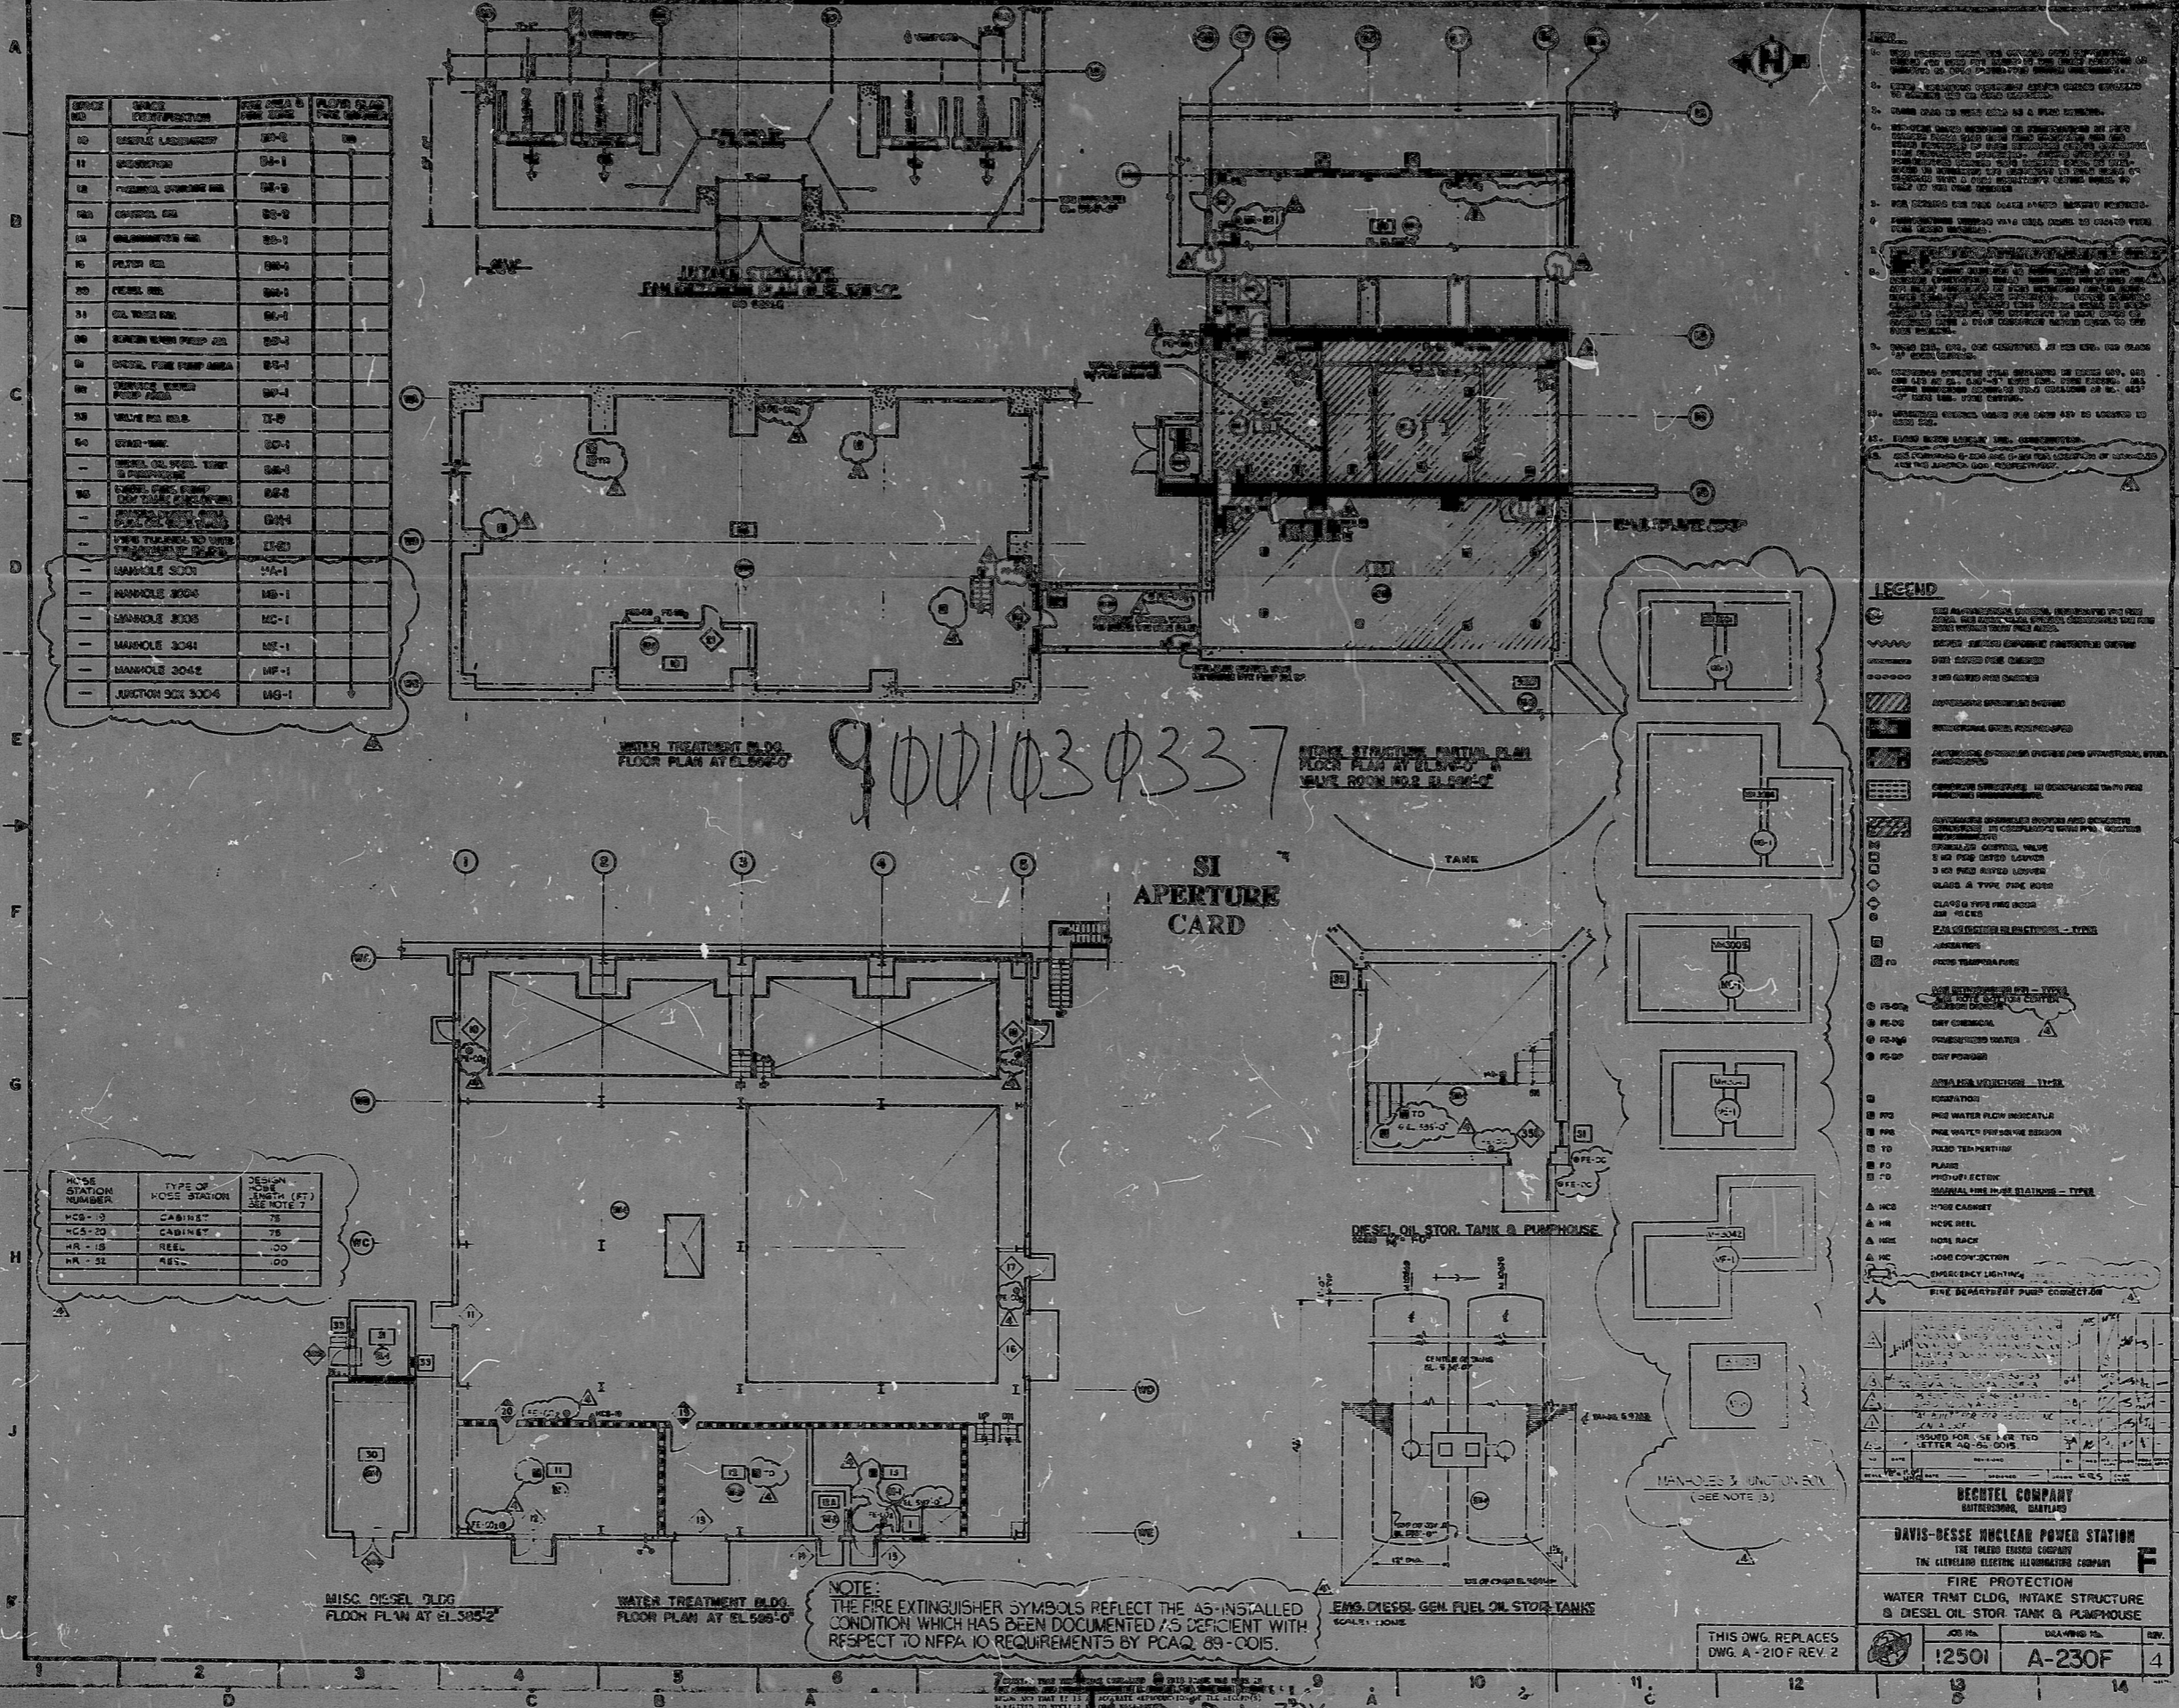

1. THIS DRAWING IS A PART OF THE DESIGN AND CONSTRUCTION DOCUMENTS FOR THE WATER TREATMENT BUILDING AT EL 596-0. IT IS TO BE USED IN CONJUNCTION WITH THE OTHER DRAWINGS IN THIS SET.
**LEGEND**

- SYMBOLS FOR FIRE EXTINGUISHERS:
  - ABC: ABC TYPE FIRE EXTINGUISHER
  - BC: BC TYPE FIRE EXTINGUISHER
  - CO2: CO2 TYPE FIRE EXTINGUISHER
  - D: DRY CHEMICAL
  - F: FLUOROCARBON
  - H: HALON
  - W: WATER

**BECHTEL COMPANY**  
 OAKLAND, CALIFORNIA

**DAVIS-BESSE NUCLEAR POWER STATION**  
 THE BECHTEL COMPANY  
 THE CLEVELAND ELECTRIC MANUFACTURING COMPANY

**FIRE PROTECTION**  
 WATER TRMT BLDG, INTAKE STRUCTURE  
 & DIESEL OIL STOR TANK & PUMPHOUSE

THIS DWG. REPLACES DWG. A-210-F-REV. 2

DATE: 12501  
 SCALE: A-230F  
 SHEET: 4

9001030337

NOTE: THE FIRE EXTINGUISHER SYMBOLS REFLECT THE AS-INSTALLED CONDITION WHICH HAS BEEN DOCUMENTED AS DEFICIENT WITH RESPECT TO NFPA 10 REQUIREMENTS BY PCAQ 89-COIS.

30X

PDR RIDS

9001030387

