


9001030382

SI
APERTURE
CARD

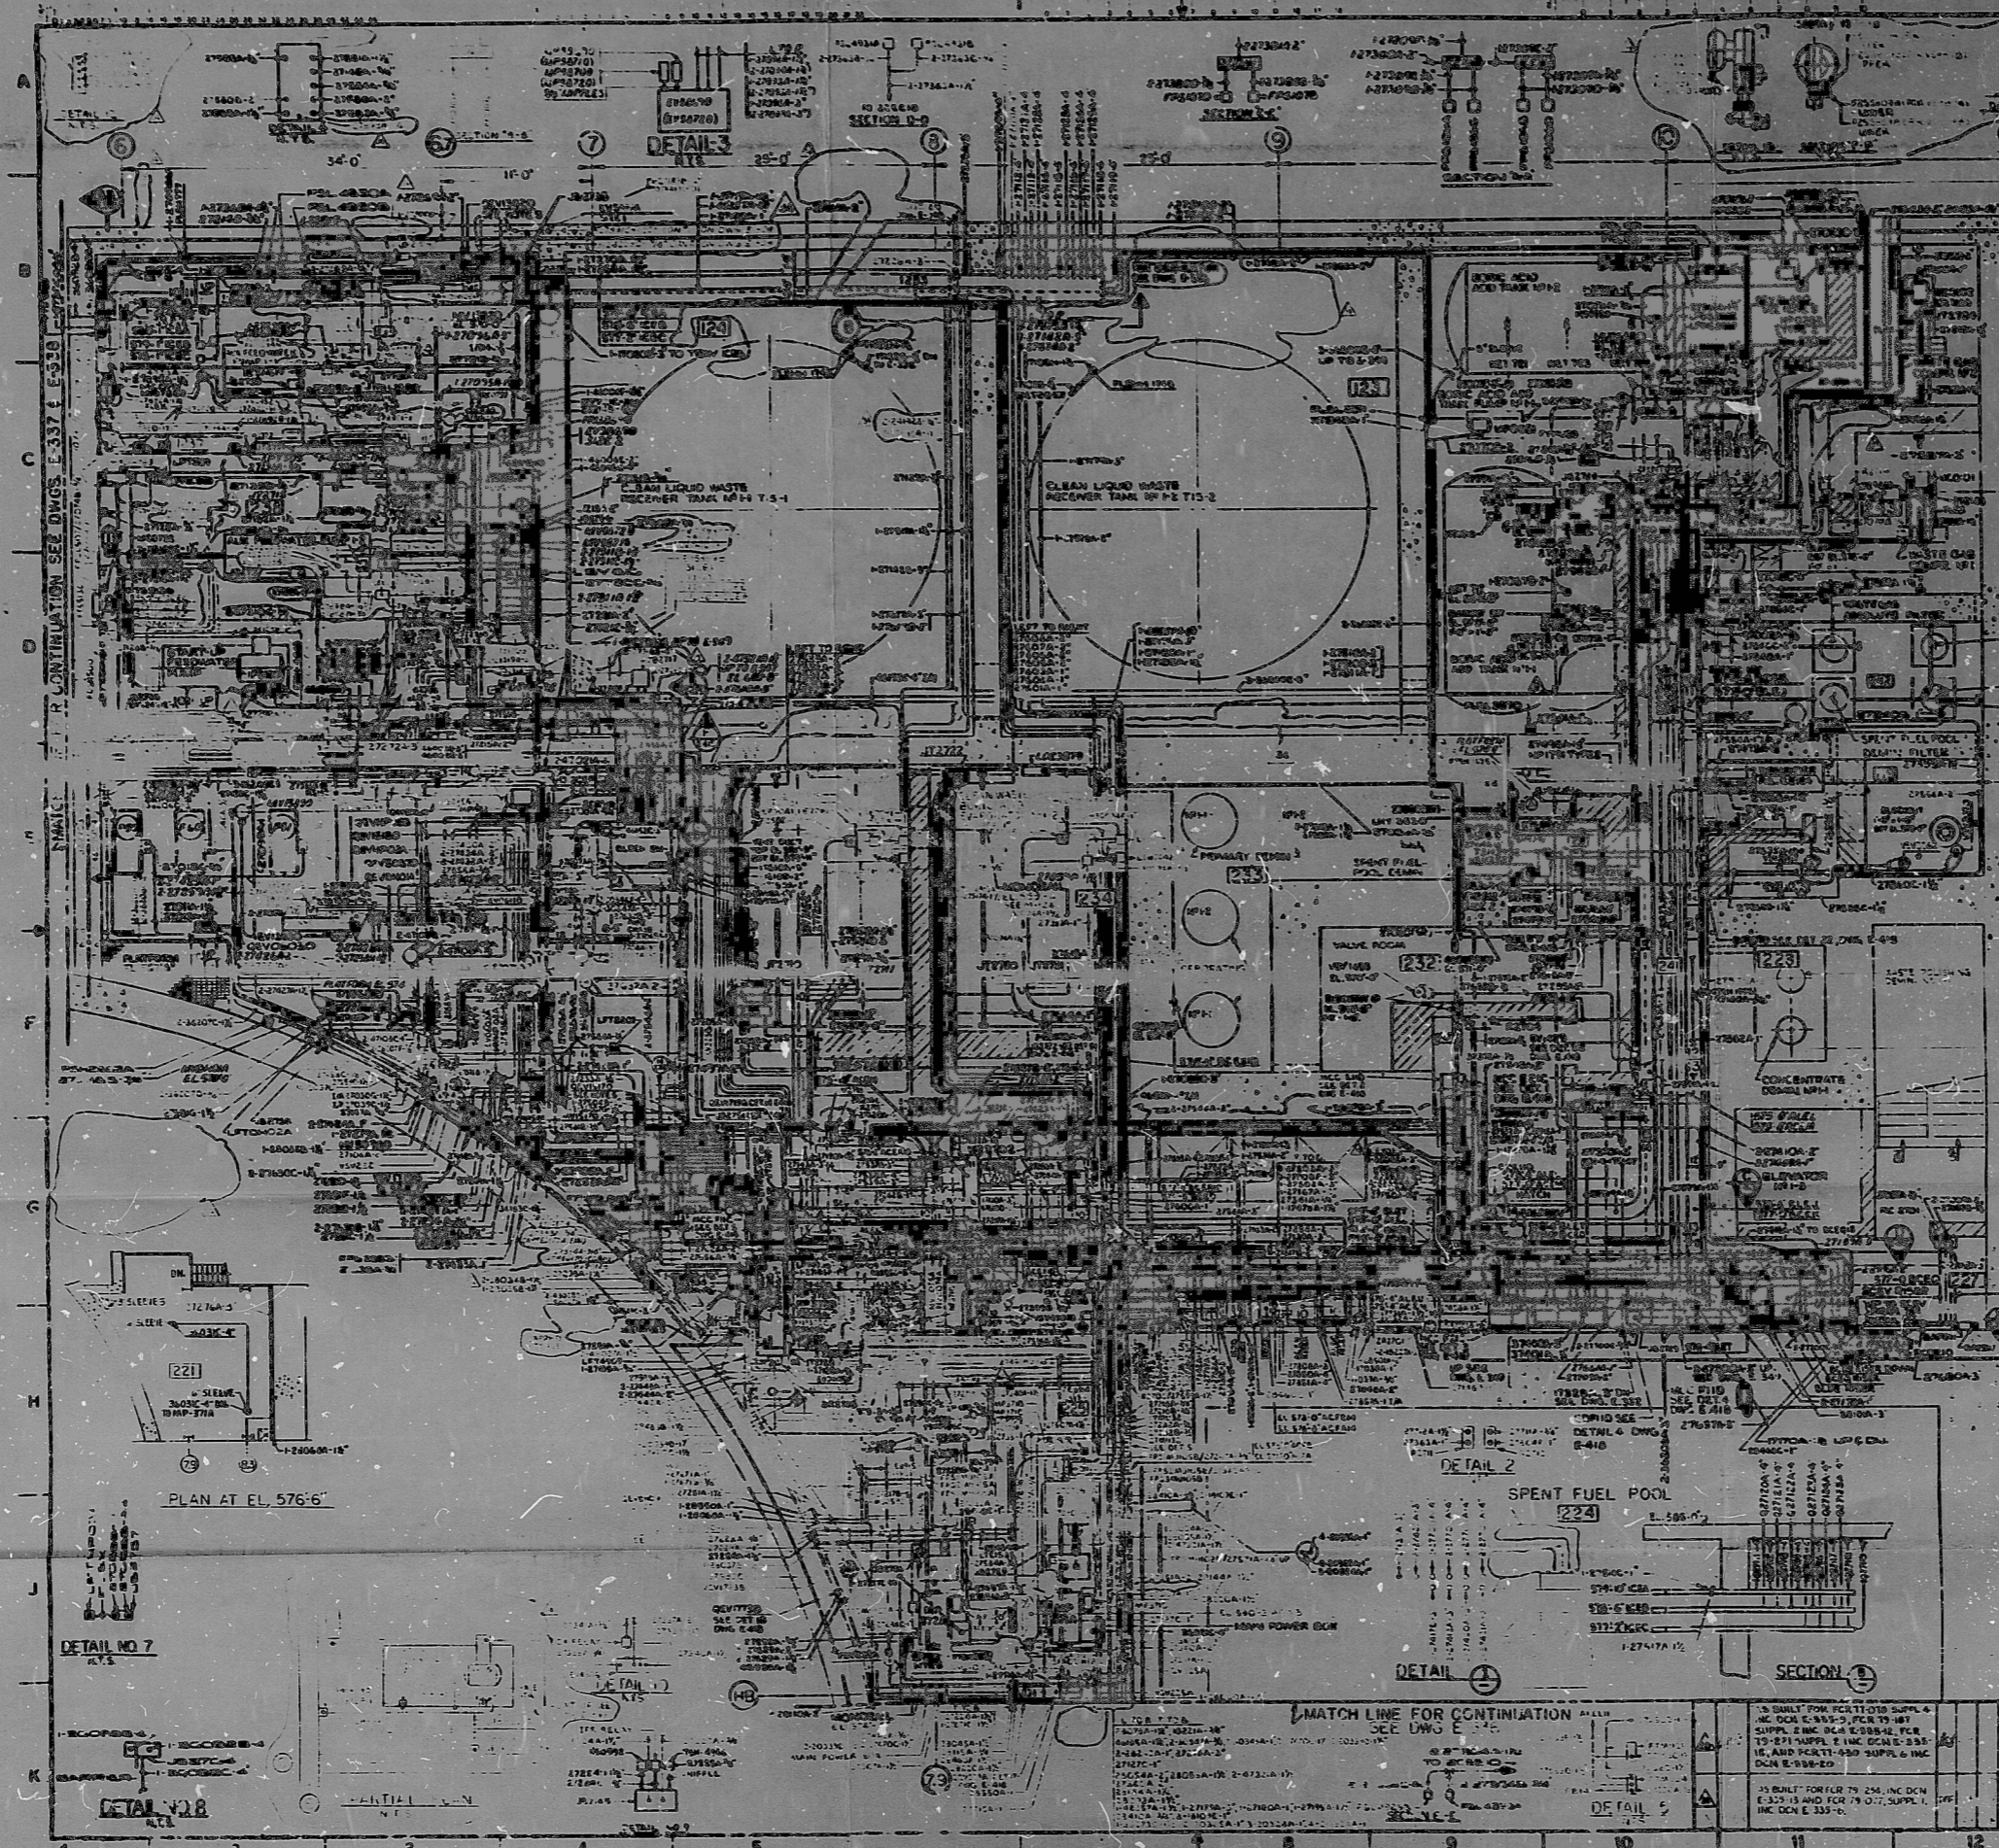


KEY PLAN

NOTES

- 1. ALL ELEVATIONS SHOWN ARE BOTTOM OF TRAY TRAY UNLESS NOTED.
- 2. FOR INSTALLATION OF RACEWAY SYSTEMS SEE SPECIFICATION 7400-E-3.
- 3. FOR NOTES, SYMBOLS & DETAILS SEE THE LEGEND.
- 4. ALL LOCAL CONTROL SYSTEMS TO BE MOUNTED ON PLATEFORMS.
- 5. FOR DETAILS OF RAY ROD MOUNTING HEIGHTS SEE ELECTRICAL, SEE DRAWING E-300, DETAIL 18.
- 6. FOR DETAILS OF RAY ROD BRASS DETAIL - 7.

REFERENCE DRAWINGS







- C-307 AUX BLDG FLOOR PLAN EL 565'-0"
- C-261 AUX BLDG BLOCKOUTS EL 565'-0"
- M-105 AUX BLDG EQUIPMENT LOCATIONS EL 565'-0"
- M-364 PIPING SYSTEM COMPOSITE AUX BLDG AREA 7 EL 565'-0"
- M-415 HEATING & VENTILATING AUX BLDG PLAN AT EL 565'-0"
- E-11A ELECTRICAL NUMBERING SYSTEMS
- E-300B ELECTRICAL RACEWAY SCHEDULES AND DETAILS
- E-302A ELECTRICAL STANDARDS & DETAILS
- E-333 RACEWAY & BRIDGES AUX BLDG ELEV 2 AREA 7 EL 565'-0"
- E-410 RACEWAY AUX BLDG SECT 1
- E-412 RACEWAY AUX BLDG SECT 2
- E-361 RACEWAY AUX BLDG SECT 3 & DETAILS
- M-369 WASTIC LAYOUTS, CONTAINERS & AUX BLDG PLANS AT EL 565'-0"

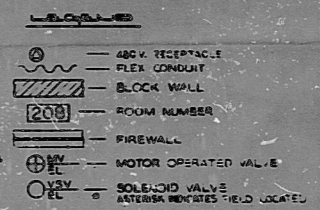


DAVIS-BESSE NUCLEAR POWER STATION
RACEWAY
 AUX. BLDG. ELEV(2) 565'-0" AREA 7

7740	E-335	
------	-------	--

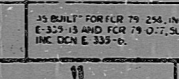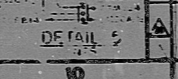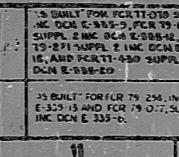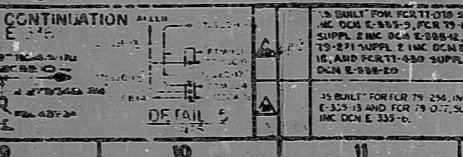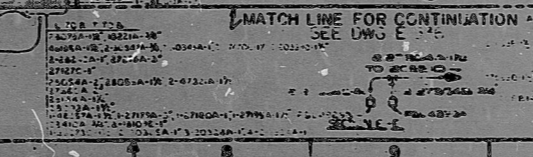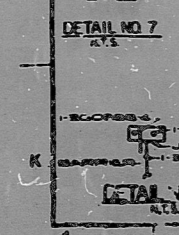


PDR RIDS

9001080382

