
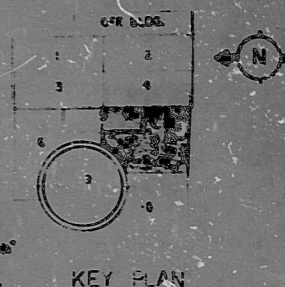


9001030385

SI
APERTURE
CARD

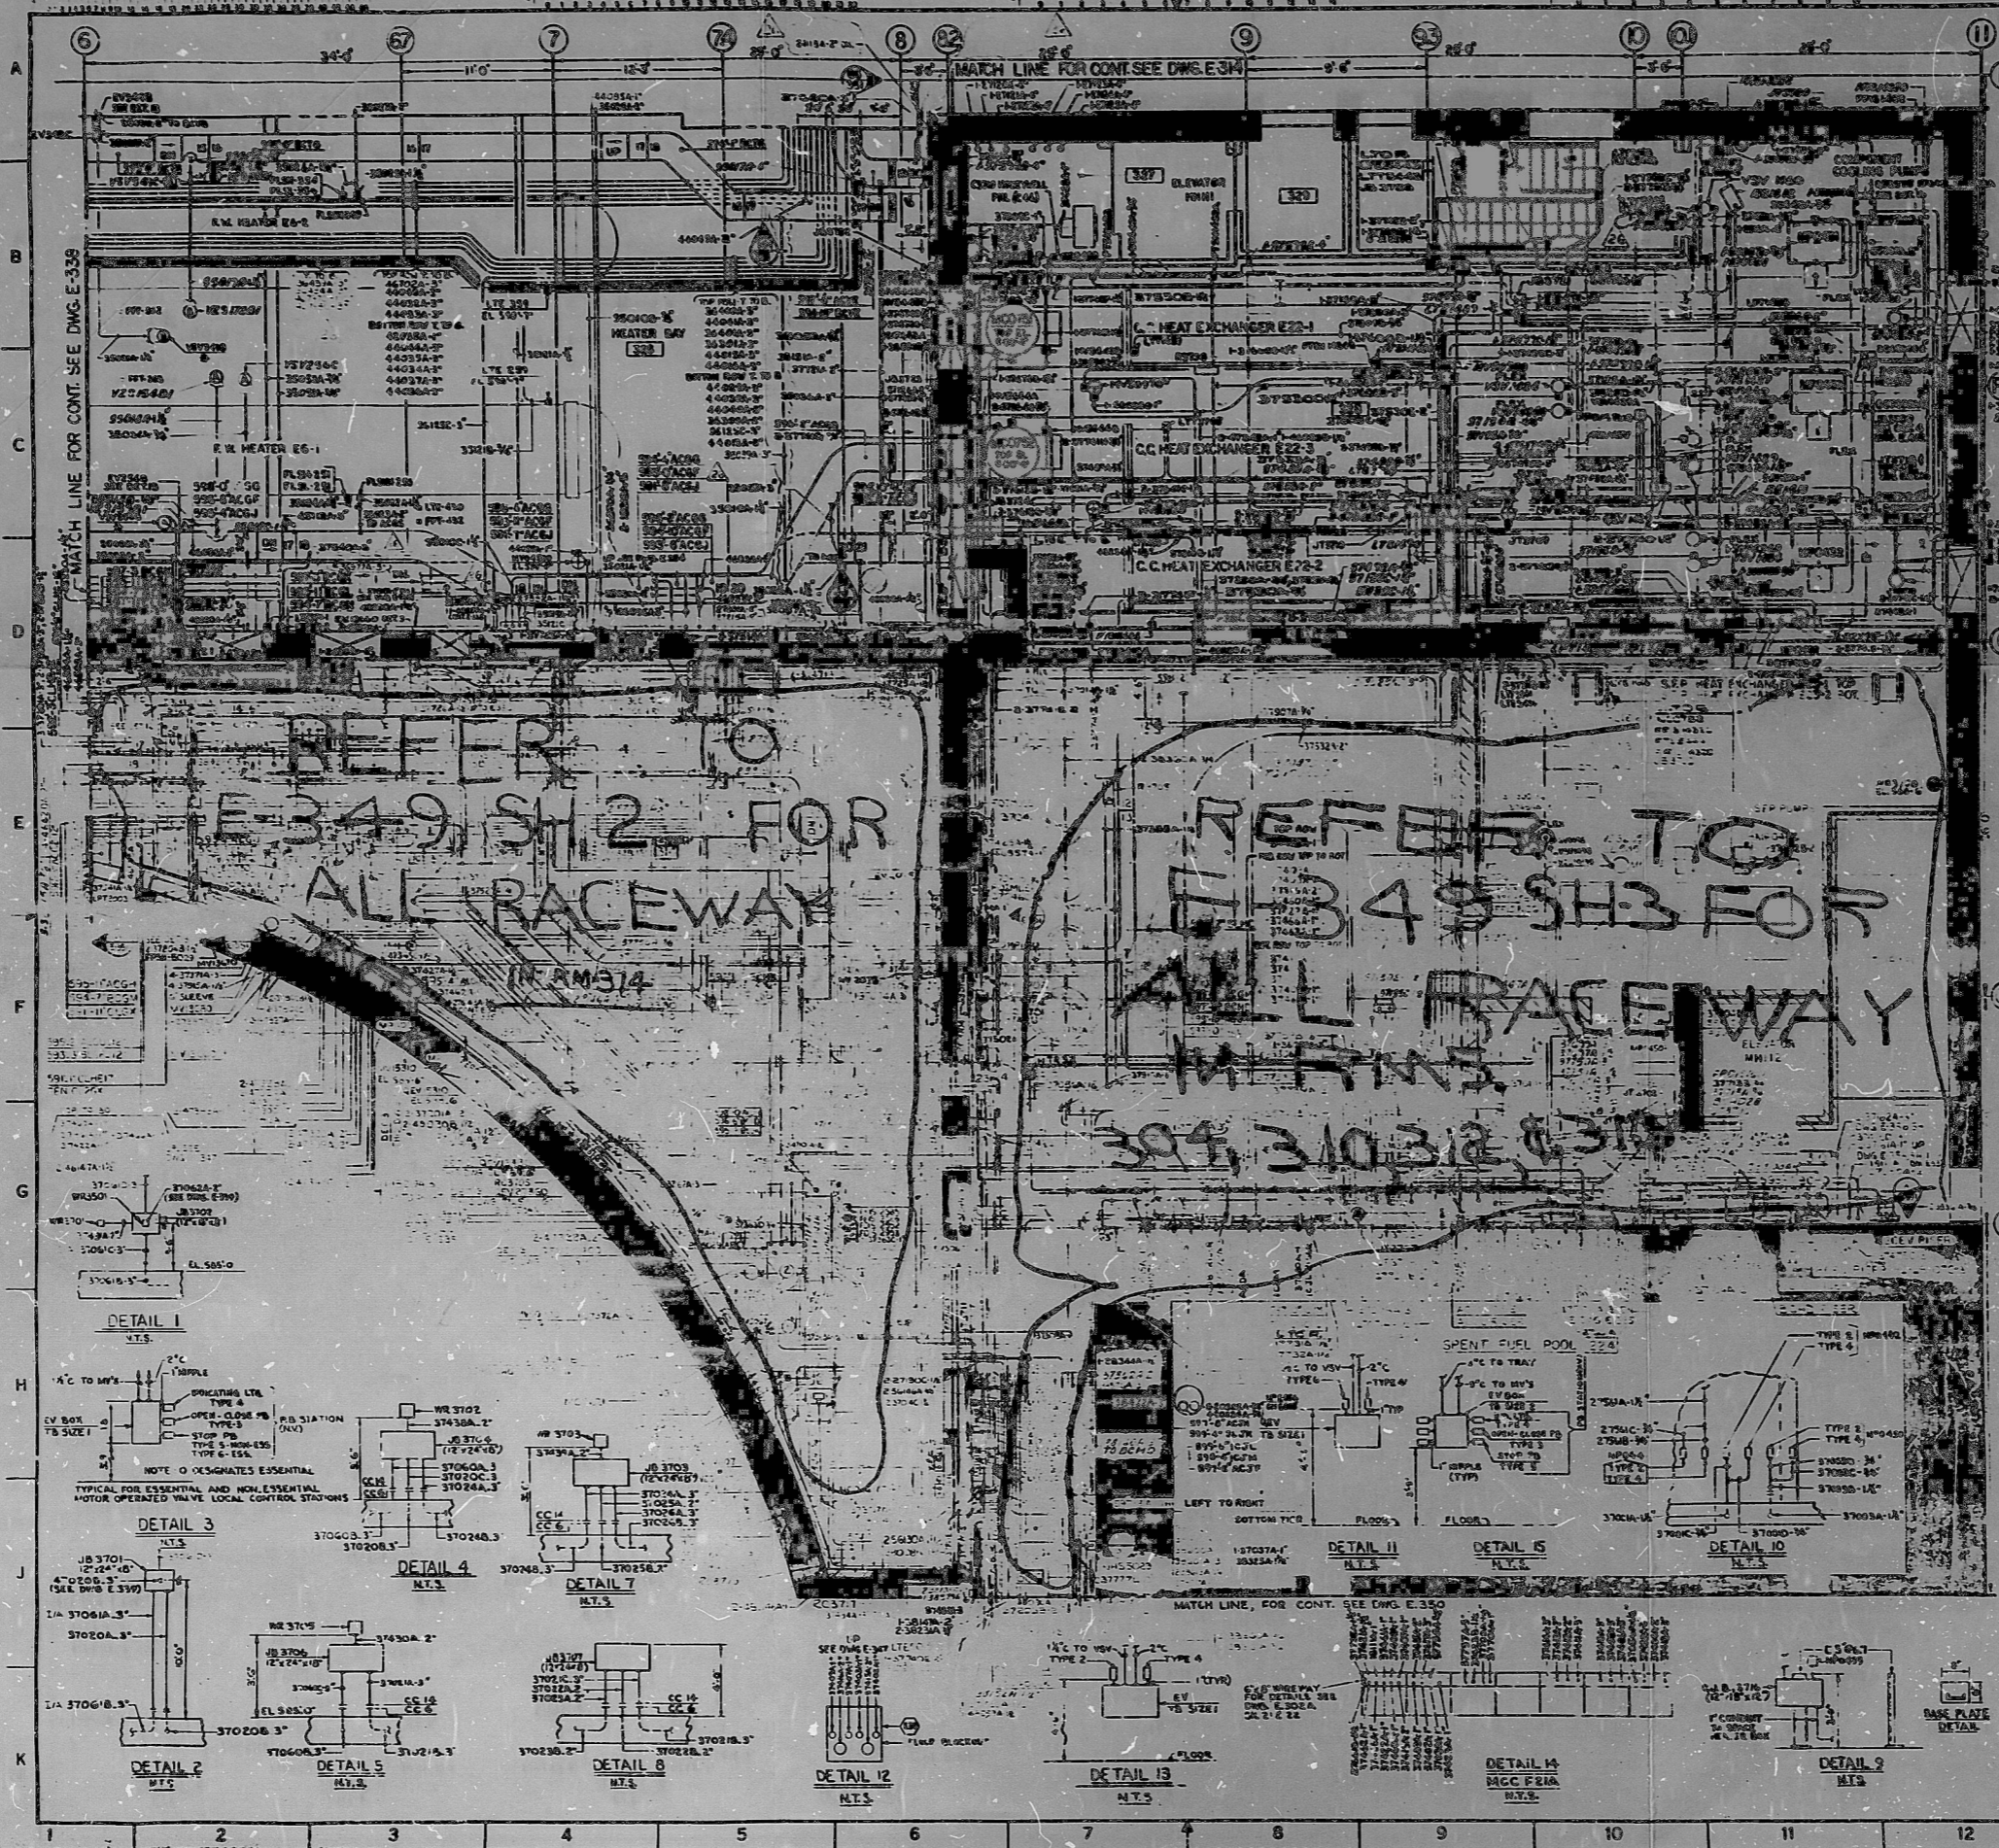

NOTES:

1. ALL RACEWAYS TO BE 24" X 24" UNLESS OTHERWISE SPECIFIED.

DETAIL 10 N.T.S.

REFERENCE DRAWINGS:

- E-349 SH 2
- E-349 SH 3

BECHTEL COMPANY
DAVIS-BESSE NUCLEAR POWER STATION
THE CLEVELAND ELECTRIC ILLUMINATION COMPANY
RACEWAY
AUX. BLDG. ELEV. (3) 585'-0" AREAS 5 & 7
JOB NO. 7740 DRAWING NO. E-349 SH 1 REV. 2

E 1 2 3 4 5 6 7 8 9 10 11 12 13 14

PDR RIDS

9001080385

