

NOTES


- FOR INSTALLATION OF RACEWAY SYSTEMS SEE INFORMATION 7743-814
- ALL LOCAL CONTROL SYSTEMS TO BE INSTALLED 6'-6" TO 8' IN STATION ABOVE FLOOR OR PLATFORM
- ALL RACEWAYS & EQUIPMENT LOCATIONS TO BE INDICATED ON 2-D & 3-D DRAWINGS
- USE AUTOMATIC AIR SOURCE SEE 814-7743-814
- THE PUMP IS TO BE OPERATED BY CONDUIT TO BE RUN AS NOT TO EXCEED PRESSURE RATES AS INDICATED ON DRAWING OF THE PUMP

REFERENCE DRAWINGS

- C-200 AUX BLDG FOUNDATION MAY EL 545'-0" AREA B
- C-240 AUX BLDG BLOCKOUTS/EQUIPMENT ROOMS ANCHOR BOLT/ & DRAINAGE EL 545'-0"
- C-250 AUX BLDG PLATFORMS I DETAILS EL 545'-0"
- C-259 AUX BLDG FRAMING PLAN EL 545'-0"
- M-125 EQUIPMENT LOCATIONS CONTAINMENT / AUX BLDG PLAN EL 545'-0"
- M-263B DRIFING SYSTEM COMPOSITE AUX BLDG EL 545'-0" AREA B
- M-414 HEATING, VENTILATING & AIR CONDITIONING AUX BLDG EL 545'-0"
- E-11A ELECTRICAL NUMBERING SYSTEM
- E-3000 ELECTRICAL RACEWAY SCHEDULE
- E-304 ELECTRICAL GROUNDING STANDARDS I DETAILS
- E-302A ELECTRICAL STANDARDS I DETAILS
- E-331 RACEWAY & GROUNDING AUX BLDG EL (I) 545'-0" AREA B
- E-334 RACEWAY & GROUNDING AUX BLDG EL (I) 545'-0" AREA B
- M-170 RUSTE LOCATIONS CONT / AUX BLDG EL 545'-0"

90φ1φ3φ392

SI APERTURE CARD

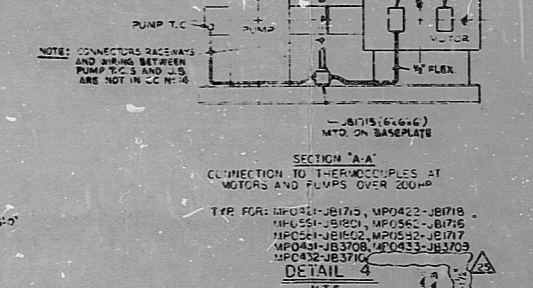

LEGEND

- BLOCK WALL
- ROOM NUMBER
- FIREWALL
- MOTOR OPERATED VALVE
- SOLENOID VALVE
- ARMATURE LOCATED
- TEE CONDUIT
- NEGATIVE PRESSURE BOUNDARY

NO.	DESCRIPTION	REV.	DATE	BY	CHKD.
BECHTEL COMPANY
 DAVIS-BESSE NUCLEAR POWER STATION
 THE CLEVELAND ELECTRIC LABORATORY COMPANY
RACEWAY
 AUX. BLDG. FLOOR (I) 545'-0" AREA B

7749	E-412	25
------	-------	----



PDR RIDS

9001030392

