


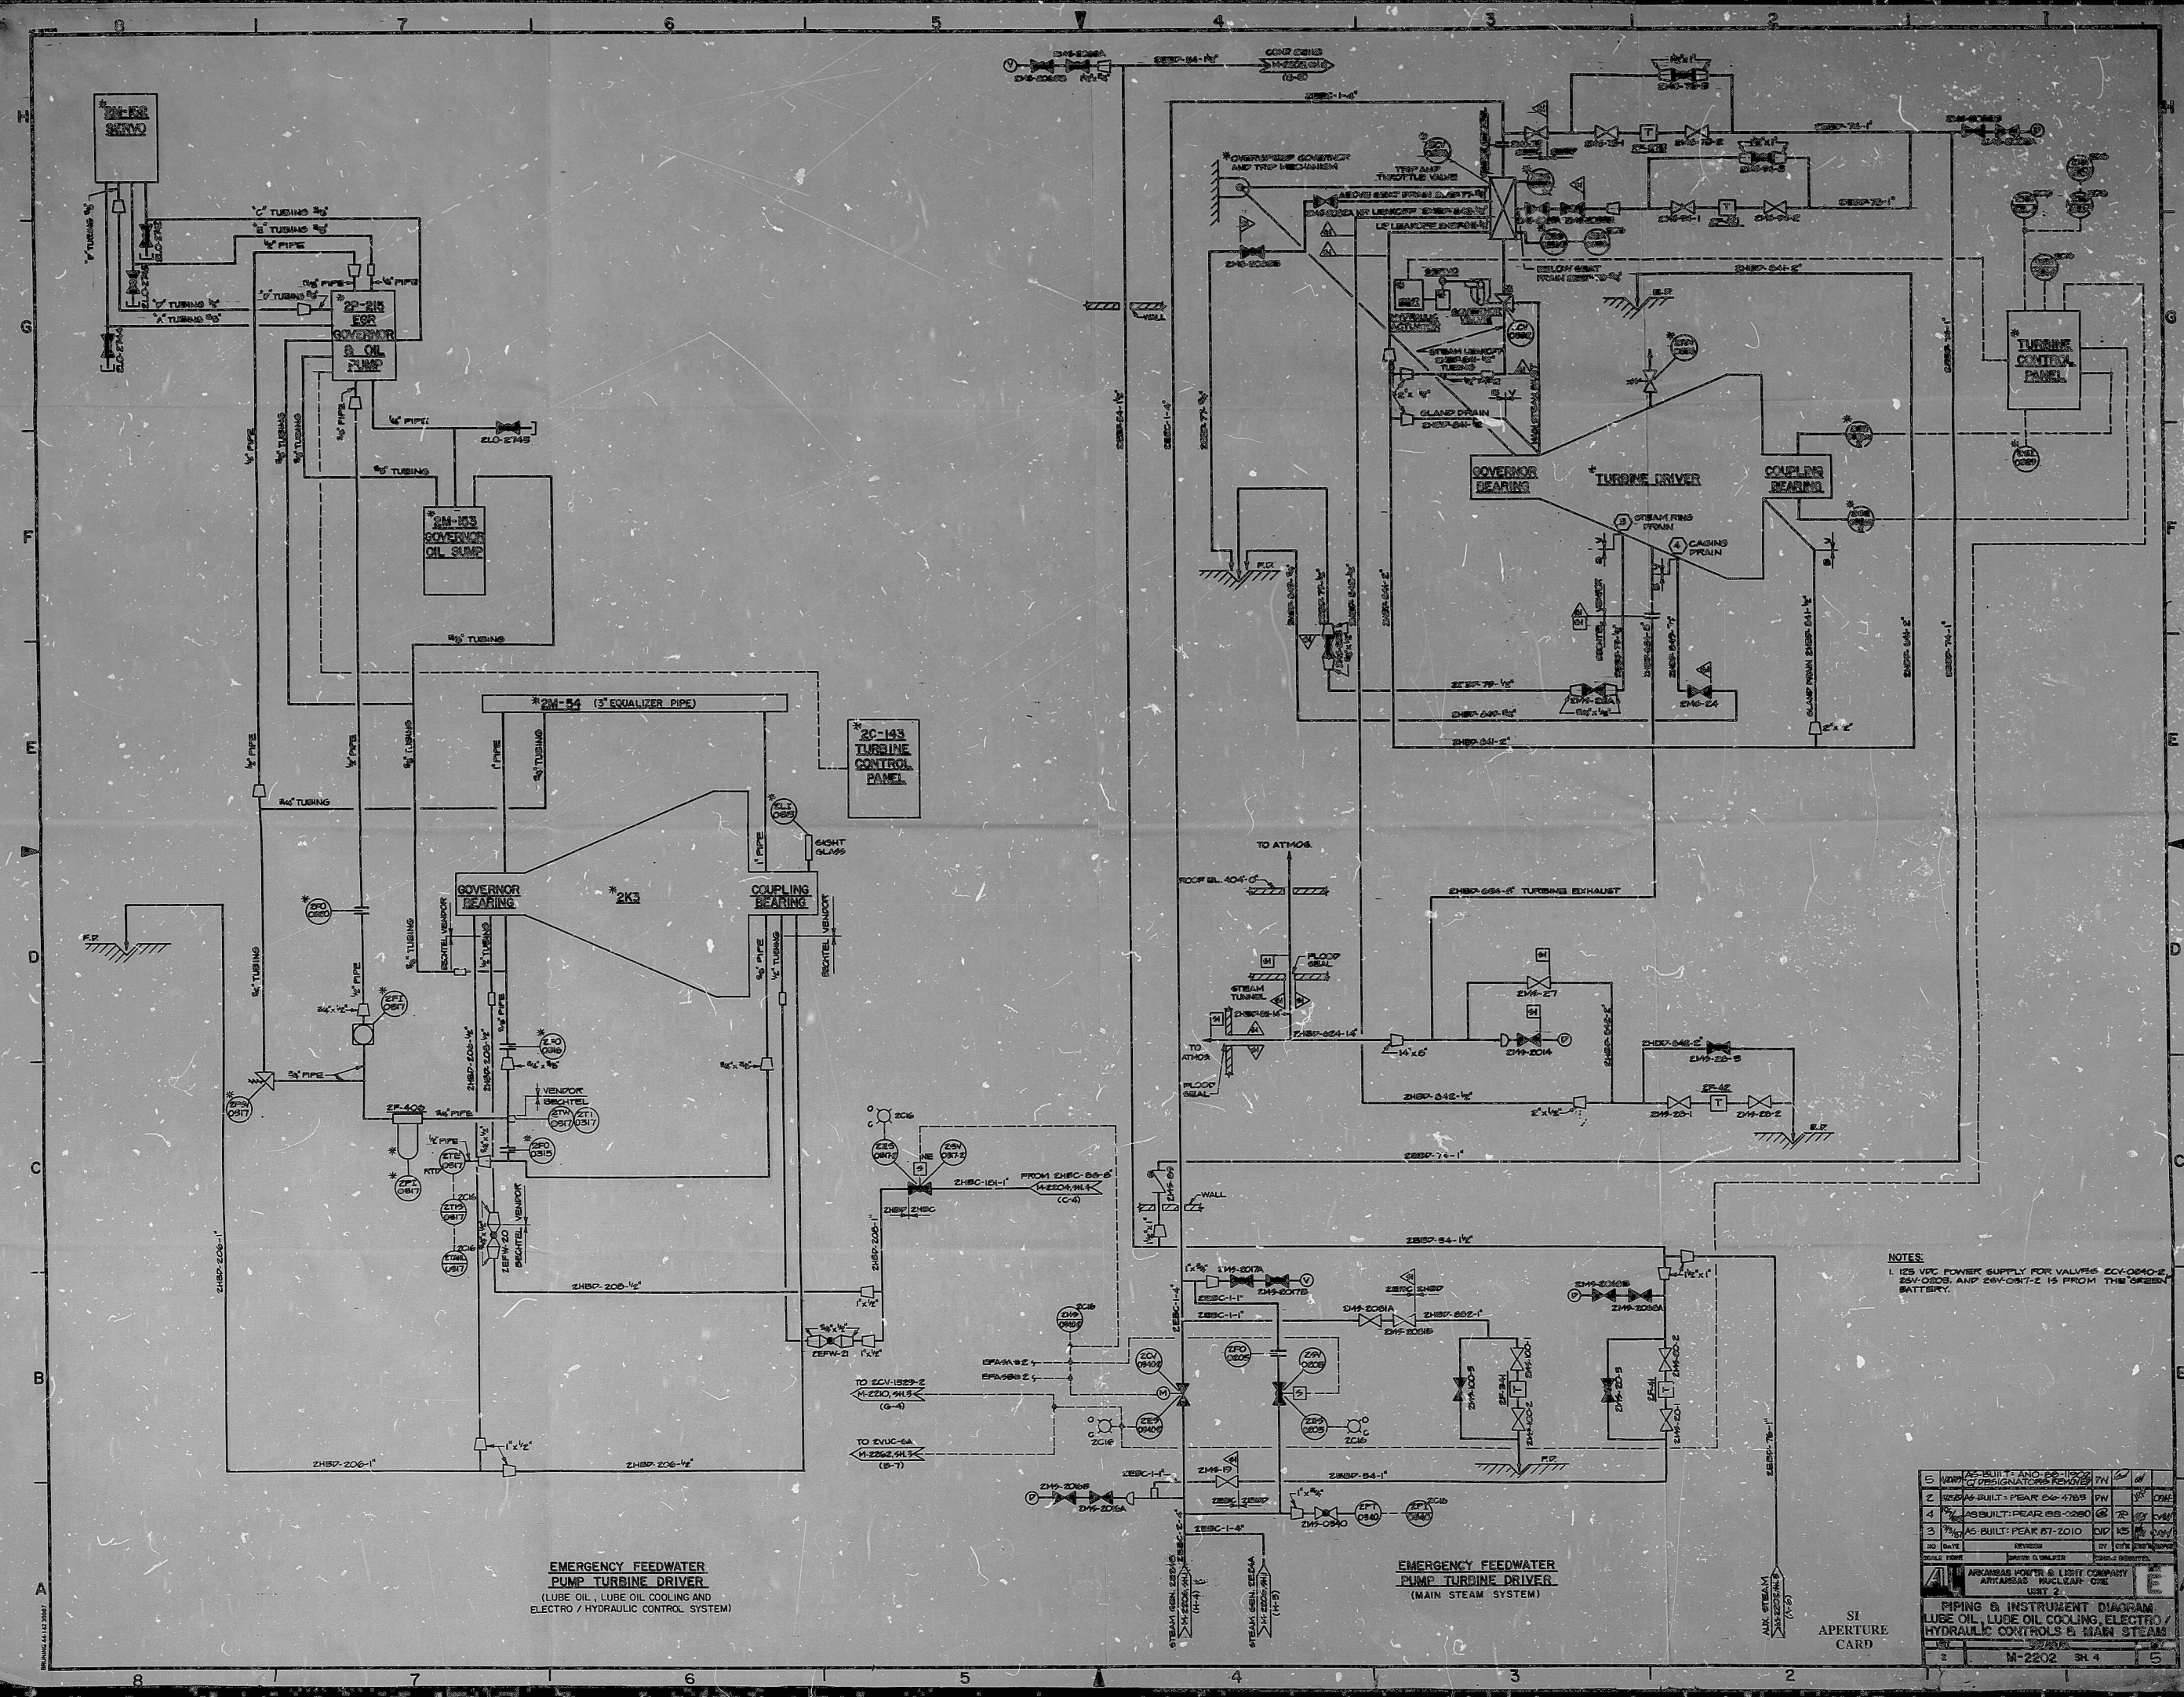

NOTES:

1. 125 VDC POWER SUPPLY FOR VALVES ECY-0840-2, ECY-0840-3, AND ECY-0840-4 IS FROM THE GREEN BATTERY.

5	AS-BUILT: AND-05-10-75	PN	4	4
4	AS-BUILT: PEAR-05-10-75	PN	3	3
3	AS-BUILT: PEAR-05-10-75	PN	2	2
2	AS-BUILT: PEAR-05-10-75	PN	1	1
1	AS-BUILT: PEAR-05-10-75	PN	0	0
NO	DATE	REVISED	BY	DATE

EMERGENCY FEEDWATER
PUMP TURBINE DRIVER
(LUBE OIL, LUBE OIL COOLING AND
ELECTRO / HYDRAULIC CONTROL SYSTEM)

EMERGENCY FEEDWATER
PUMP TURBINE DRIVER
(MAIN STEAM SYSTEM)

SI
APERTURE
CARD

*9001220053

PDR RIDS

9001300232

