


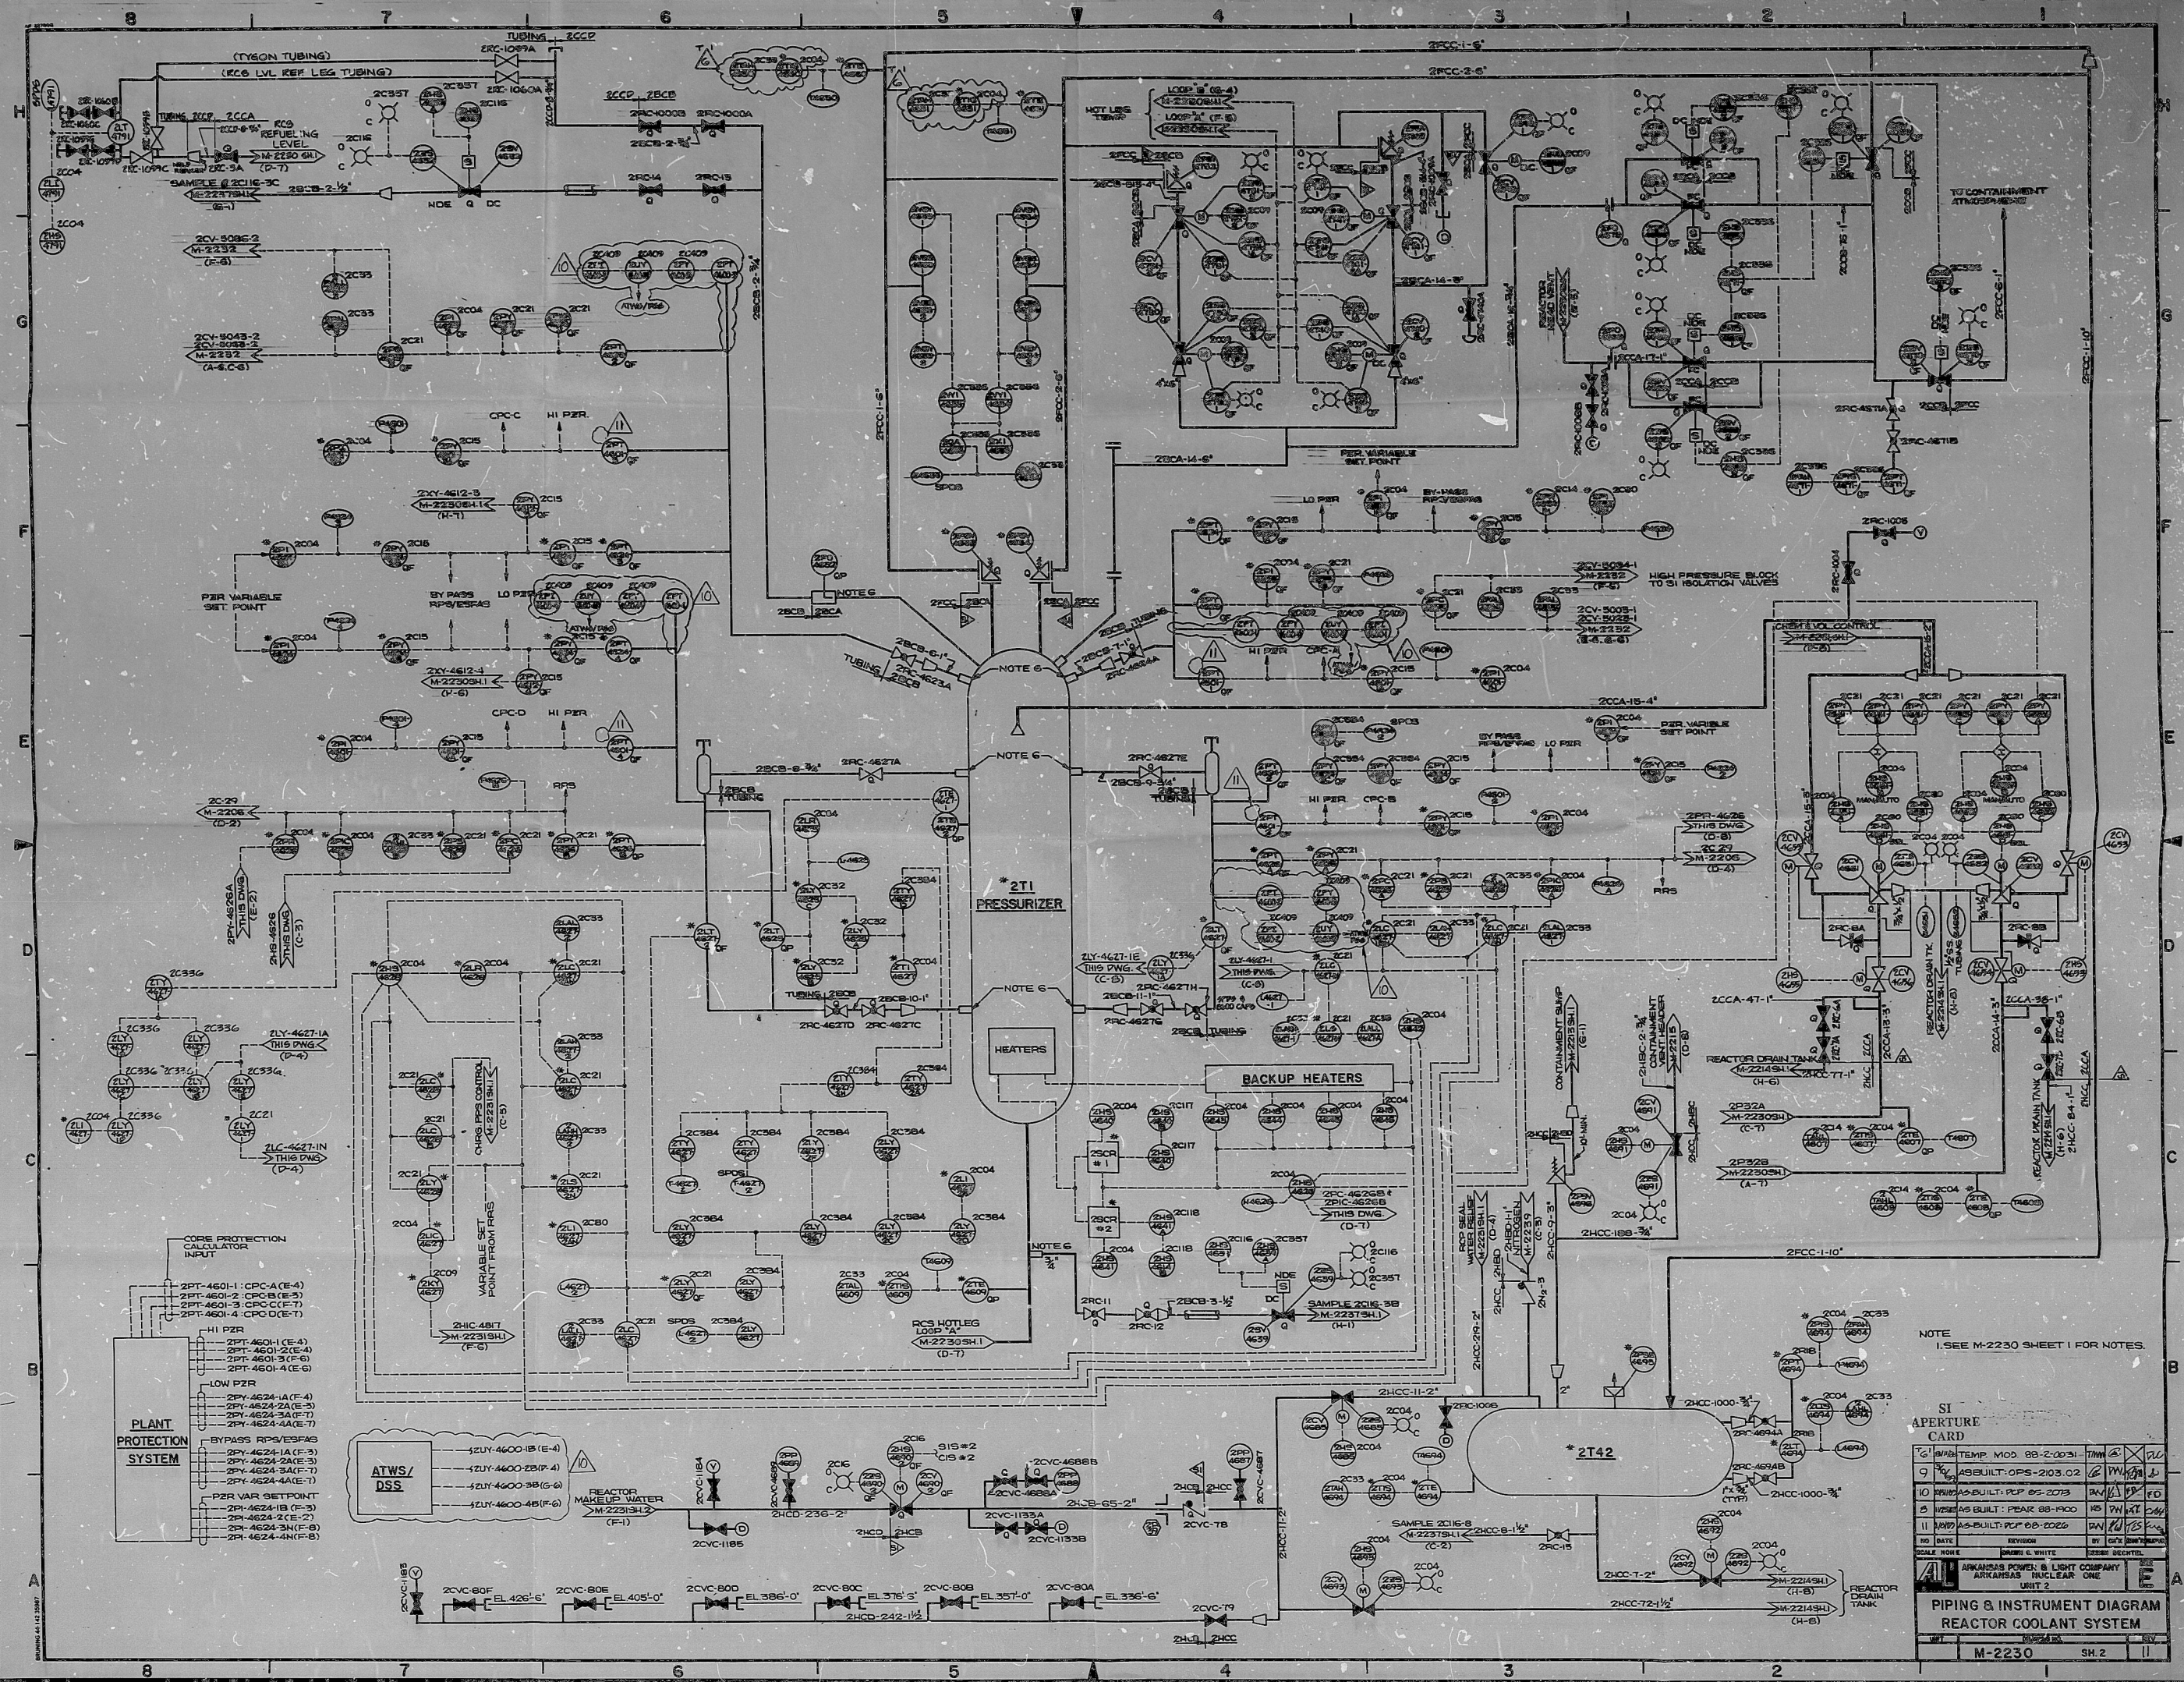

NOTE
1. SEE M-2230 SHEET 1 FOR NOTES.

SI APERTURE CARD	
9	AS-BUILT: MOD. 88-20031-TMM
10	AS-BUILT: OPS-2103.02
11	AS-BUILT: PIP. 88-2073
12	AS-BUILT: PIP. 88-1900
13	AS-BUILT: PIP. 88-2026
14	AS-BUILT: PIP. 88-2026
ARKANSAS POWER & LIGHT COMPANY
ARKANSAS NUCLEAR ONE
UNIT 2
PIPING & INSTRUMENT DIAGRAM
REACTOR COOLANT SYSTEM
M-2230 SH. 2

PDR RIDS

9001300357

