


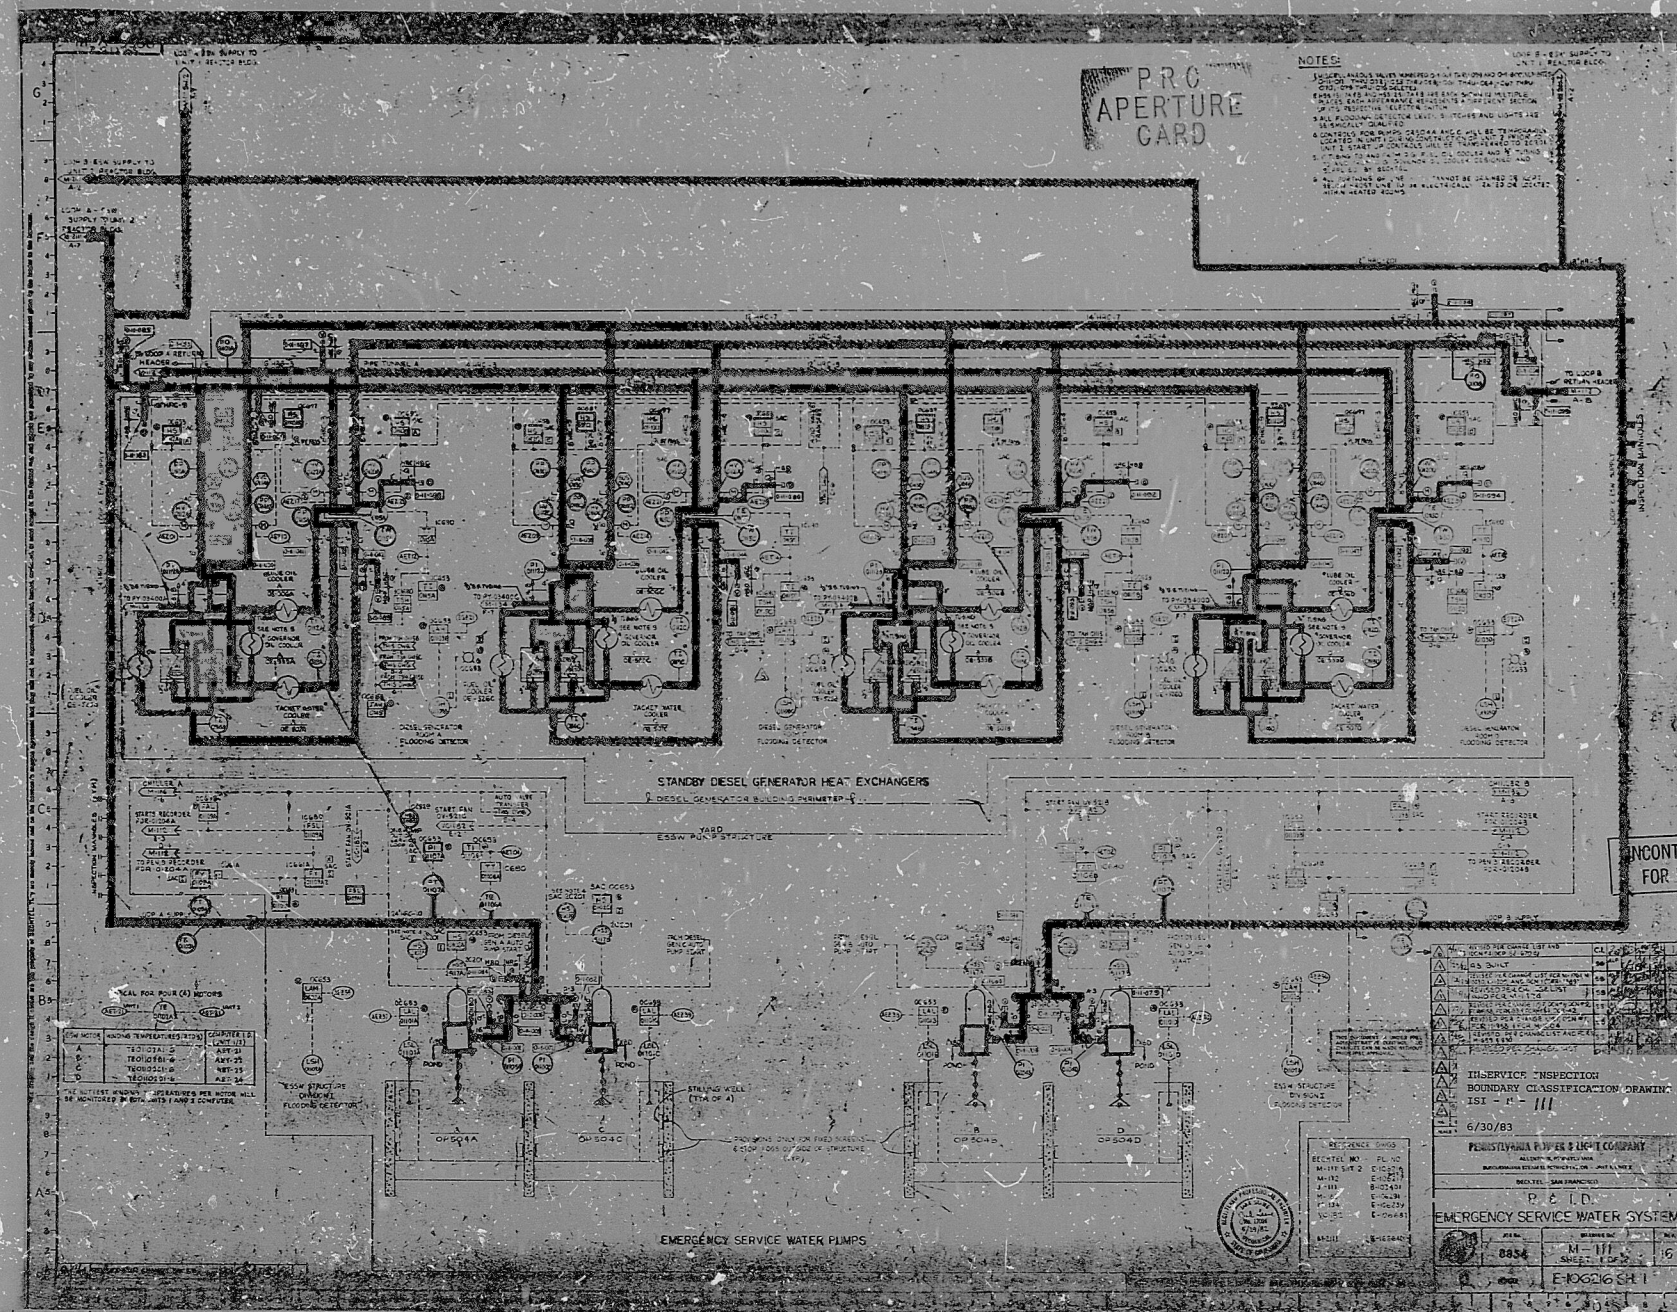

UNCONTROLLED DOCUMENT
FOR REFERENCE ONLY



EMERGENCY SERVICE WATER SYSTEM

RIDS

8308150411

