


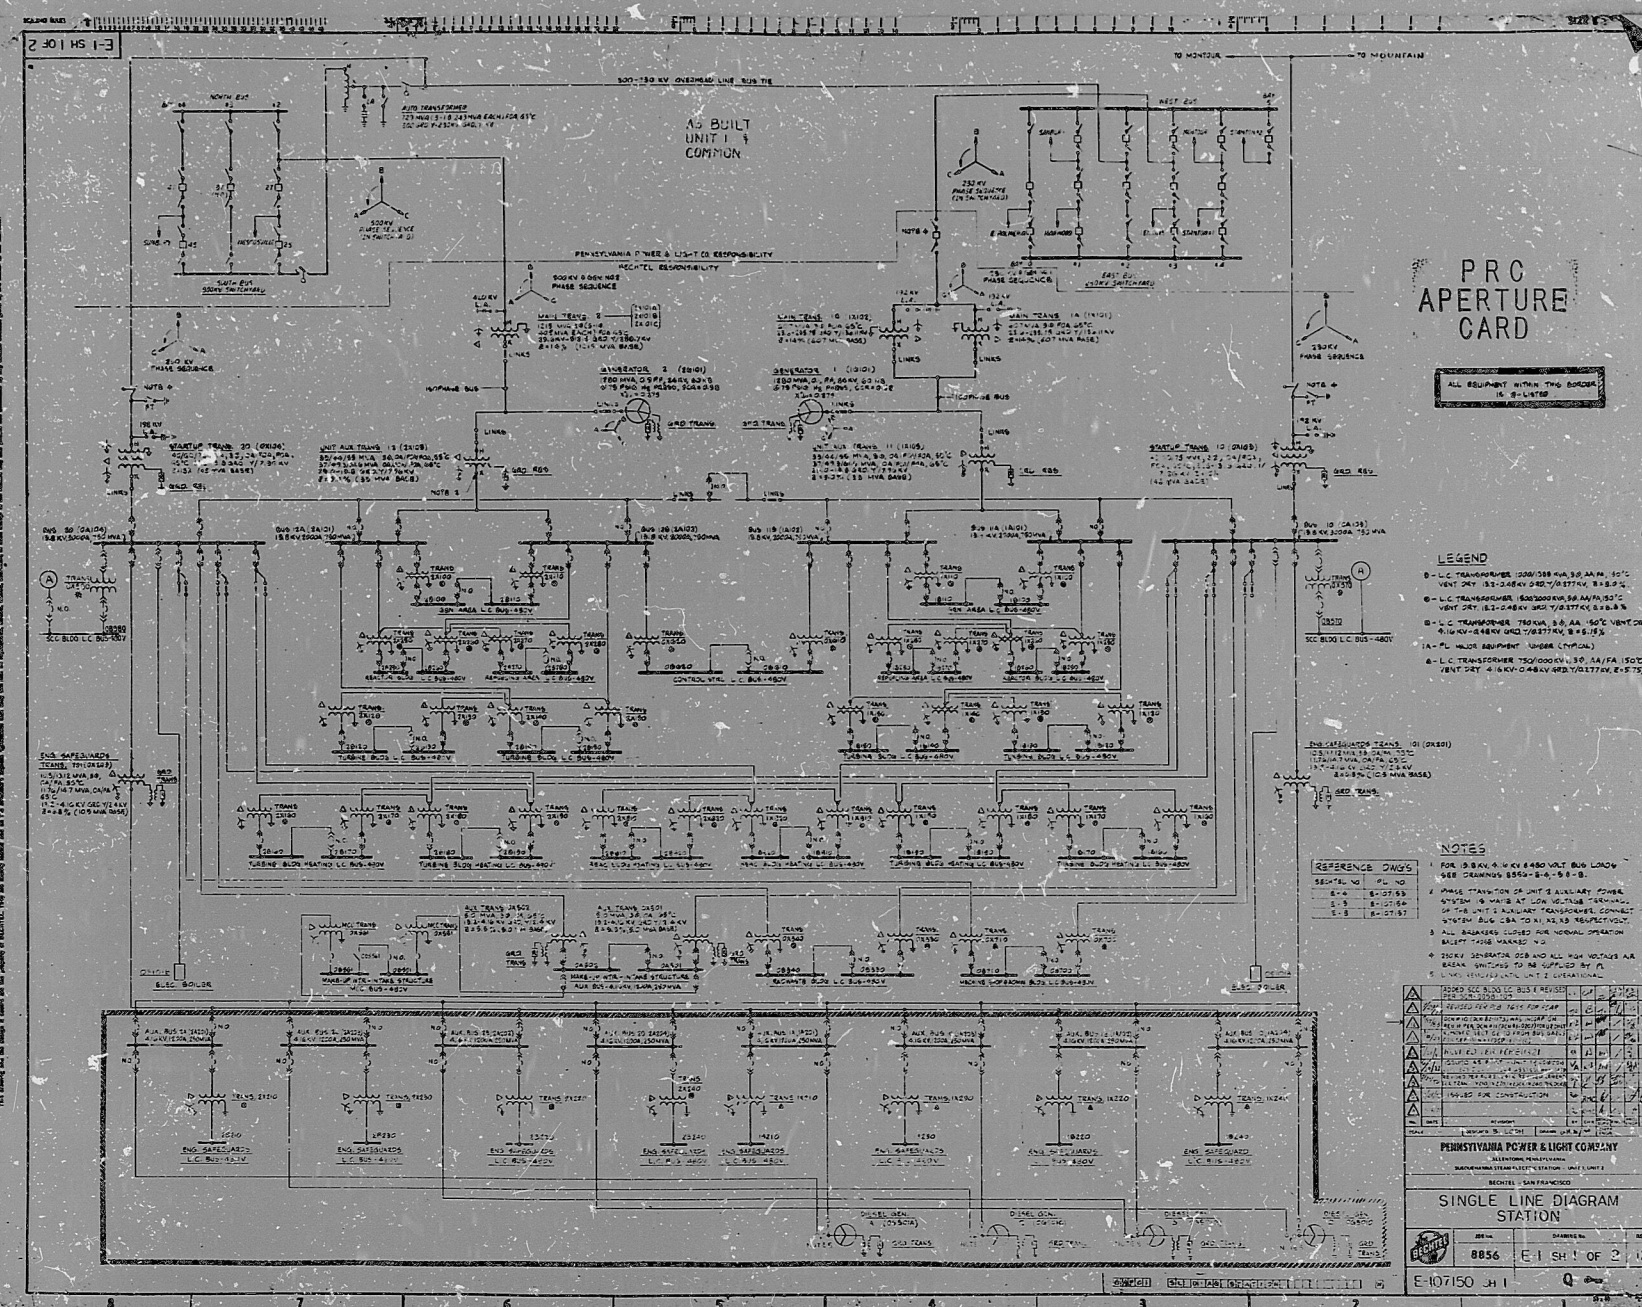

RIDS

8308150461

