5GW1640-SM-16 | E | 88

NOTES:

1. FOR GENERAL NOTES, REFERENCE DRAWINGS, AND SYMBOLS SEE [illegible].
2. THE CONTROL POWER PANEL FOR THE MSS DRAIN TANK VALVES (1SM-IFSV-327, 328, 333, & 334) IS LOCKED IN THE DE-ENERGIZED STATE DURING NORMAL PLANT OPERATIONS.
3. REFER TO TARGET ROCK CORPORATION DRAWINGS [illegible] & [illegible] ON CONTRACT [illegible] (FILE [illegible]).
4. THE USE OF REED SWITCHES FOR VALVE LIMIT INDICATION PRECLUDES THE OVERLAPPING OF ZONE INDICATORS (BOTH INDICATING LIGHTS PER VALVE POSITION WILL BE OFF WHEN THE VALVE IS IN MID-TRAVEL).

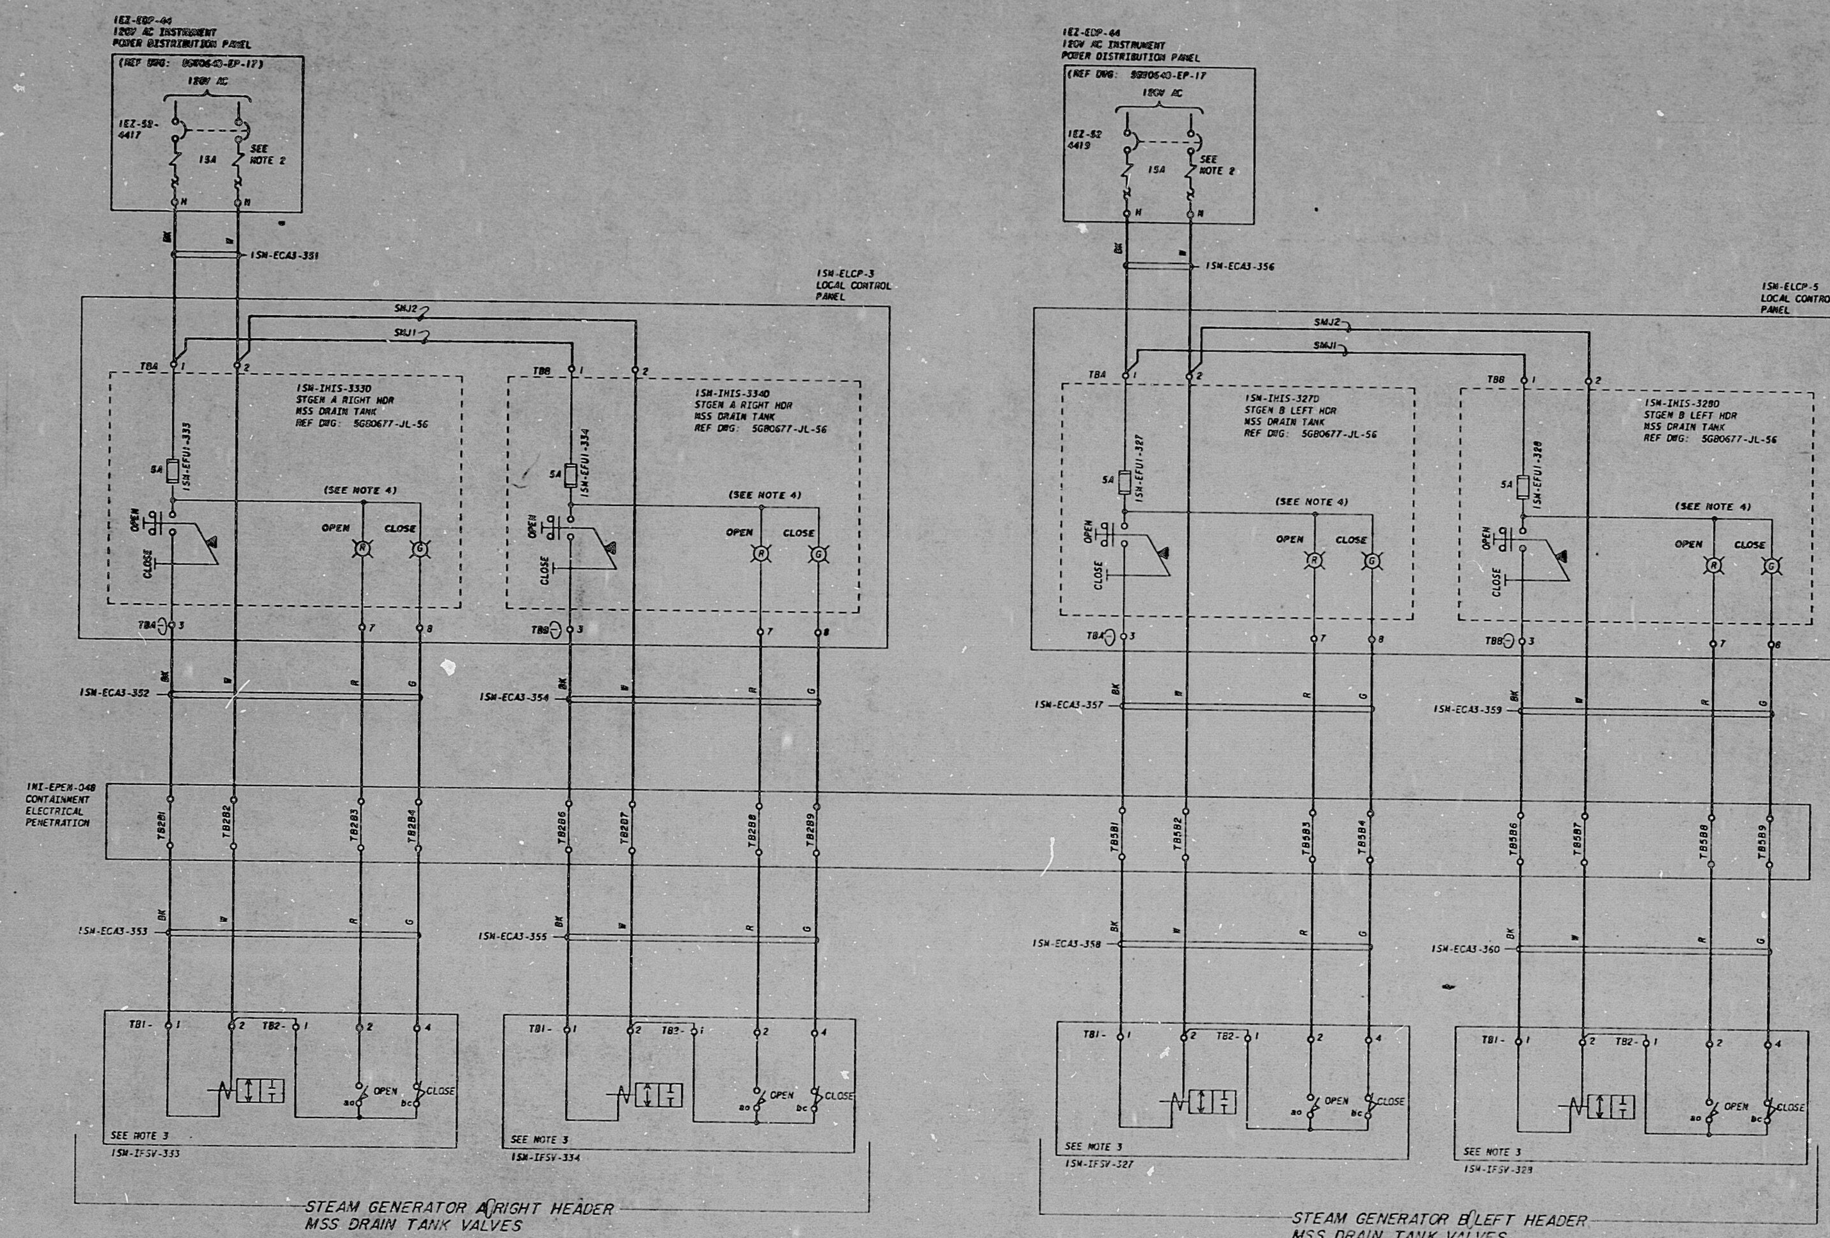

PRC APERTURE CARD

2	SI	10-15-80					JLS	
MINOR CHANGES								
1	SI	7-7-80					JLS	
CHANGED PENETRATION TERM.; CHANGED "Q" DESIGNATION TO "N."								
REV NO	ECN NO.	DATE	DSGN	DRFTG	CHKD	SUPV	ENGR	APPD

DSGN R. F. Atkinson
DRFTG D. Q. Fary
CHKD W. C. Thomas
SUPV E. C. Matthews
ENGINEER M. W. Stevens

SCALE EXCEPT AS NOTED

GENERAL
UNIT 1

SCHEMATIC DIAGRAM
MAIN & REHEAT STEAM SYSTEM

BELLEFONTE NUCLEAR PLANT
TENNESSEE VALLEY AUTHORITY
DIVISION OF ENGINEERING DESIGN

N

SUBMITTED M. W. Stevens
RECOMMENDED
APPROVED R. M. Hodges

INSPECTED AND APPROVED FOR ISSUE

KNOXVILLE 8-13-77 88 E 5GW1640-SM-16 R2

RECORD DRAWING AS CONSTRUCTED

RIDS

8204130453

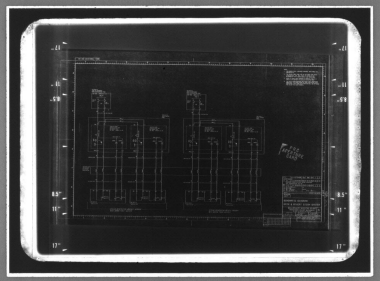

M*M 5824 — FILMSORT* Brand Aperture & Camera Cards and DUPLICARD* Brand Copy Cards — Product of 3M Company, St. Paul, Minn.