


06-NS-0191M95 2

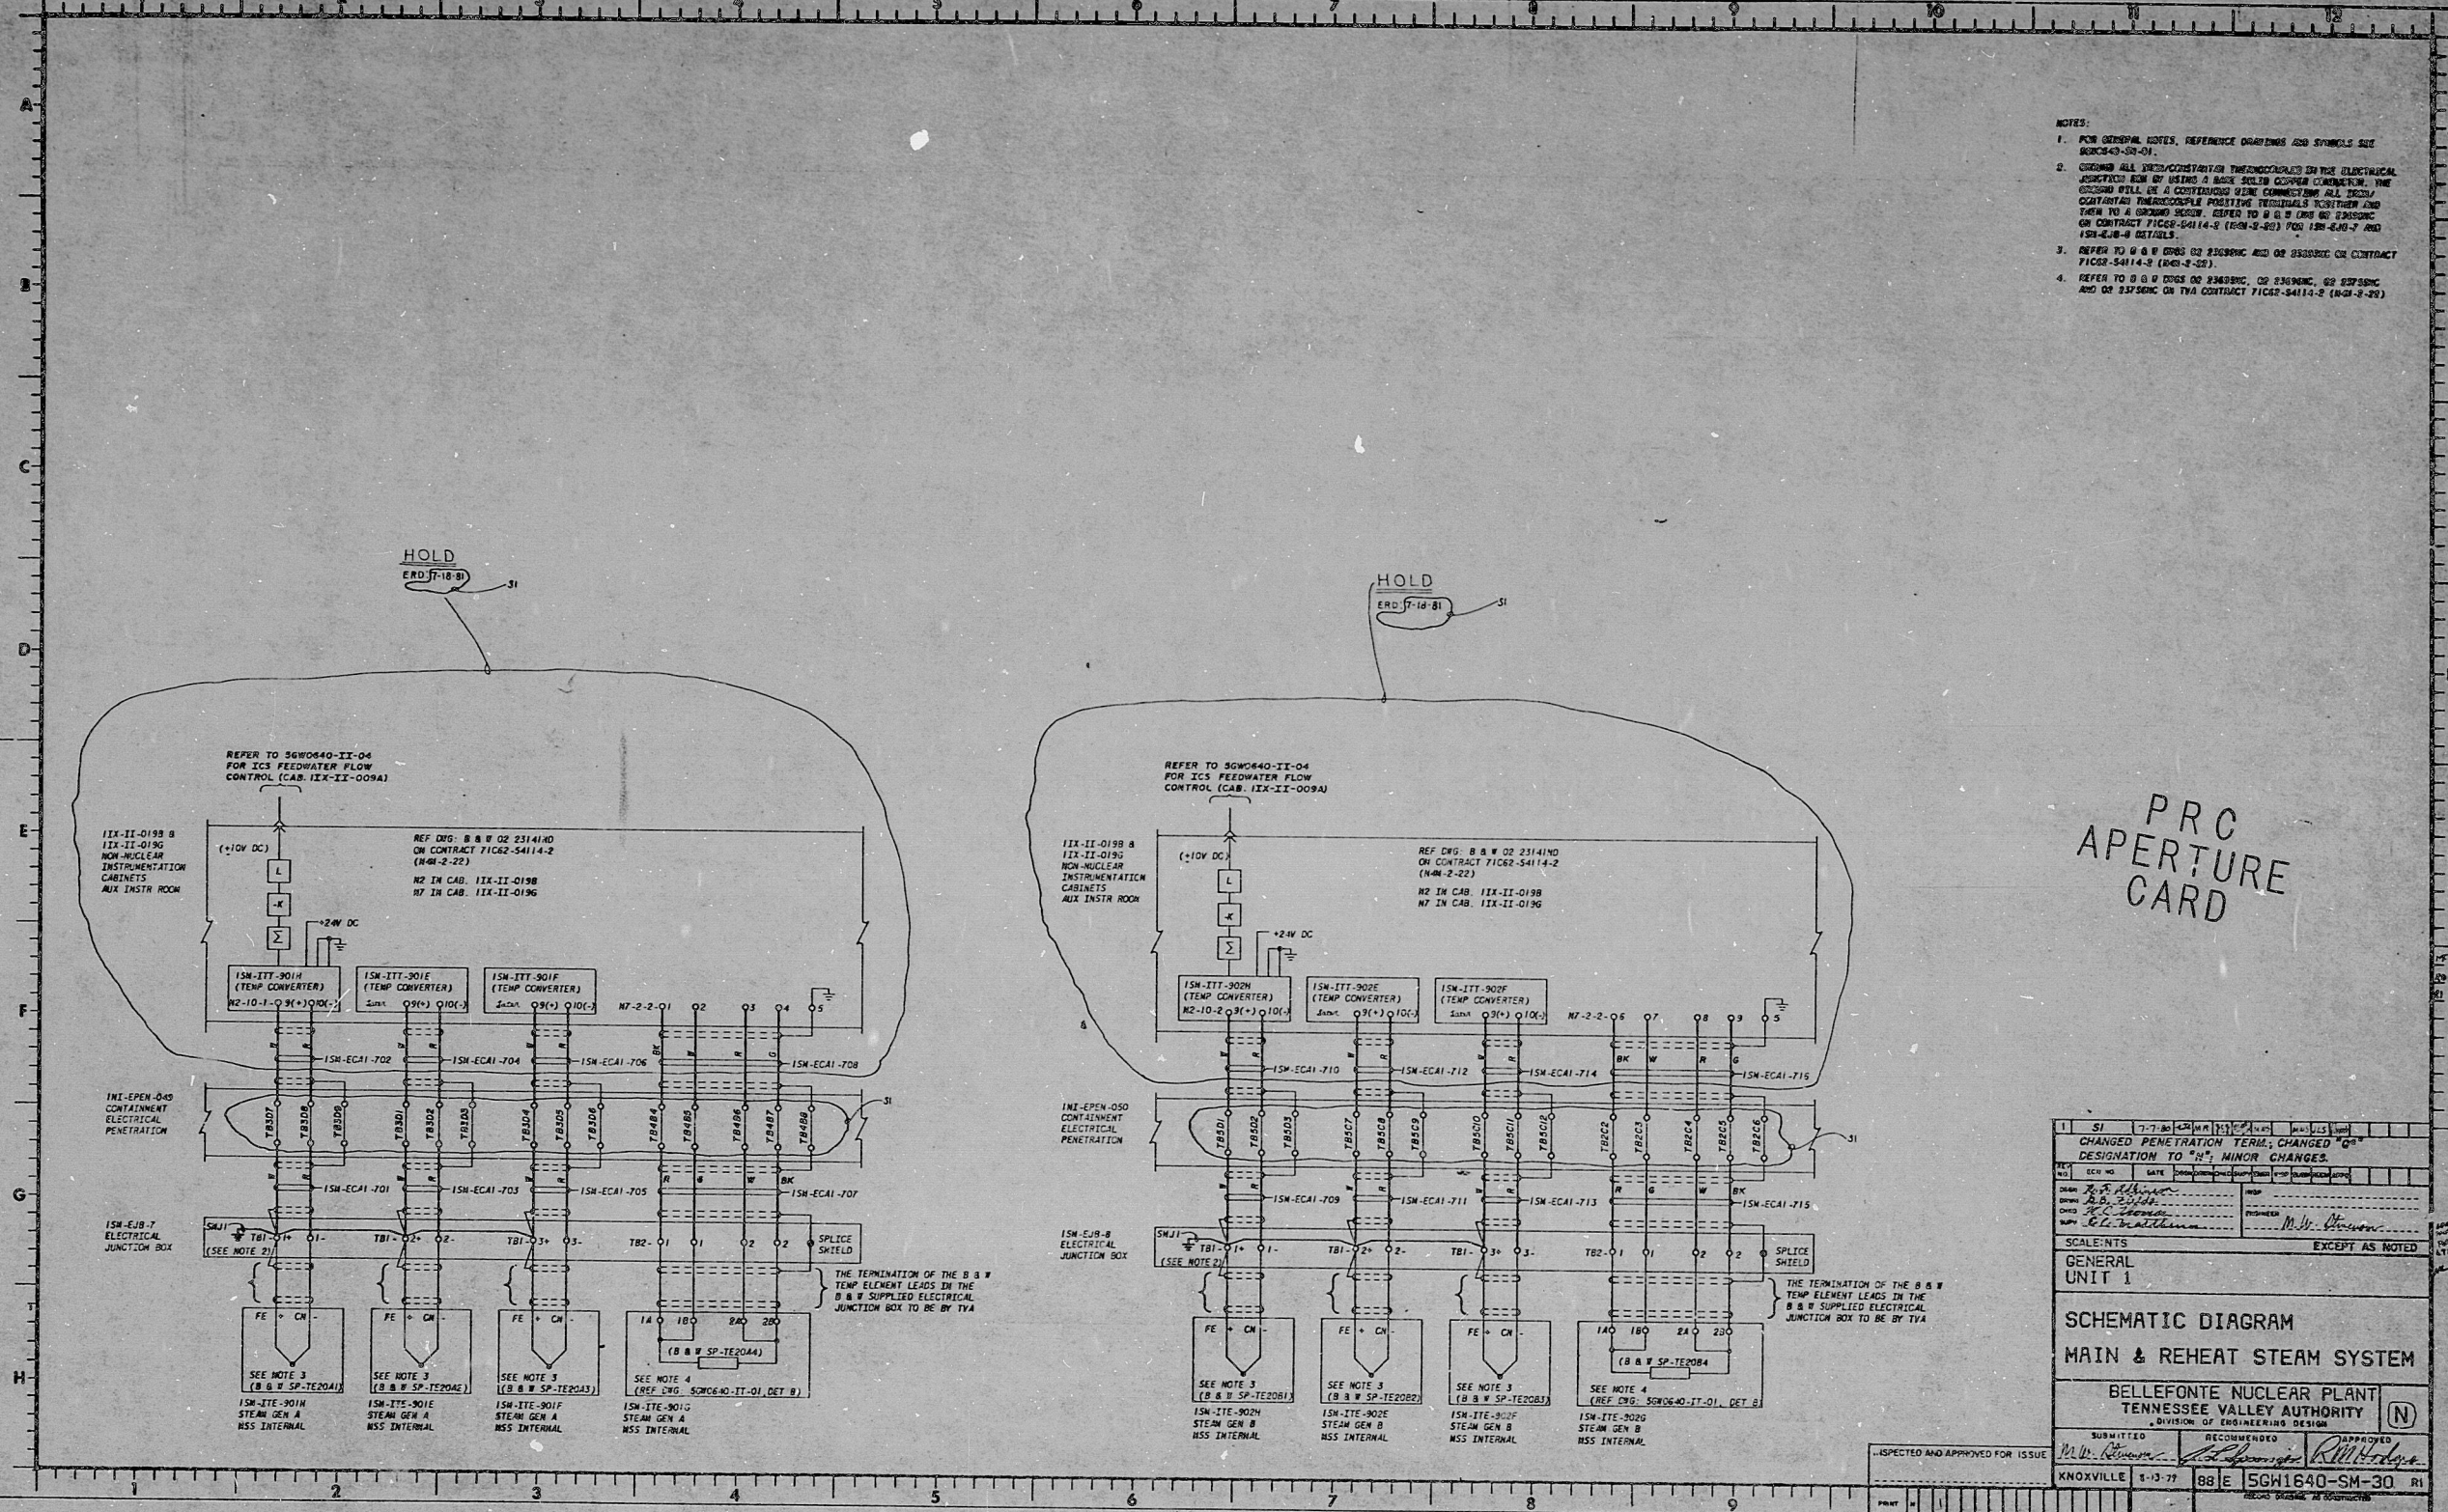

- NOTES:

PRC
APERTURE
CARD

CHANGED PENETRATION TERM. CHANGED TO "H" MINOR CHANGES	
DESIGN NO.	DATE
DESIGNER	APPROVED
CHECKED	REVIEWED
EXCEPT AS NOTED	
SCHEMATIC DIAGRAM	
MAIN & REHEAT STEAM SYSTEM	
BELLEFONTE NUCLEAR PLANT	
TENNESSEE VALLEY AUTHORITY	
DIVISION OF ENGINEERING DESIGN	
SUBMITTED	RECOMMENDED
APPROVED	APPROVED
KNOXVILLE	8-13-77
88E	SGH1640-SM-30 RI

RIDS

8204130469

