


60-81-0490M9 3 00

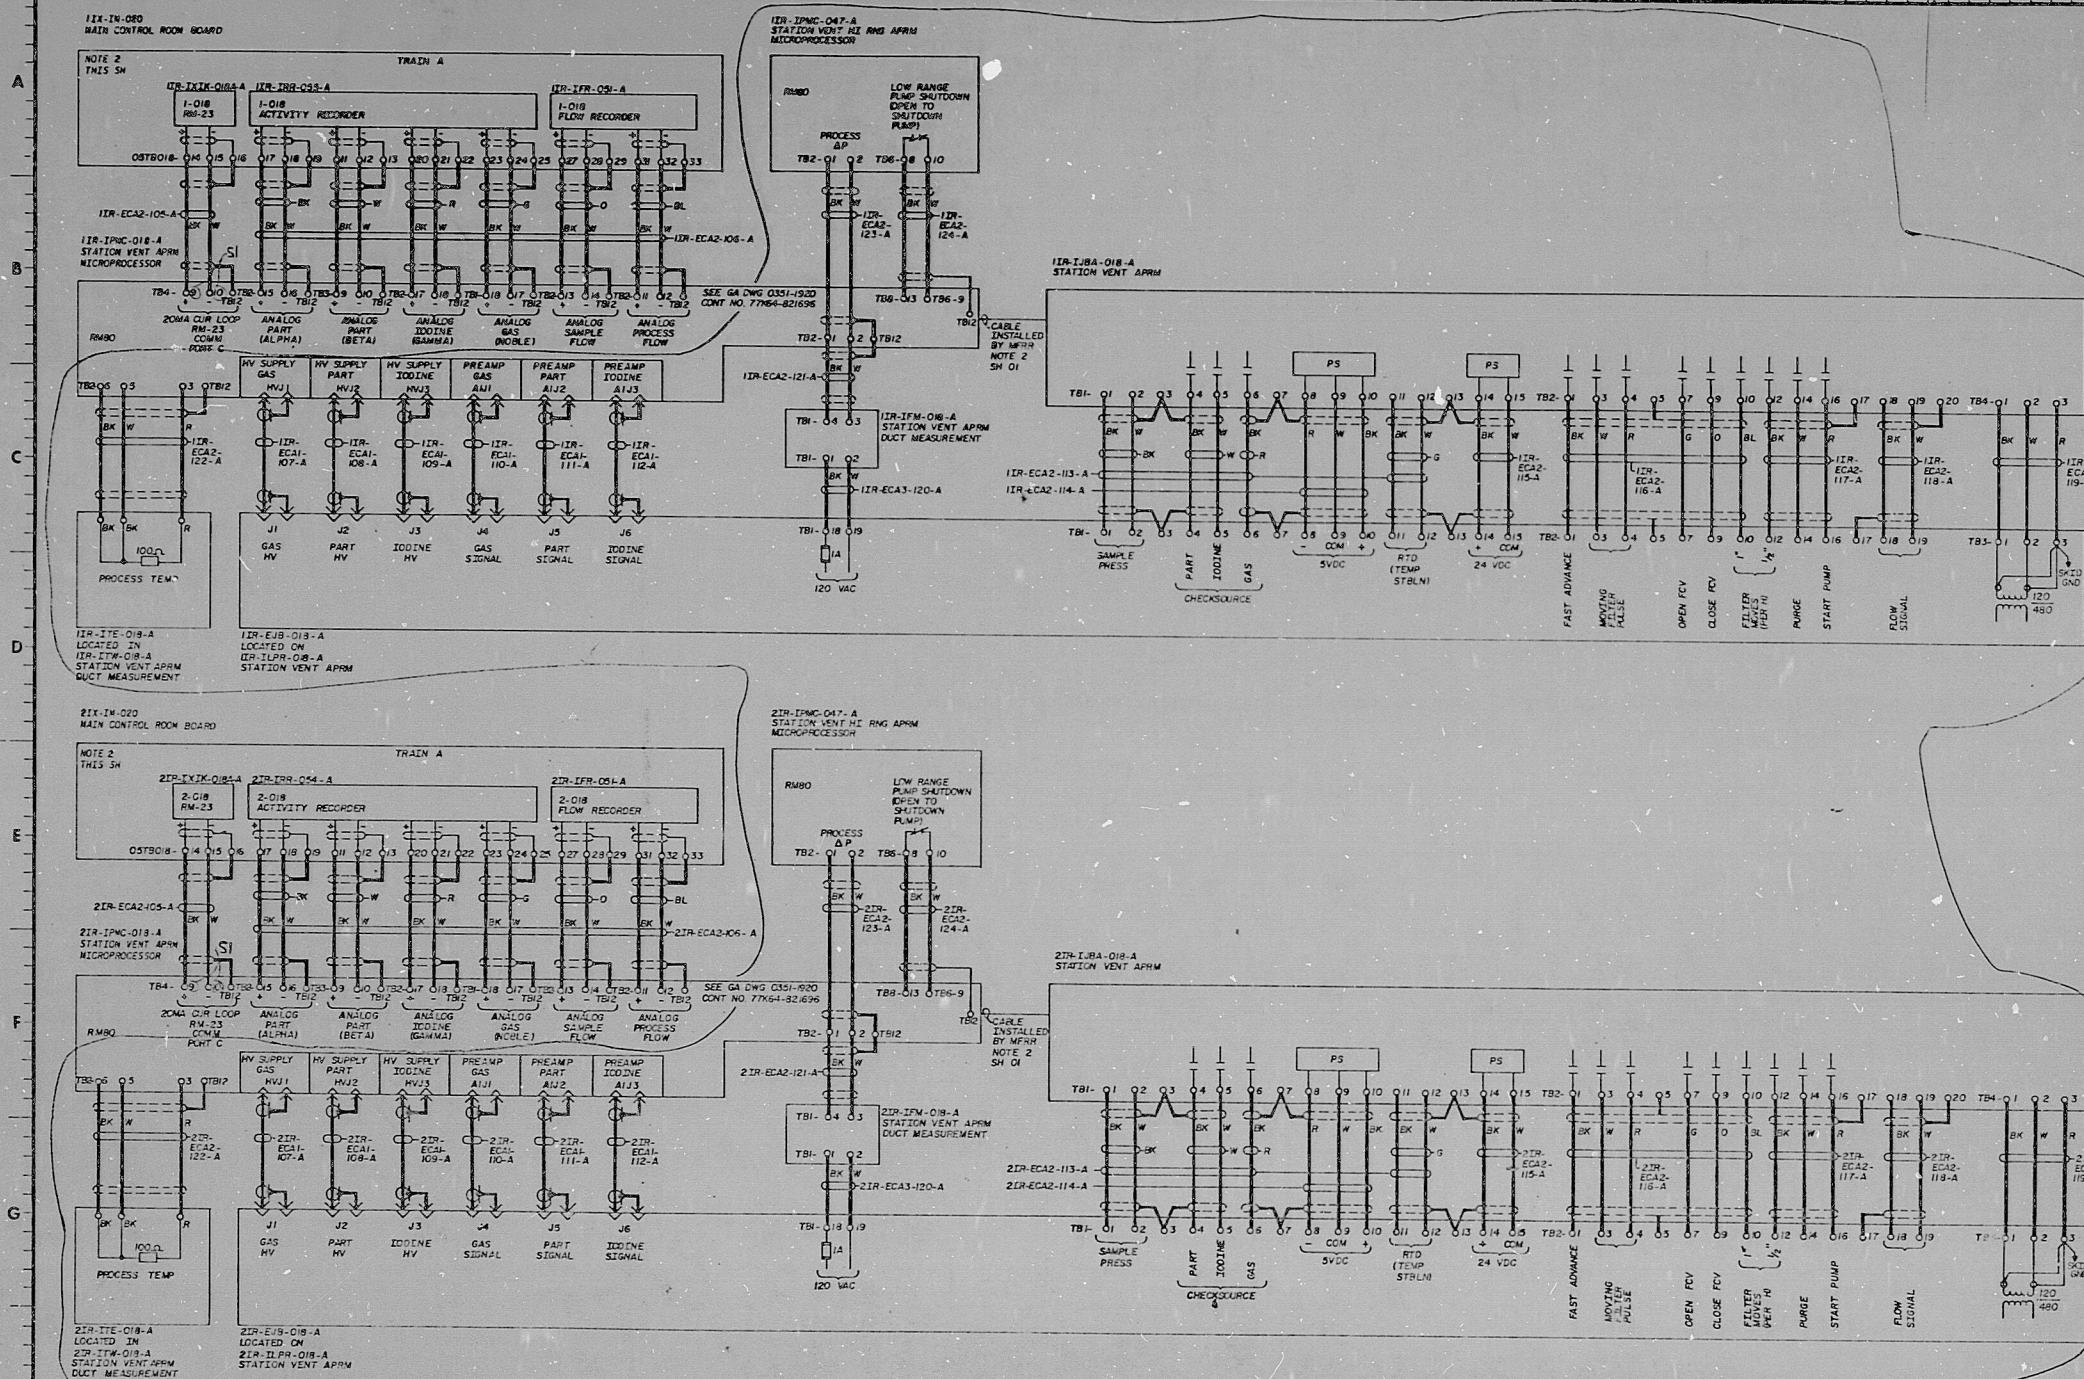

NOTES:
1. SEE SCHEMATIC-IR-01 FOR GENERAL NOTES, REFERENCE DRAWINGS, AND SYMBOLS.
2. FOR MAIN CONTROL ROOM BOARD INTERNAL WIRING SEE GA ENG ELO301-0014 ON CONTRACT NUMBER 77454-82188

P.R.C.
APERTURE
CARD

REVISIONS	
NO. (CIVIL)	DATE
NO. (ELEC)	DATE
NO. (MECH)	DATE
INSPECTED AND APPROVED FOR ISSUE	
BELLEFONTE NUCLEAR PLANT TENNESSEE VALLEY AUTHORITY DIVISION OF ENGINEERING DESIGN SUBMITTED: <i>[Signature]</i> RECOMMENDED: <i>[Signature]</i> APPROVED: <i>[Signature]</i> KNOXVILLE, TN 37604-5001 83 E 5640640-IR-03 RI	

RIDS

8204130517

