




RIDS

8204130549

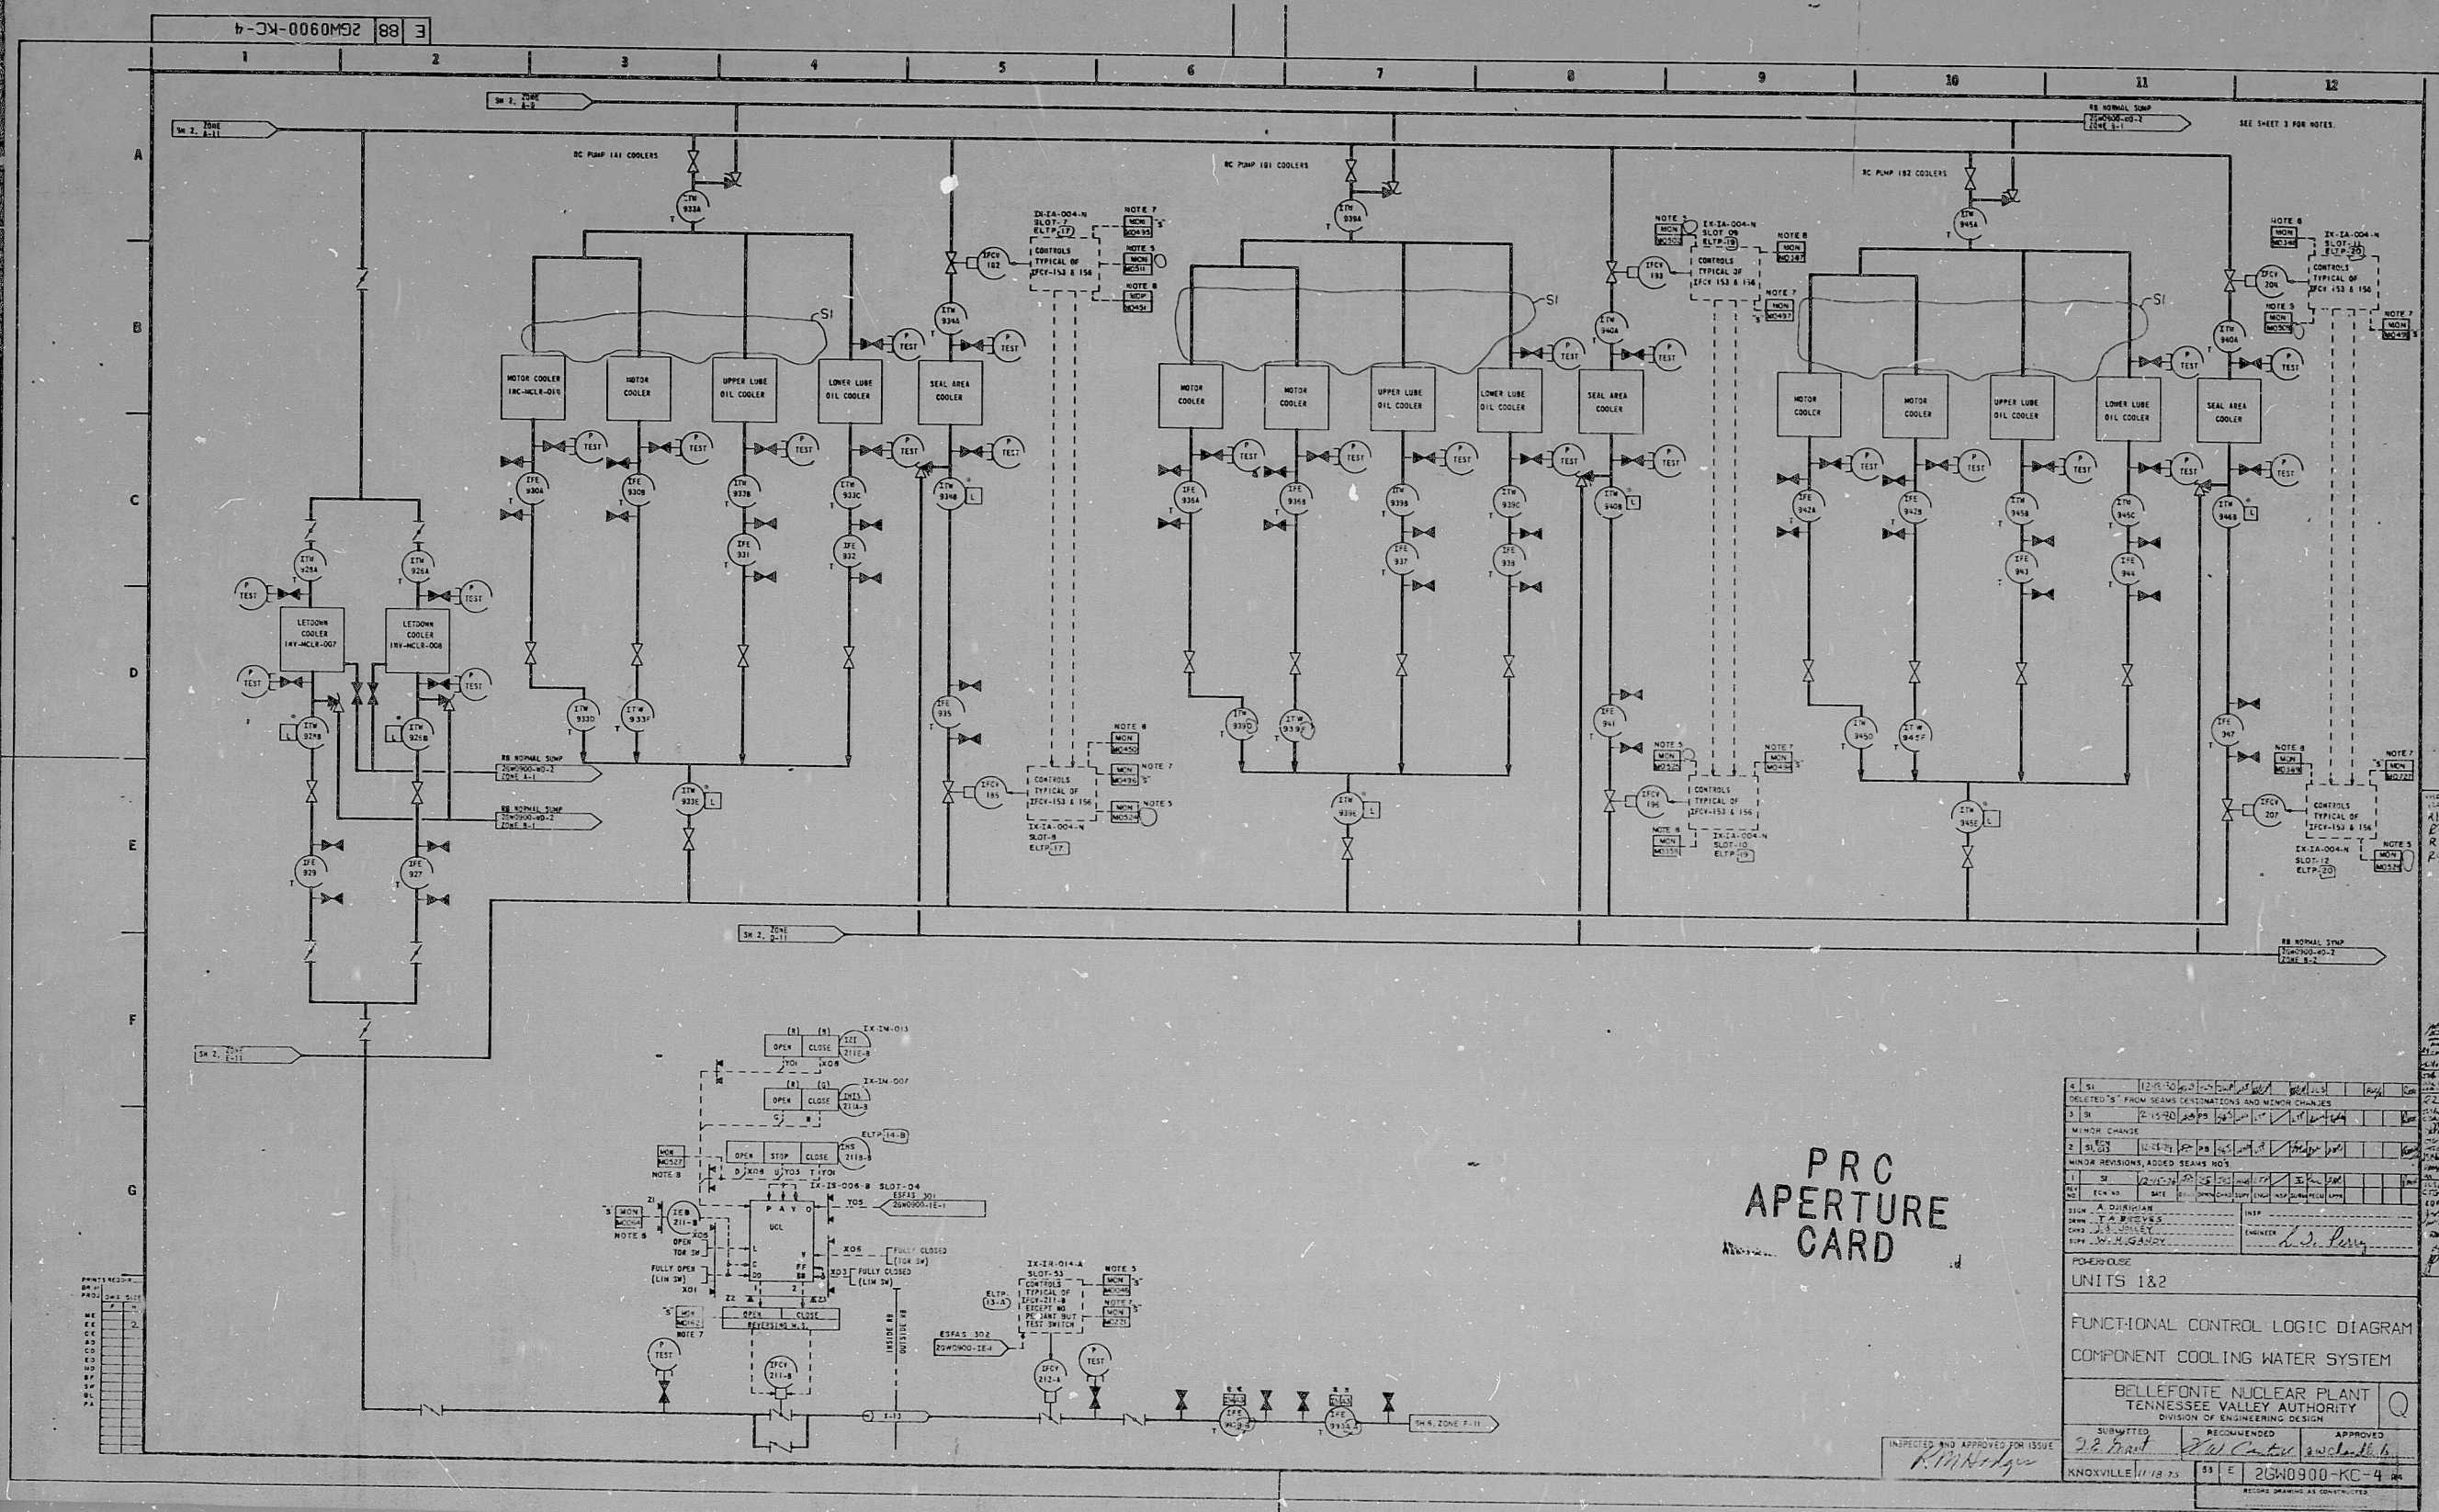