


MPL NO 1H13-2725J J-1472P

- NOTES:
1. THIS DRAWING SUPERSEDES DRAWING J-1410
 2. SYMBOLS INDICATED CHANGES WHICH REQUIRE FIELD MODIFICATION

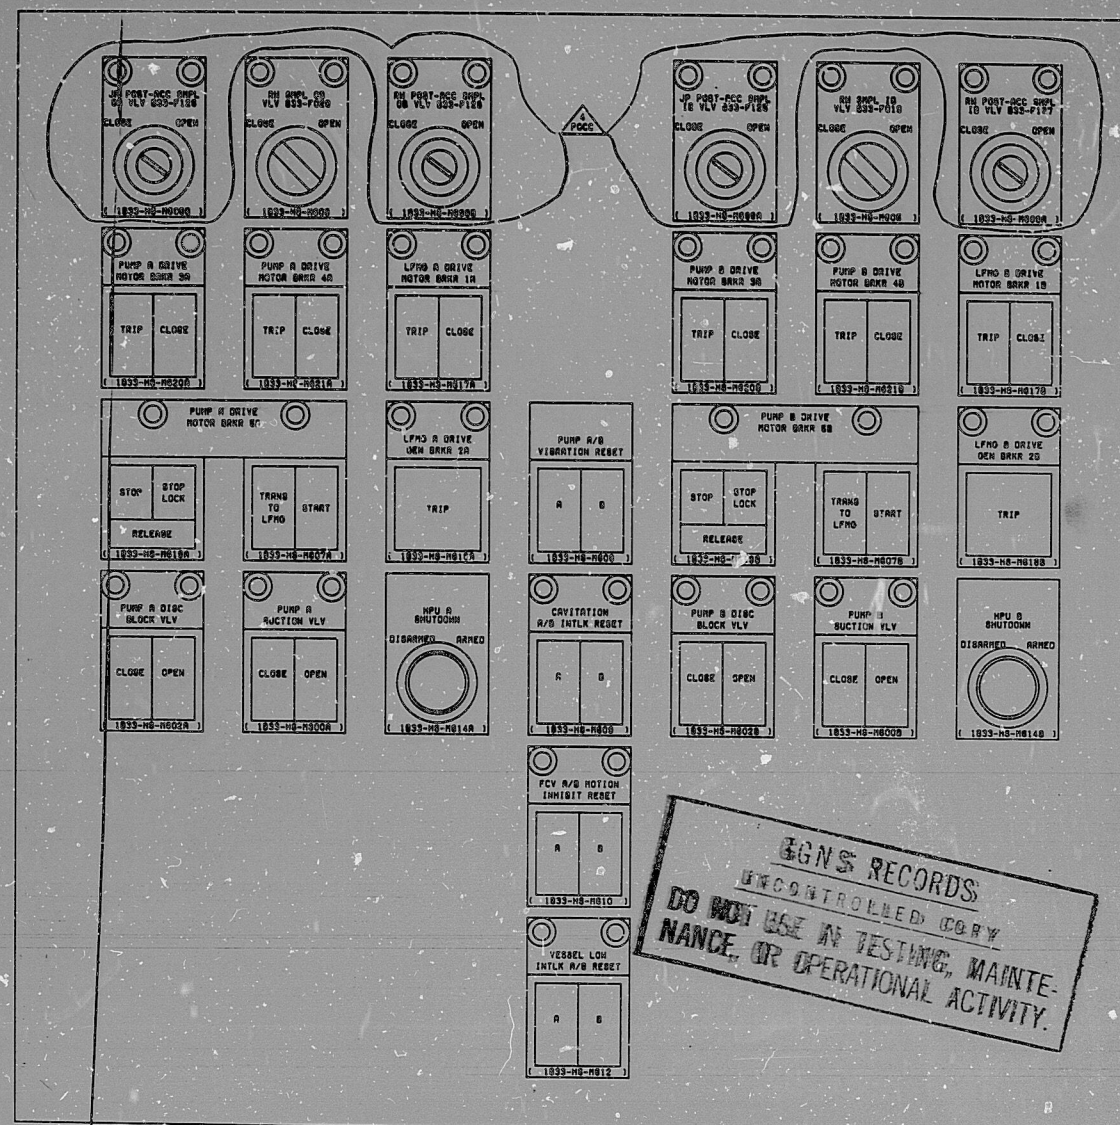

TERA
APERTURE
CARD

NO	DATE	REVISIONS	BY	CHK	DATE	CHK	DATE	CHK	DATE
1	10/27/80	1	JN	DL	10/27/80	1	JN	DL	10/27/80
SCALE: FULL									
BECHTEL DALLAS, TEXAS, MARYLAND									
MISSISSIPPI POWER & LIGHT COMPANY GRAND DULF NUCLEAR STATION UNITS 1 & 2									
PANEL ARRANGEMENT OPERATOR'S CONTROL CONSOLE 1H13-P680-3C									
NO	DATE	REVISIONS	BY	CHK	DATE	CHK	DATE	CHK	DATE
1	10/27/80	1	JN	DL	10/27/80	1	JN	DL	10/27/80

MPL NO 1H13-2725J

9645-

J-1472P

0

30X

RIDS-PDR

8103020236

DDAINT

NRCA ANPGF IB445

" " IB422

