




RIDS

8308180663

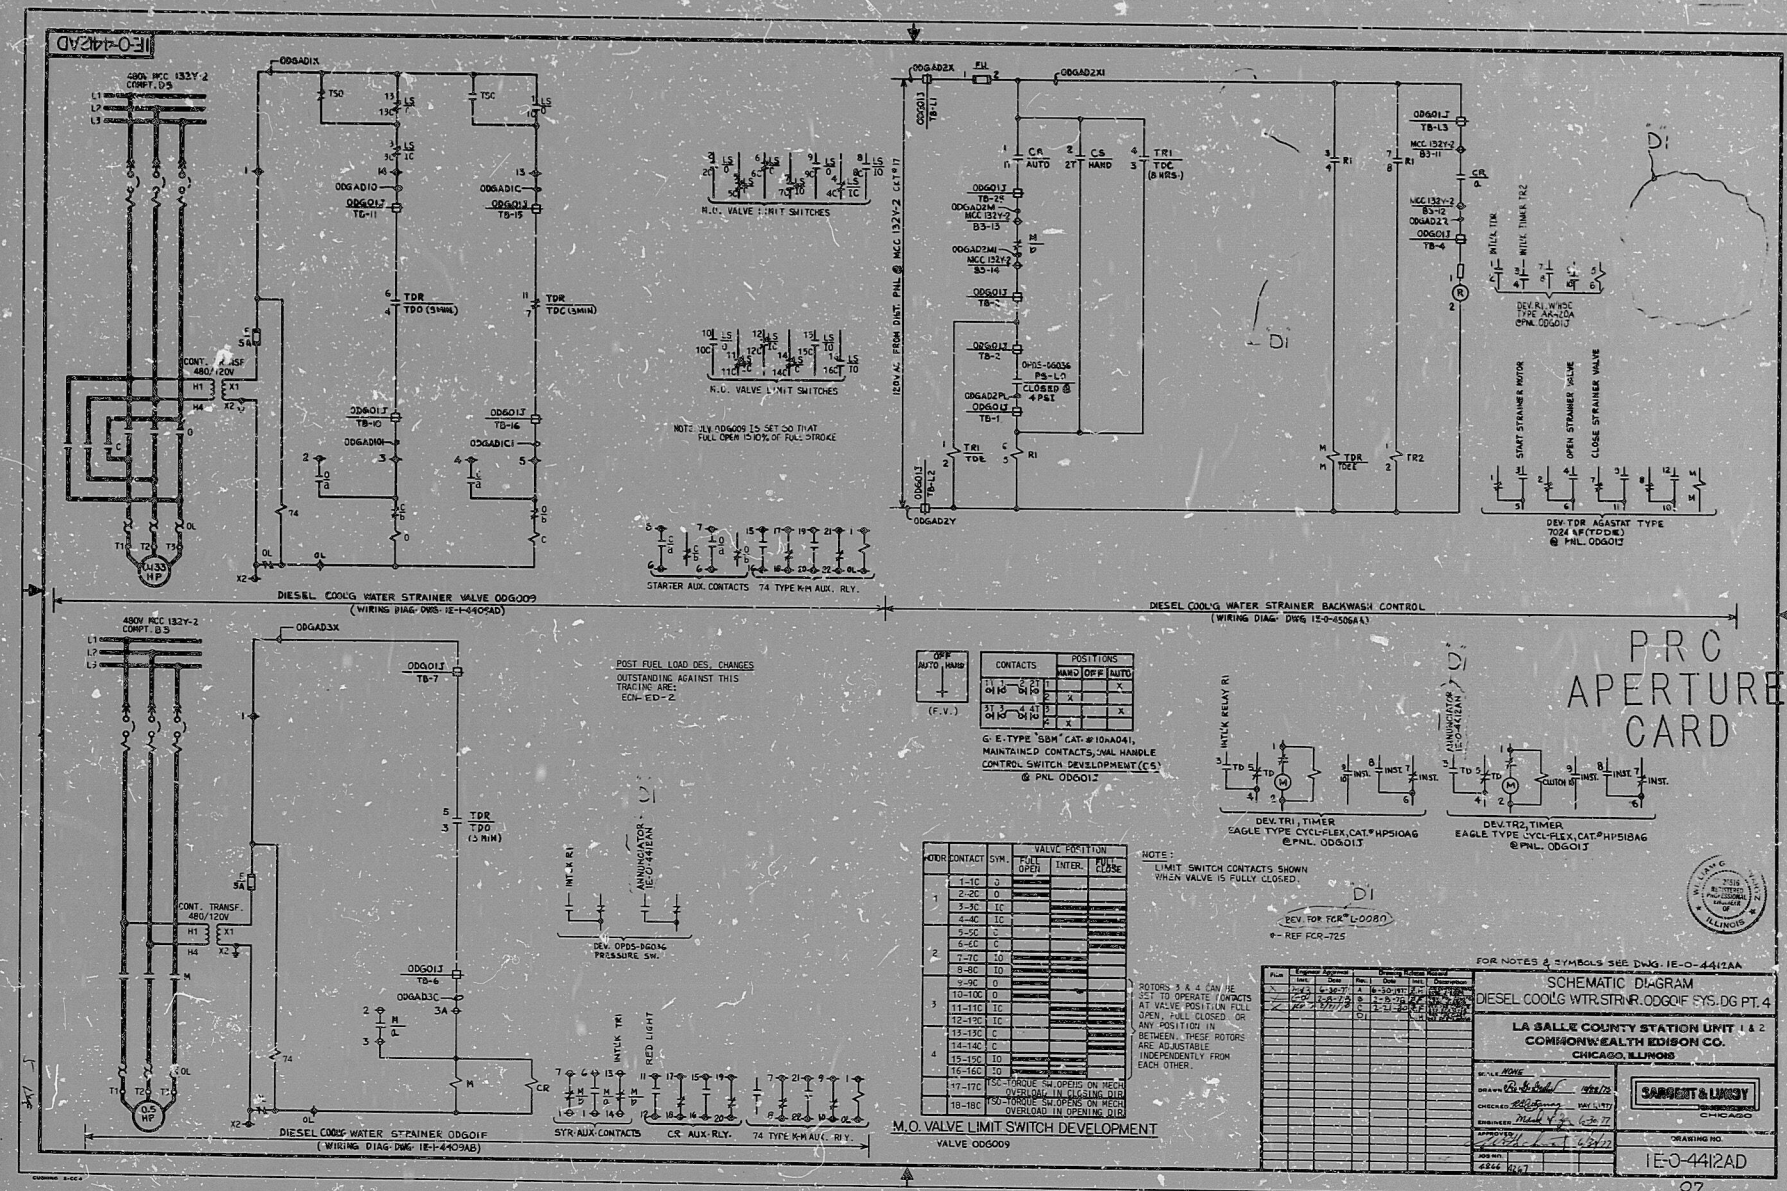