


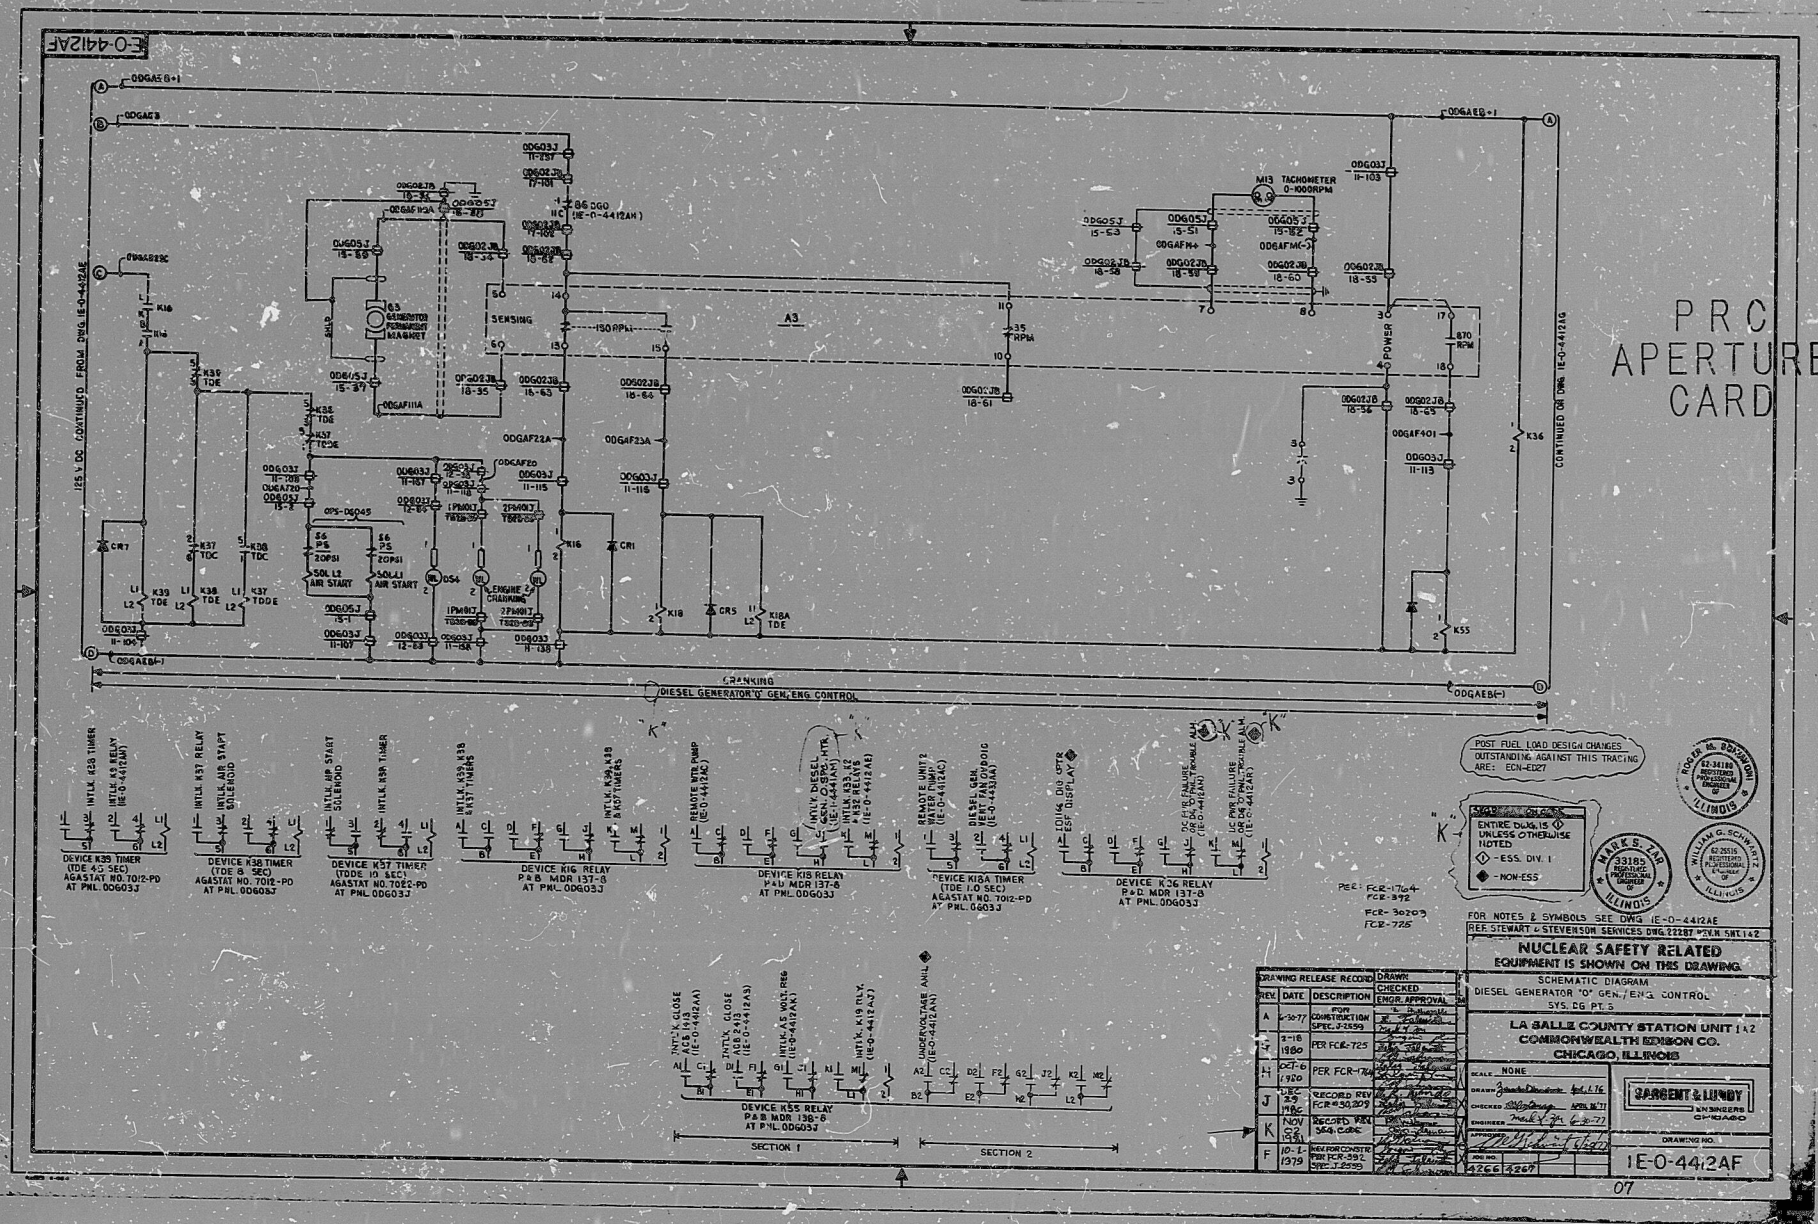

PRC
APERTURE
CARD

FOR NOTES & SYMBOLS SEE DWG. IE-0-442AE

**NUCLEAR SAFETY RELATED
EQUIPMENT IS SHOWN ON THIS DRAWING.**

SCHEMATIC DIAGRAM
DIESEL GENERATOR 'D' GEN/ENG CONTROL
SYS. CG PT. 5

LA SALLE COUNTY STATION UNIT 1A2
COMMONWEALTH EDISON CO.


DRAWING NO.: IE-0-442AF
07

RIDS

8308480669

