


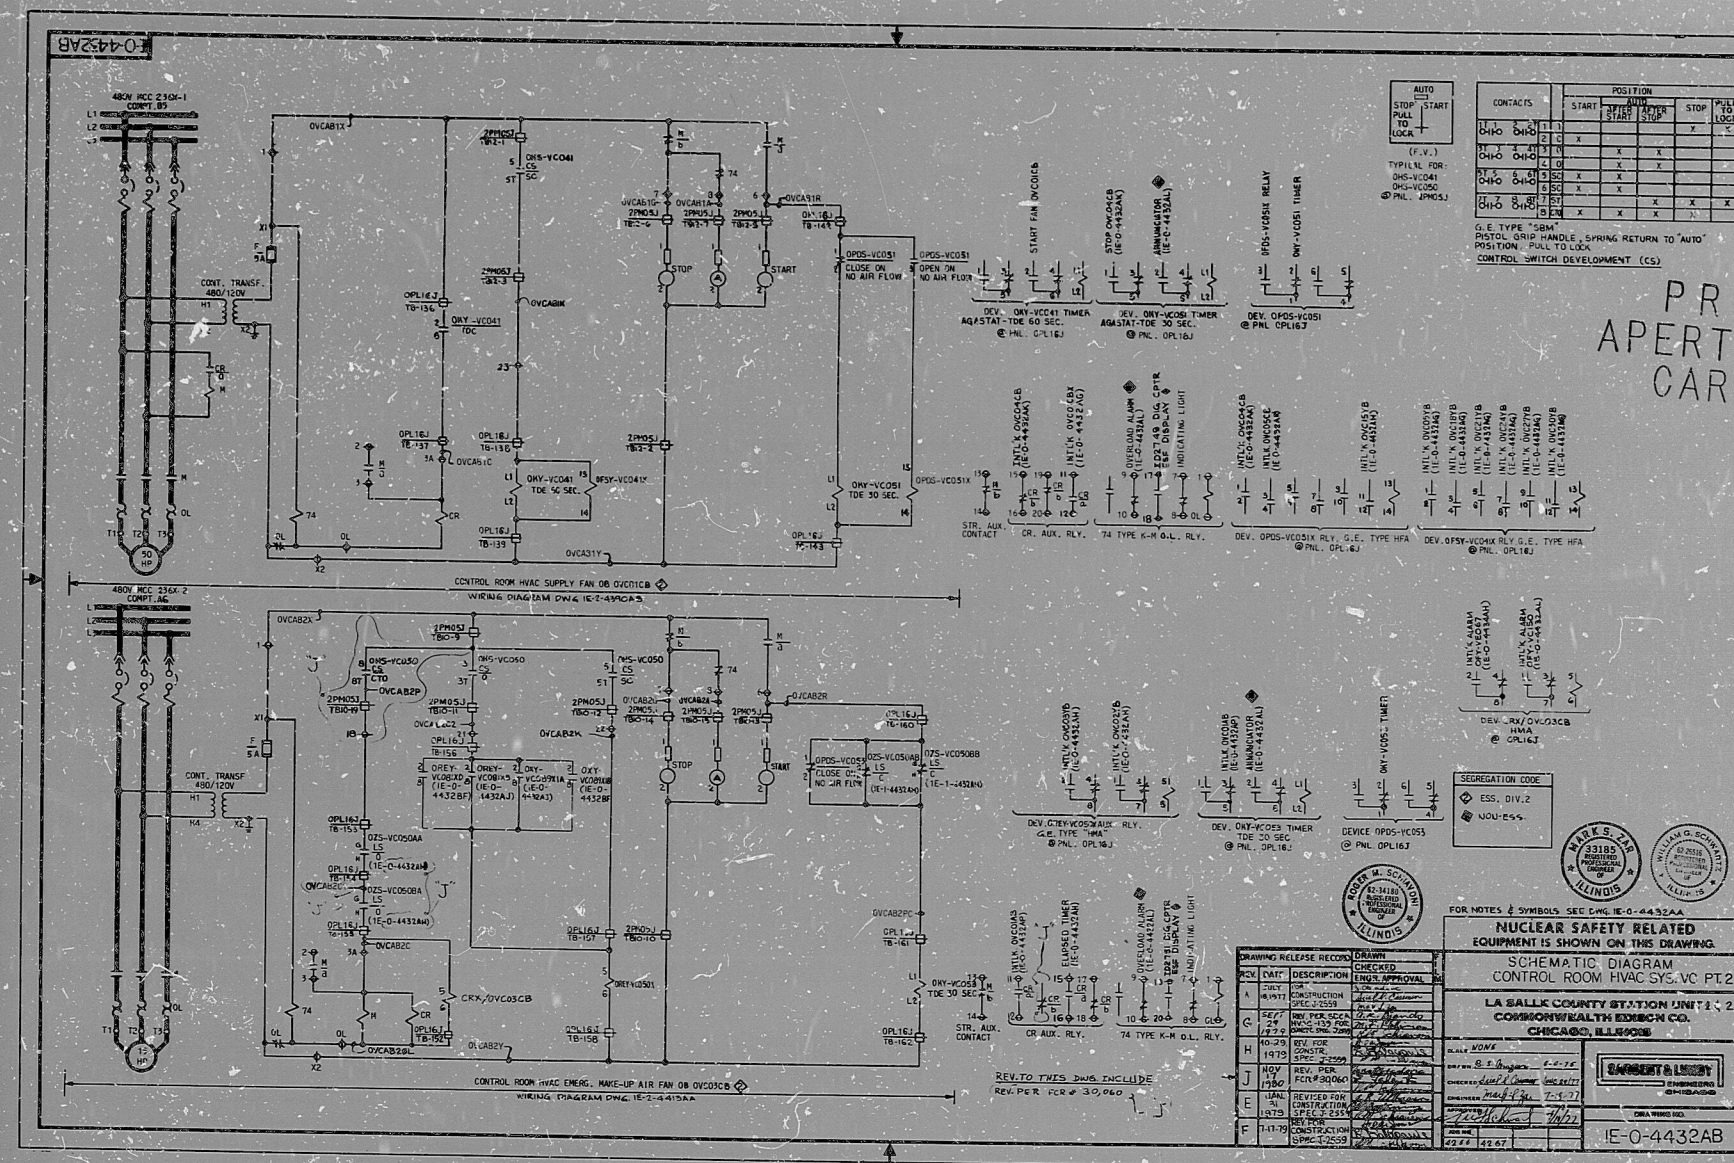

PROC
APERTURE
CARD

RIDS

8308180727

