


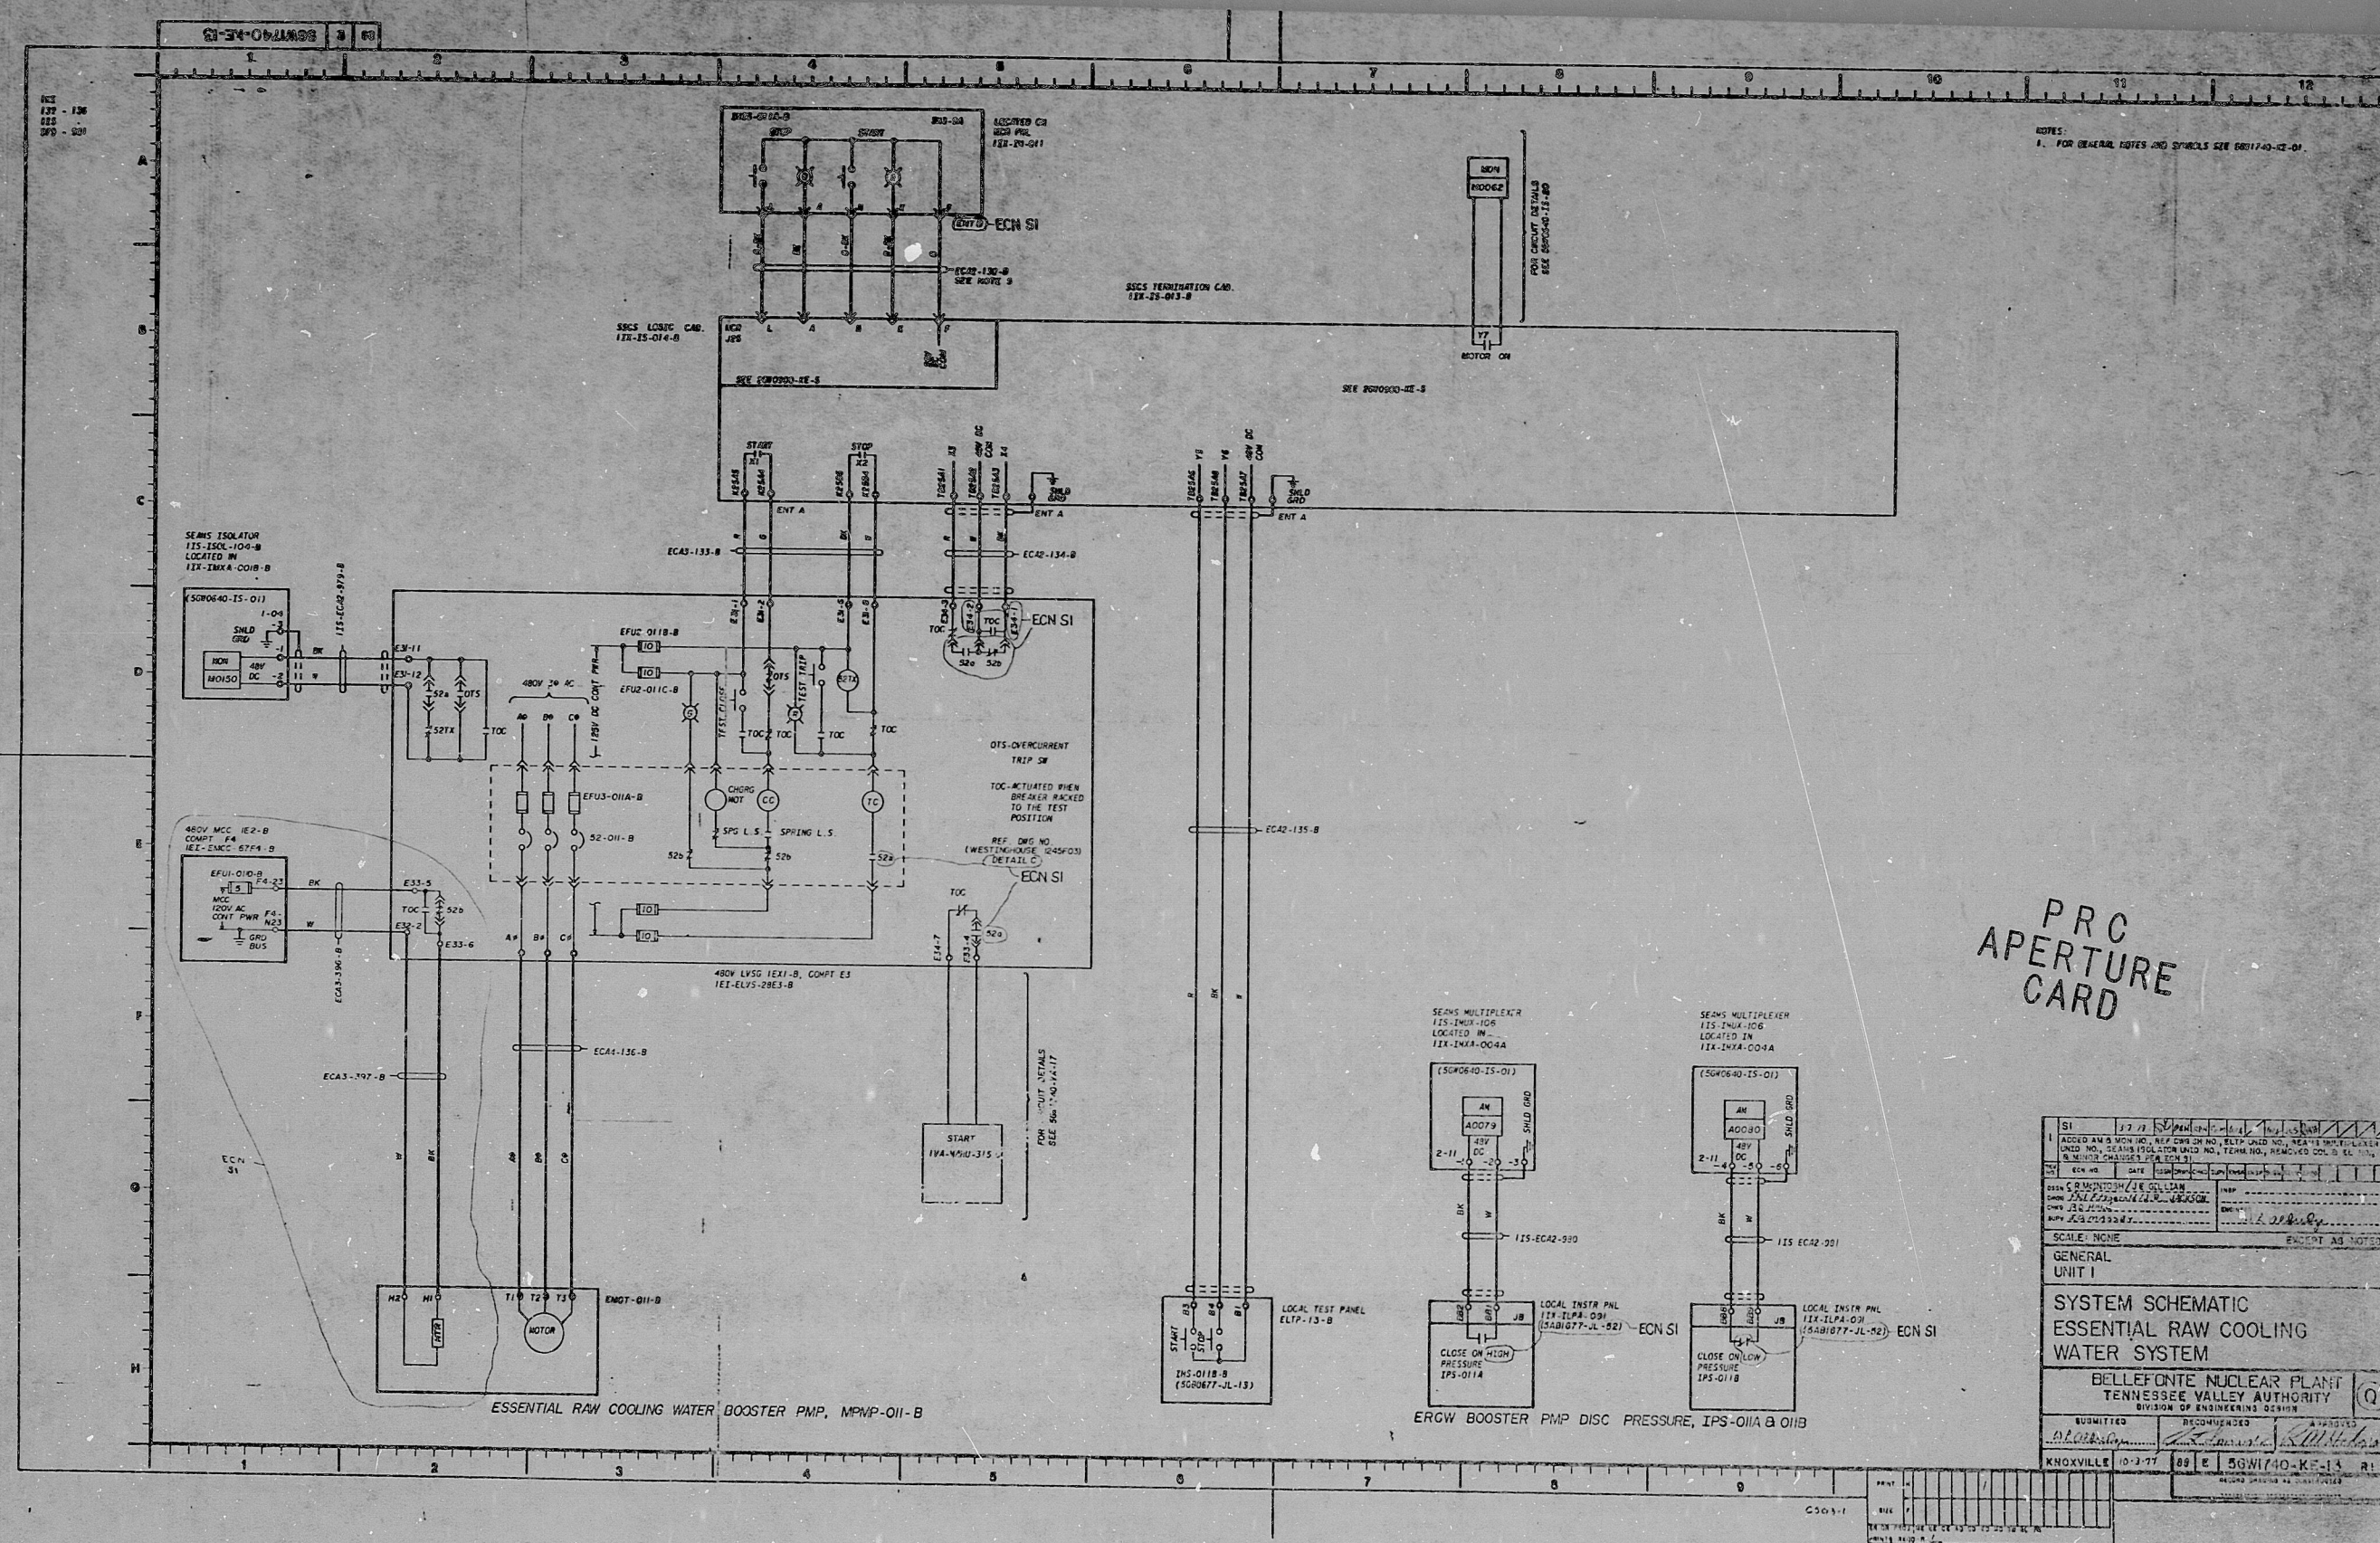

PRC
APERTURE
CARD

RIDS

8204140585

