


WIRING DIAG. DWG.	6/20E-1-4251C	6/20E-1-4251E	6/20E-1-4251C	6/20E-1-4251F	6/20E-1-4251C	6/20E-1-4251F	6/20E-1-4251C	6/20E-1-4251F	6/20E-1-4251C	6/20E-1-4251C	6/20E-1-4251C	6/20E-1-4251C	6/20E-1-4251C	6/20E-1-4251C	6/20E-1-4251C	6/20E-1-4251C	6/20E-1-4251C	6/20E-1-4251C	6/20E-1-4251F
SCHEM. REF. 6/20E-1-4030 PG.			DC10	DC10	DC10	DC10	DC10	DC10	DC10	DC10	DC10	DC10	DC10	DC10	DC10	DC10	DC10	DC10	DC10
KVA RATING																			
BKR FRAME/TRIP RATING (A)	100	100	150	70	70	70	70	70	70	70	70	70	70	70	50	70	40	40	30
SERVICE	4160V SWGR 144 MAIN FEED	4160V SWGR 144 RESERVE FEED	DC EMERGENCY LIGHTING CAB. 153 & 155	FEED 480V SWGR 034W	MAIN & RESERVE FEED 6900V SWGR 356	MAIN & RESERVE FEED 6900V SWGR 199	SEQ. EVENT RECORDER	SPARE	FEED 480V SWGR 134X	FEED 480V SWGR 134V	FEED 480V SWGR 134V	DC FUSE PNL	FEED 480V SWGR 134Z	SPARE	DC EMERGENCY LIGHTING CAB. 152	SPARE	480V BUS 034R	MCB CONTAINMENT LEVEL PNL	
EQUIPMENT NO.	1A08EJ	14P08EJ	1LL53J & 55J	0A04E	1AP74EE	1AP04EF	1PA42J		1AP16EA	1AP75E	1AP17EA	1DC15J	1AP19EA		1LL52J		0AP17E	1PM11J	

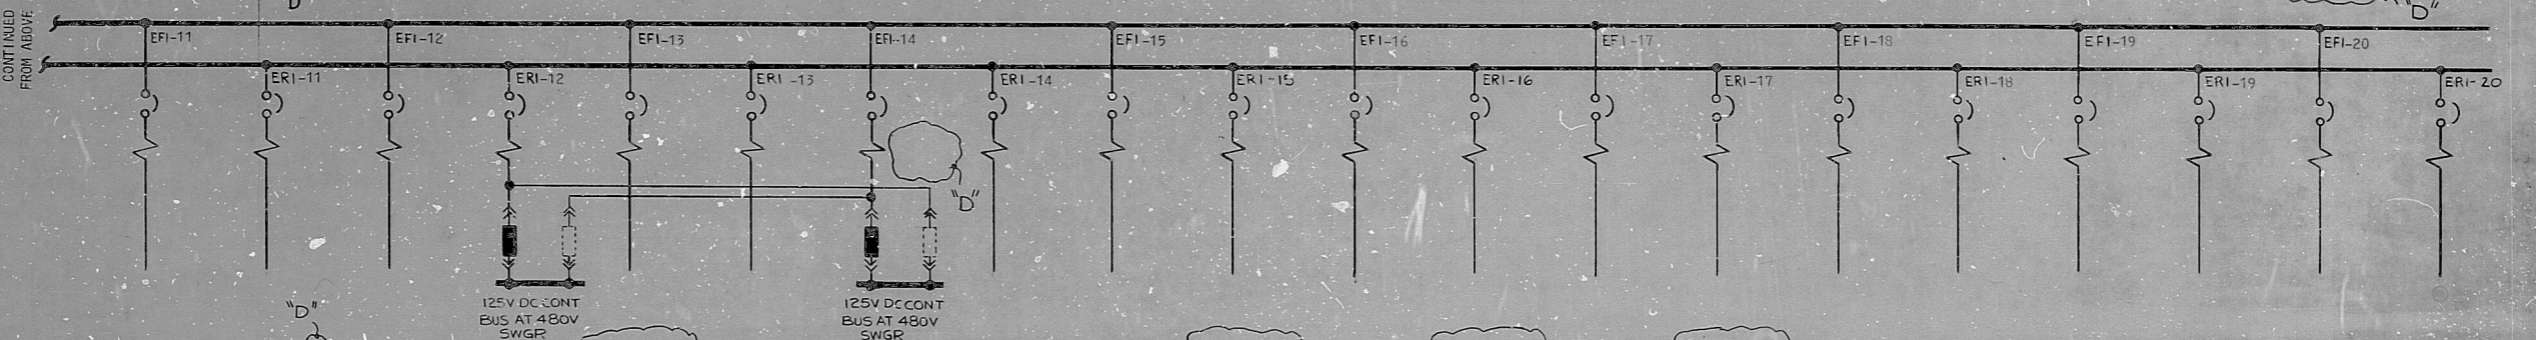

WIRING DIAG. DWG.	6/20E-1-4251E	6/20E-1-4251C	6/20E-1-4251F	6/20E-1-4251C	6/20E-1-4251F	6/20E-1-4251C	6/20E-1-4251C	6/20E-1-4251C	6/20E-1-4251C	6/20E-1-4251C	6/20E-1-4251C	6/20E-1-4251C	6/20E-1-4251C	6/20E-1-4251C	6/20E-1-4251F	6/20E-1-4251C	6/20E-1-4251C	6/20E-1-4251C	6/20E-1-4251C	
SCHEM. REF. 6/20E-1-4030 PG.	DC10	DC10	DC10	DC10	DC10	DC10	DC10	DC10	DC10	DC10	DC10	DC10	DC10	DC10	DC10	DC10	DC10	DC10	DC10	
KVA RATING																				
BKR FRAME/TRIP RATING (A)	40	30	50	30	30	20	30	20	30	20	20	20	20	20	20	20	20	20	20	
SERVICE	SPARE	CO2 FIRE PROT. SYS. PWR. DISTR. CAB.	ROD DRIVE M6 SET SWGR	FEED 480V PRESSR HTR SWGR	FIRE PROT. SYS. PWR. DISTR. CAB.	RESERVE FEED RELAY & METERING PANEL	FEED 480V PRESSR HTR SWGR	SWYD PNL	REMOTE SHUTDOWN PNL	SPARE	BORIC ACID BATCHING TANK J.B.	SPARE	MCB FEED WATER	DATA ACQUISITION CAB.	MCB TURB. SECT.	WASTE PROC. PNL - RECYCLE SECT.	RIVER SCREEN HSE SUPV CAB.	MAIN FEED RELAY & METERING PANEL	TURBINE PEDESTAL JUNCT. BOX B	SPARE
EQUIPMENT NO.		1C022J	1R05E	1RY01E	1FP02J	1PA23J	1RY01E	0PM03J	1P06J		0AB04T		1PM04J	0PA01J	1PM02J	0AB01J	0PA04J	1PA23J	1T607B	

TERA APERTURE CARD



NOTES	DRAWING RELEASE RECORD		DRAWN CHECKED ENGR. APPROVAL	KEY DIAGRAM 125V DC ESF DISTRIBUTION CENTER BUS 112 (10C06E) PART 3
	REV. DATE	DESCRIPTION		
	A	9-10-76 ELECTRICAL INSTALLATION SPEC. 7-2790		
REFERENCE DRAWINGS		DRAWING NO.		BYRON/BRADWOOD STATIONS - UNIT - COMMONWEALTH EDISON CO. CHICAGO, ILLINOIS
DESCRIPTION		DESCRIPTION		
D		1231-80 MISC. REVISIONS REL. FOR ELECT. INSTALLATION SPEC. 7-2790		
		APPROVED		SCALE: 7-5-16 DRAWN: J. H. ... CHECKED: ... ENGINEER: ... APPROVED: ... JOB NO.: 4391 4683
		E.B.R. ...		
		C.A.		
		DRAWING NO.		FORMERLY 6/20E-ES-192
		BYRON 6E-1-4010F		
		BRADWOOD 20E-1-4C10F		

BBHE-3456(C), BBHE-5228(D)

04

RIDS-RDT

8103020426

