


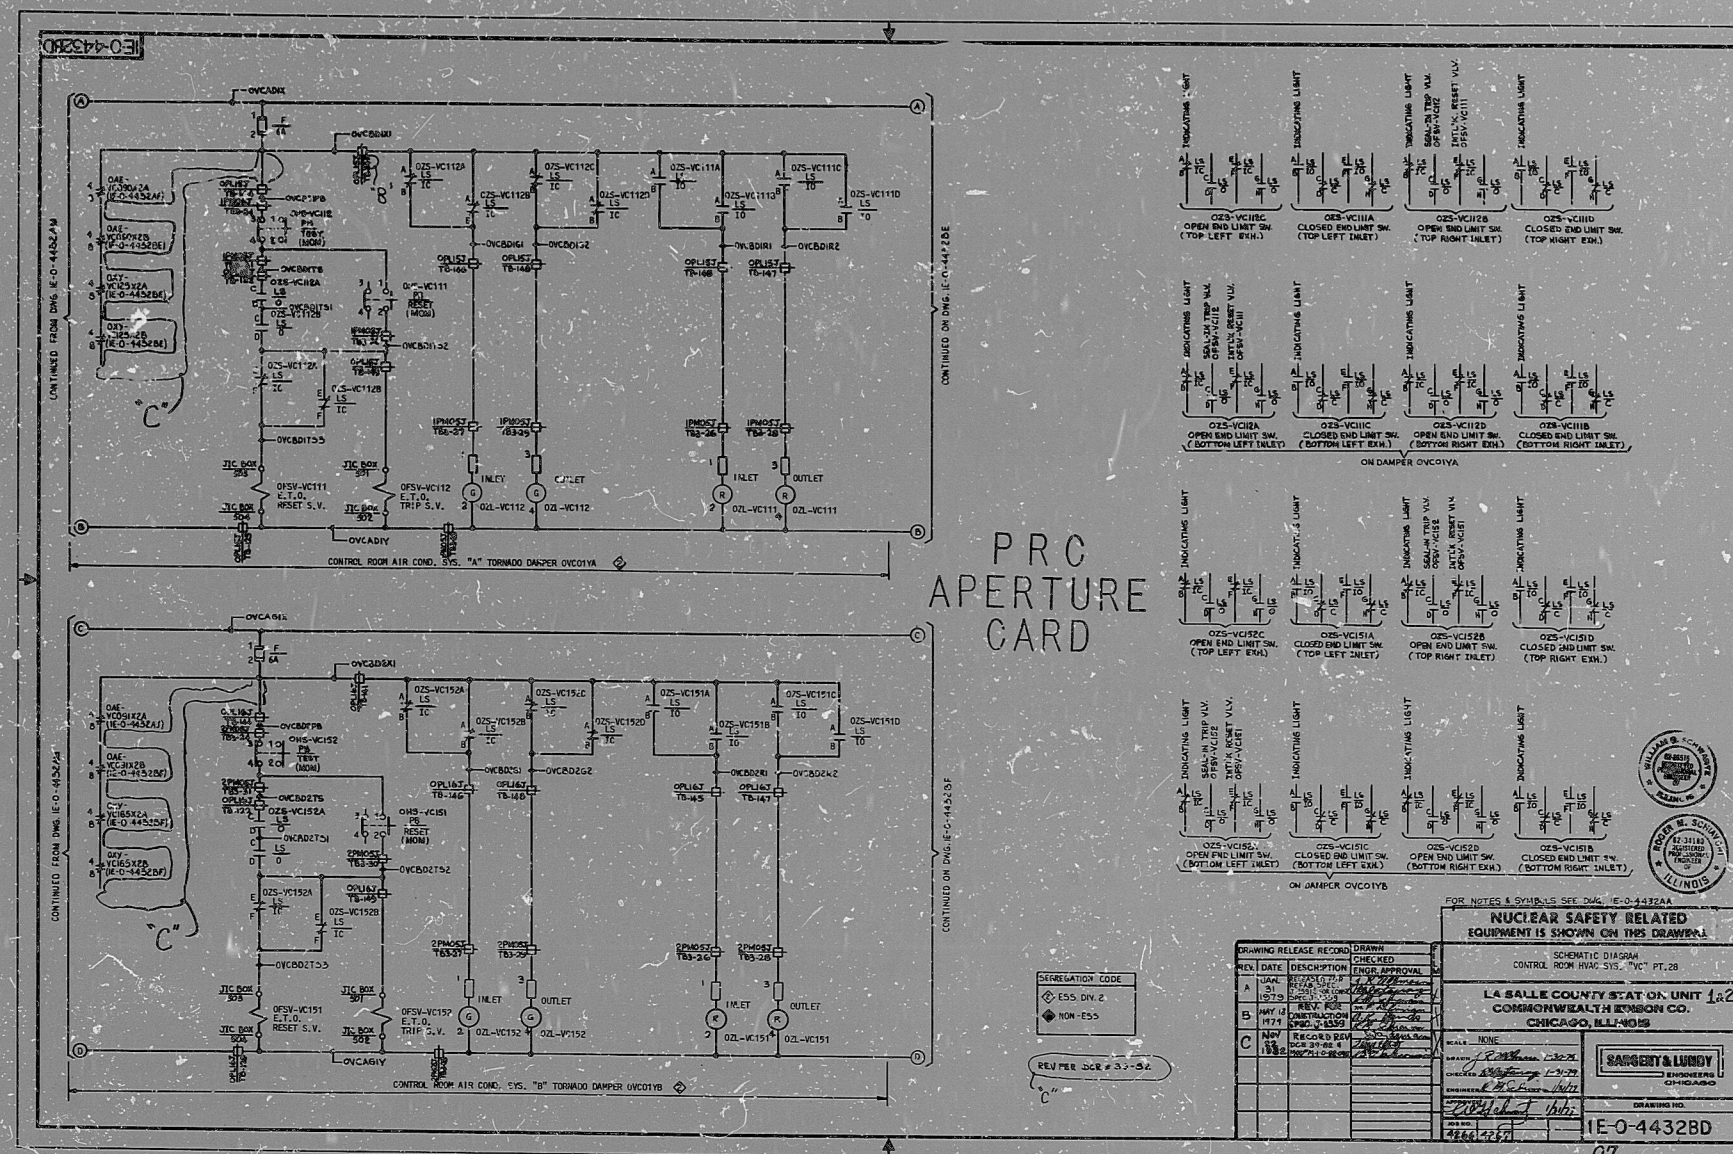

PRC
APERTURE
CARD

RIDS

8308190131

