




INFORMATION
ONLY COPY

PDR RIDS

900531 0101

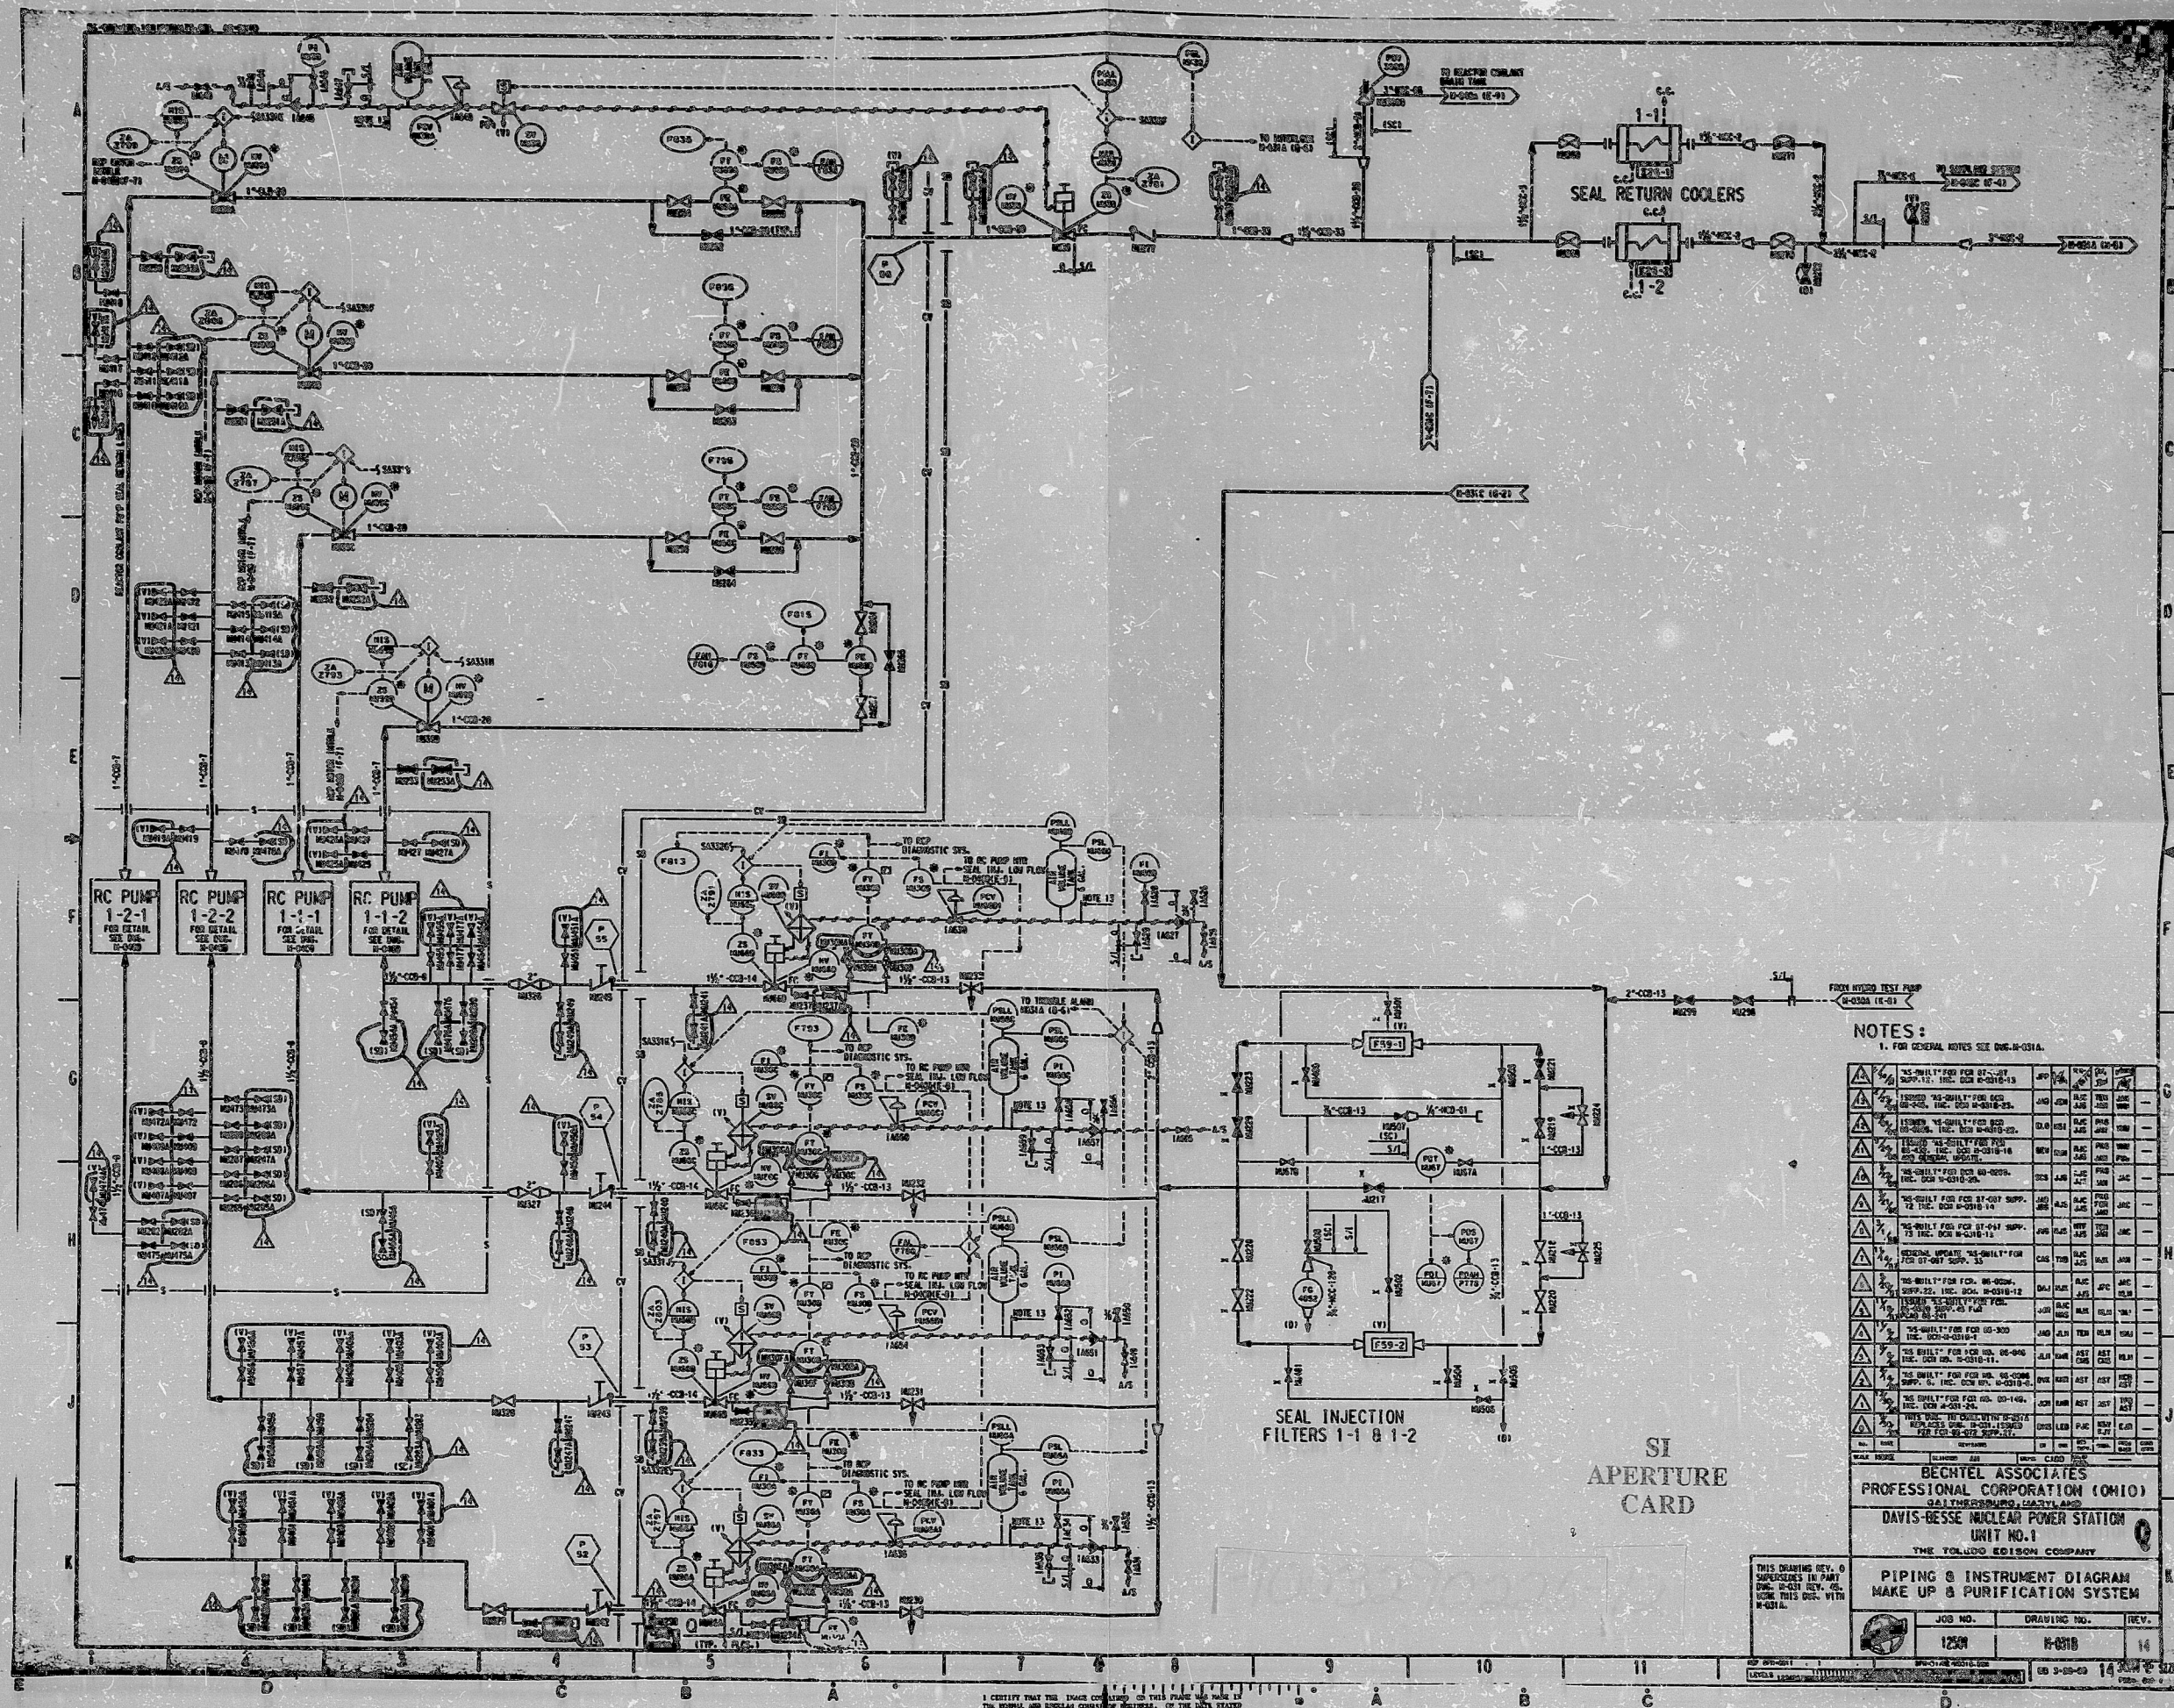