


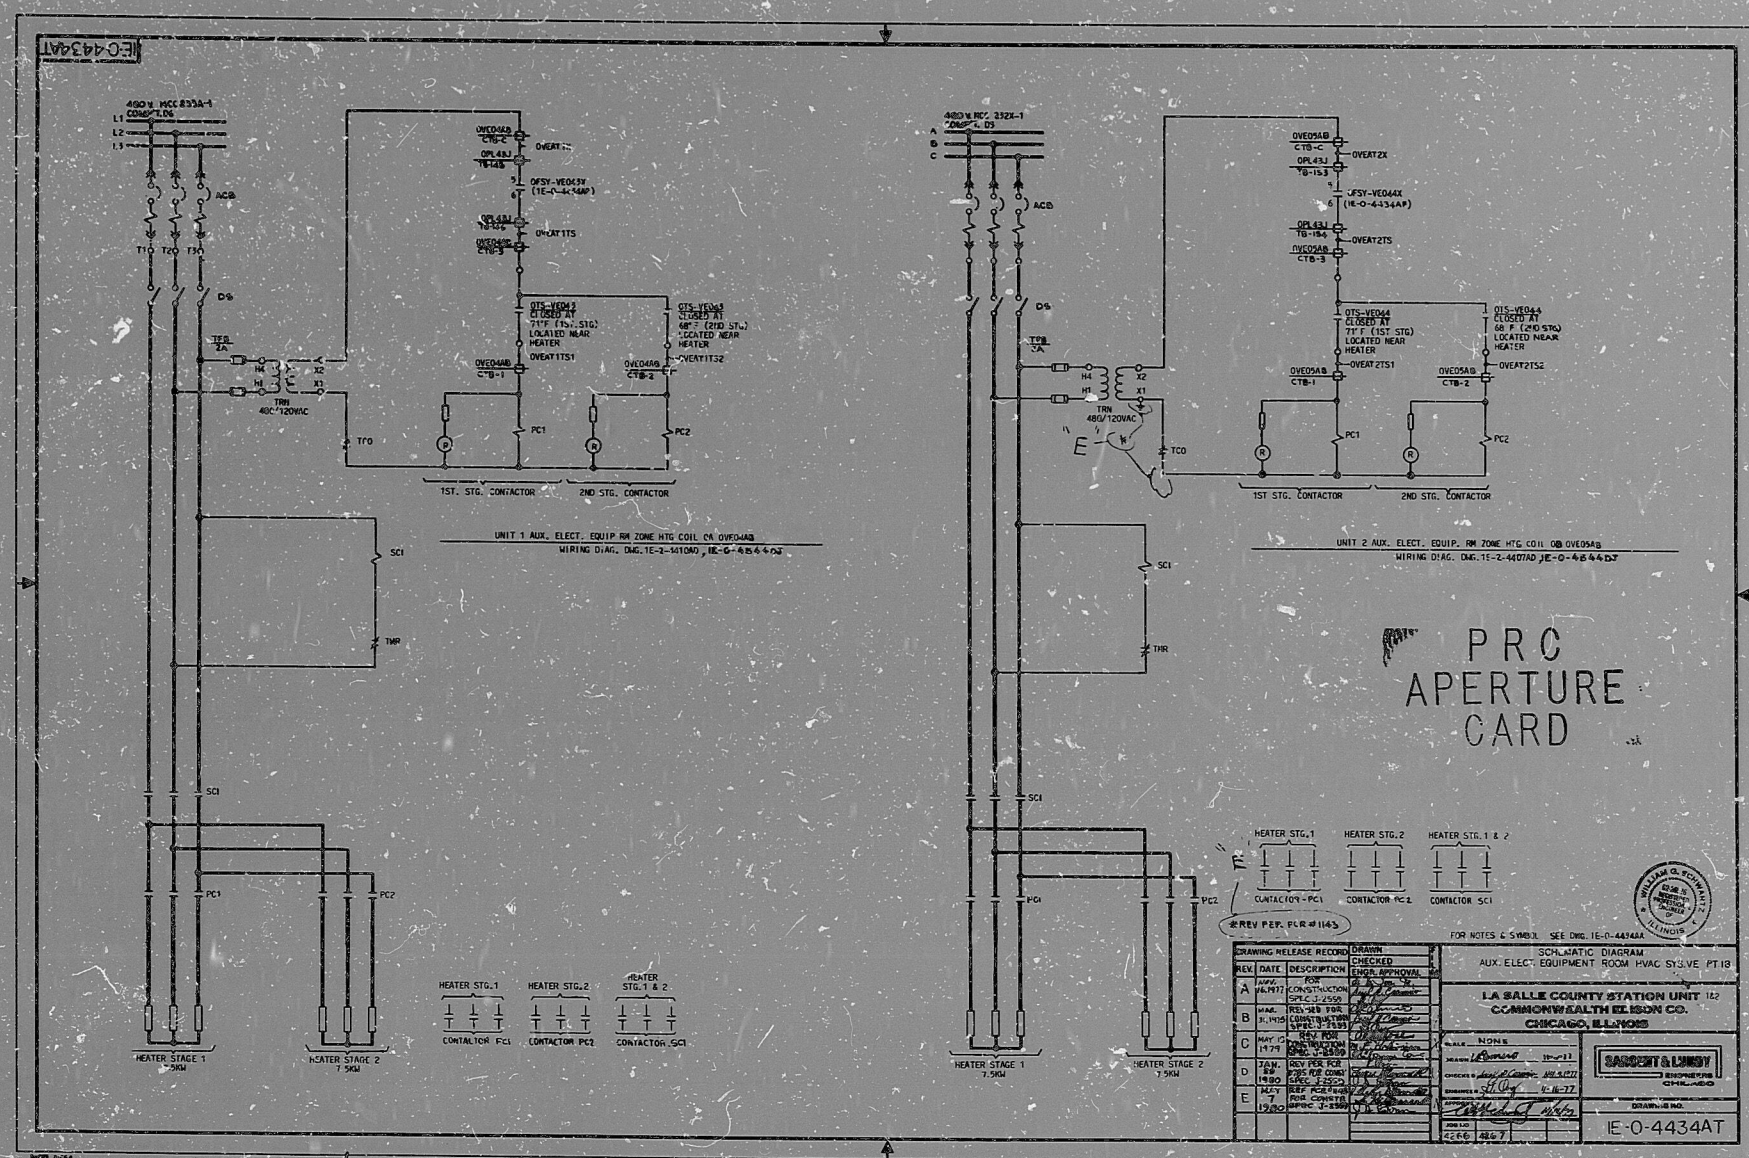

RIDS

8308190289

