




RIDS

80450113

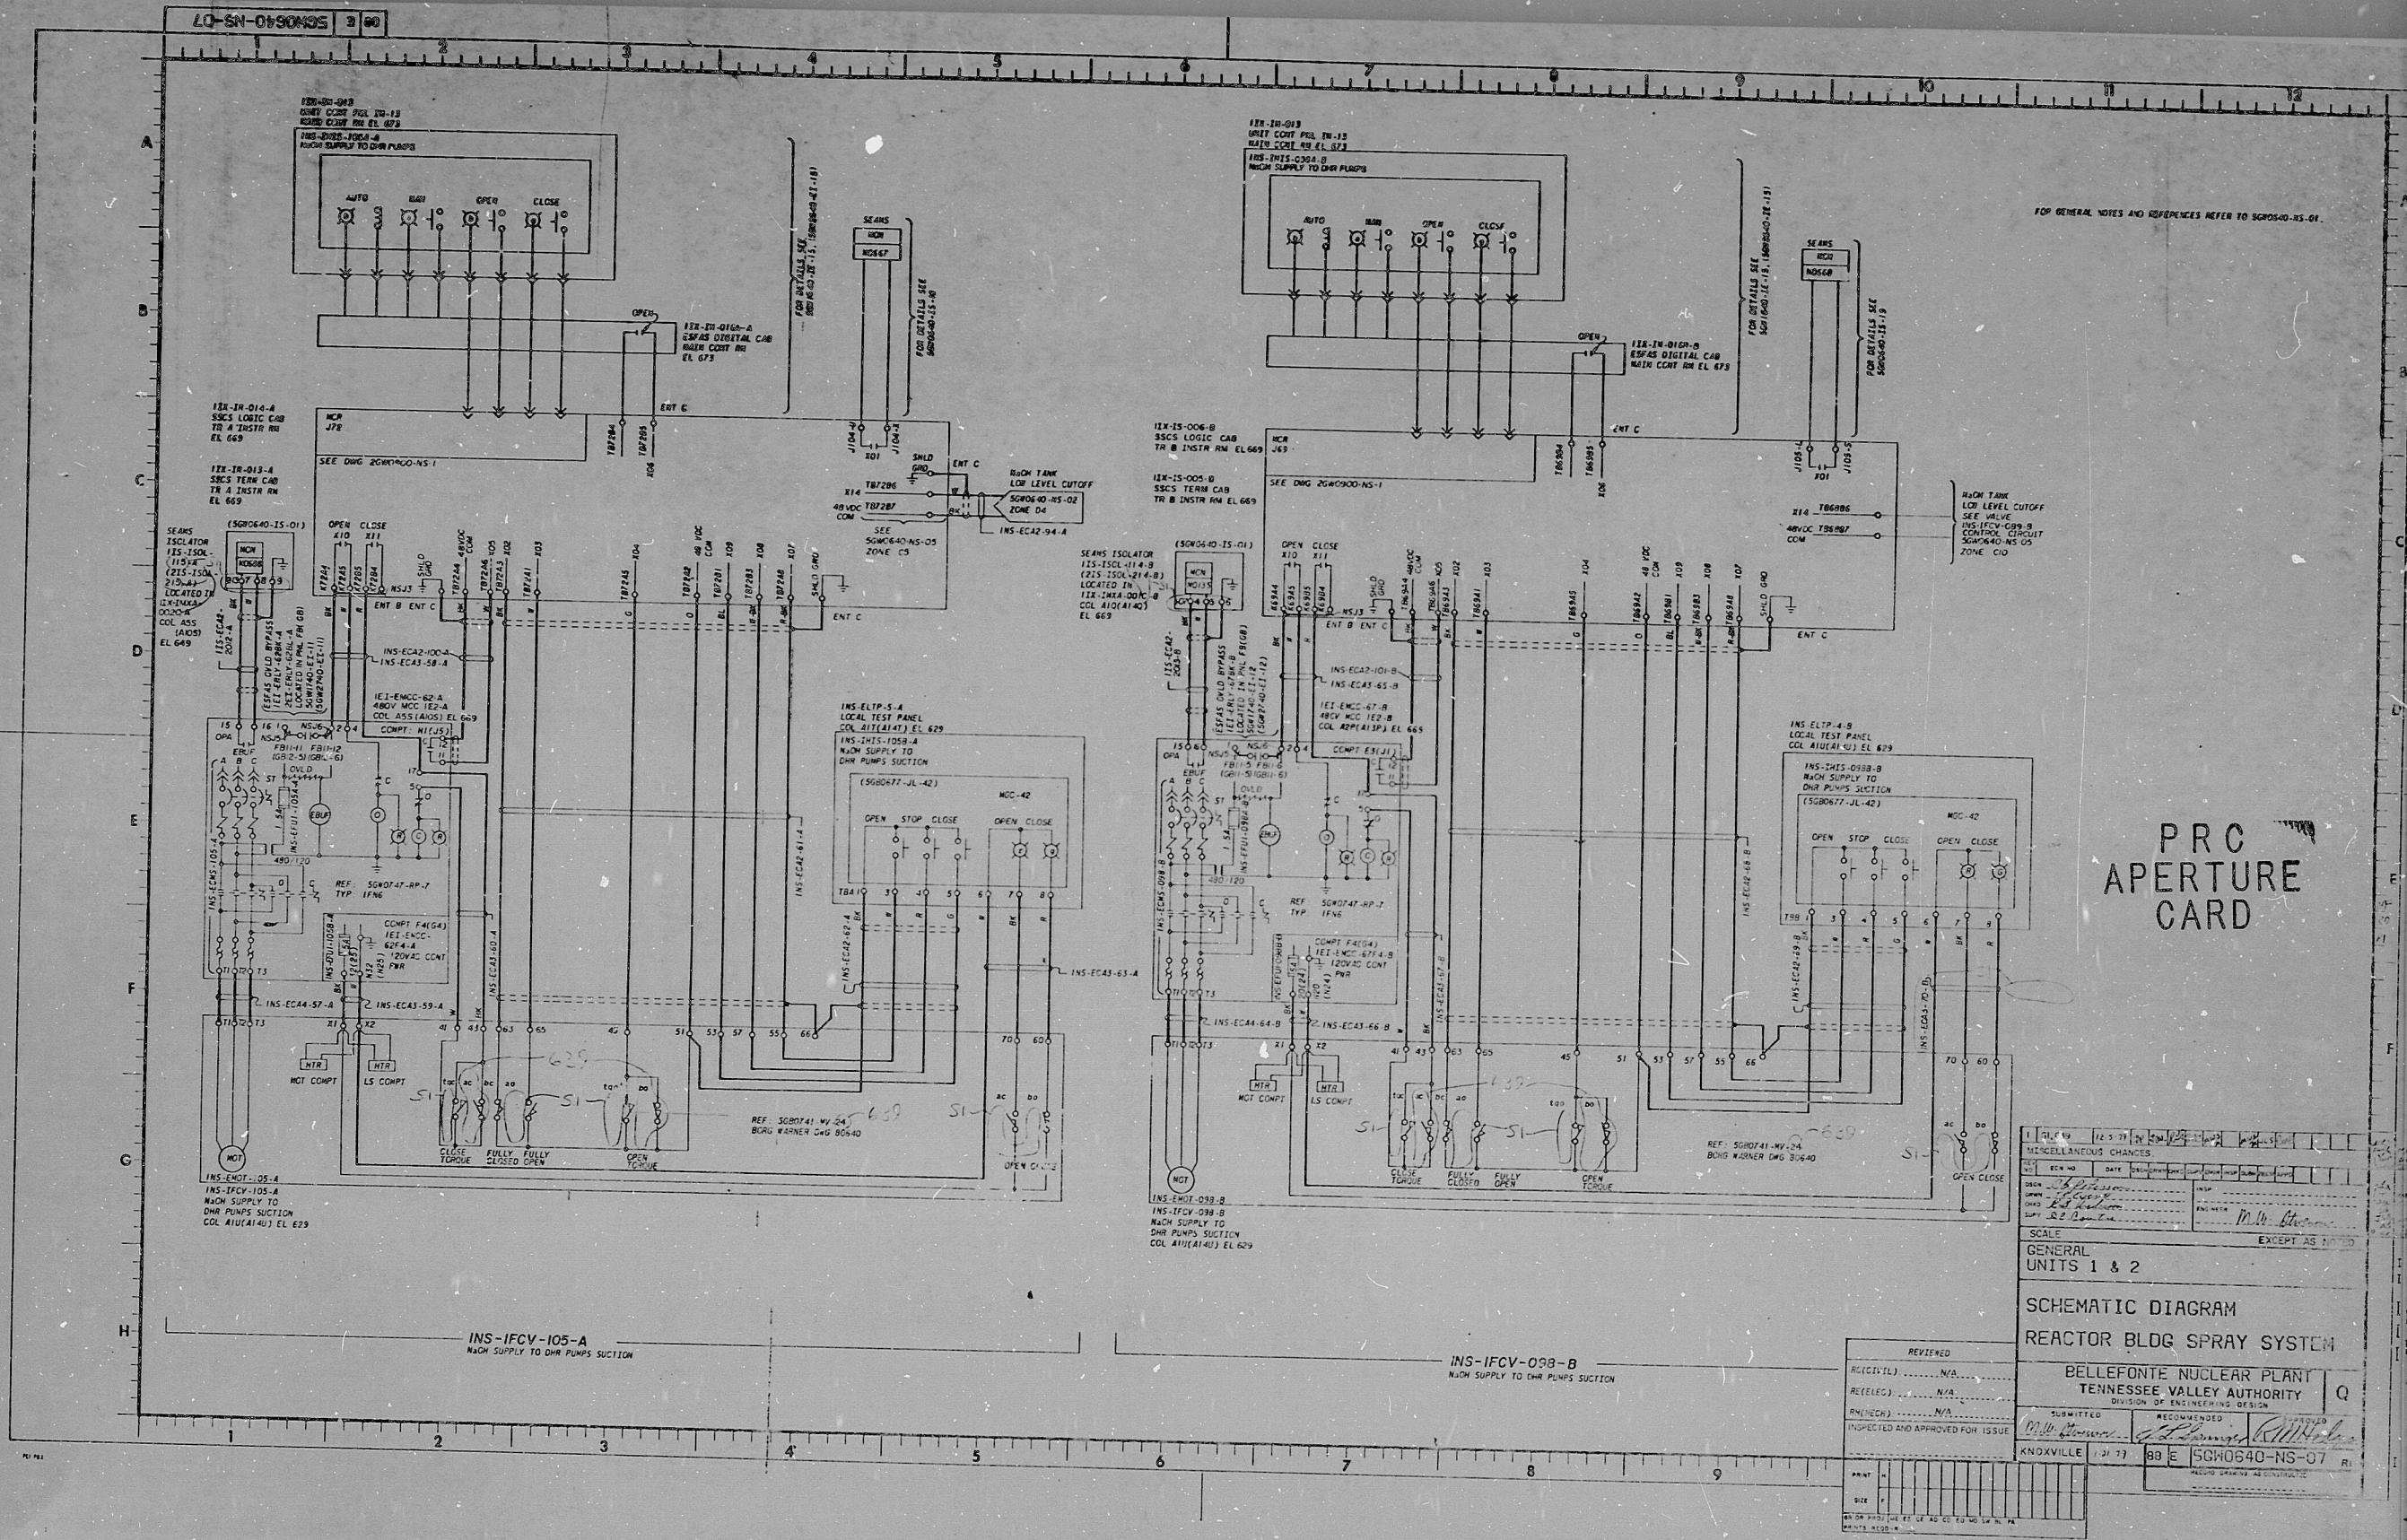