
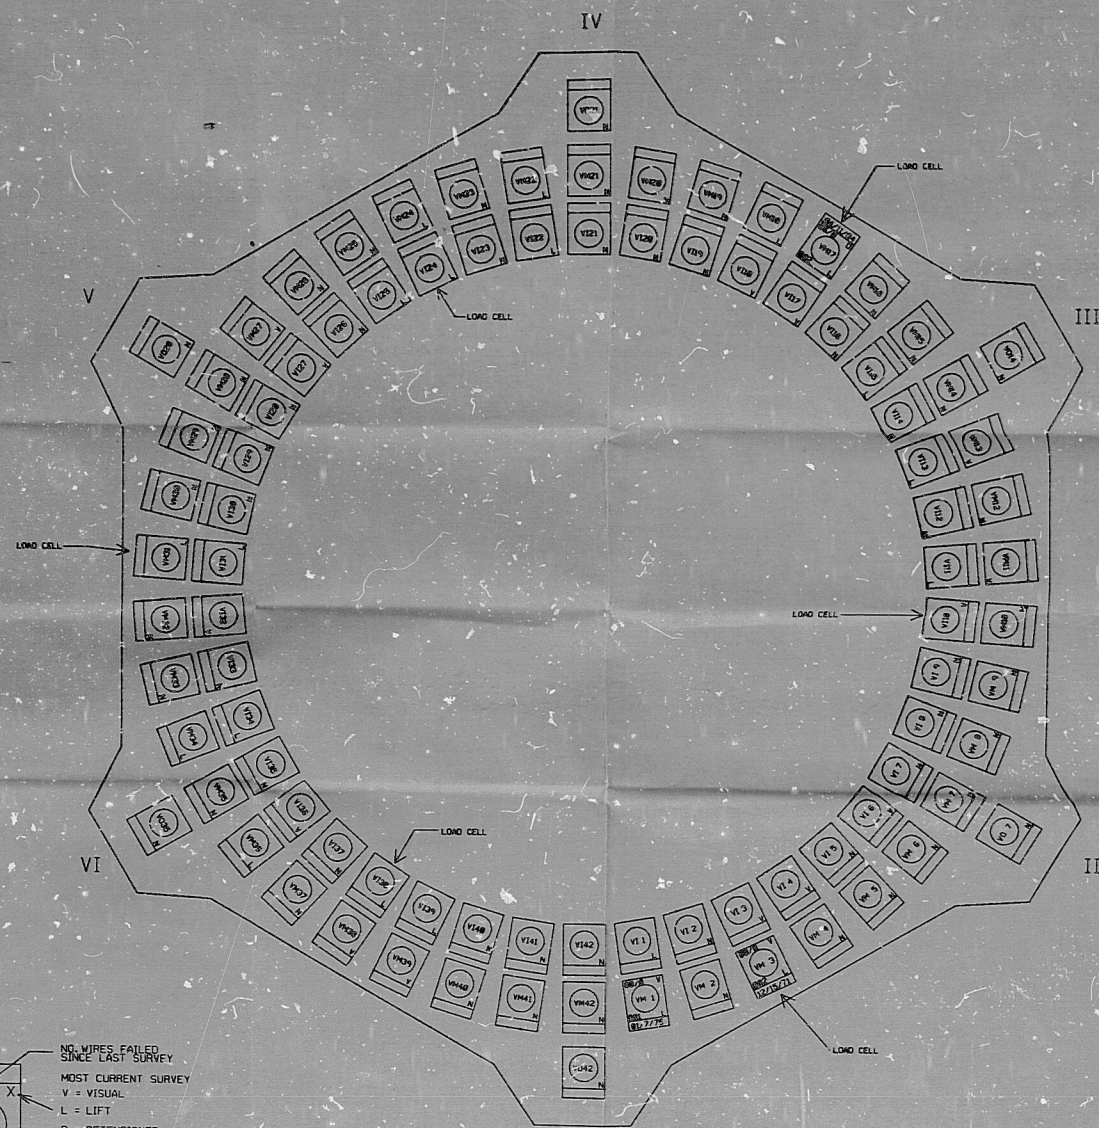
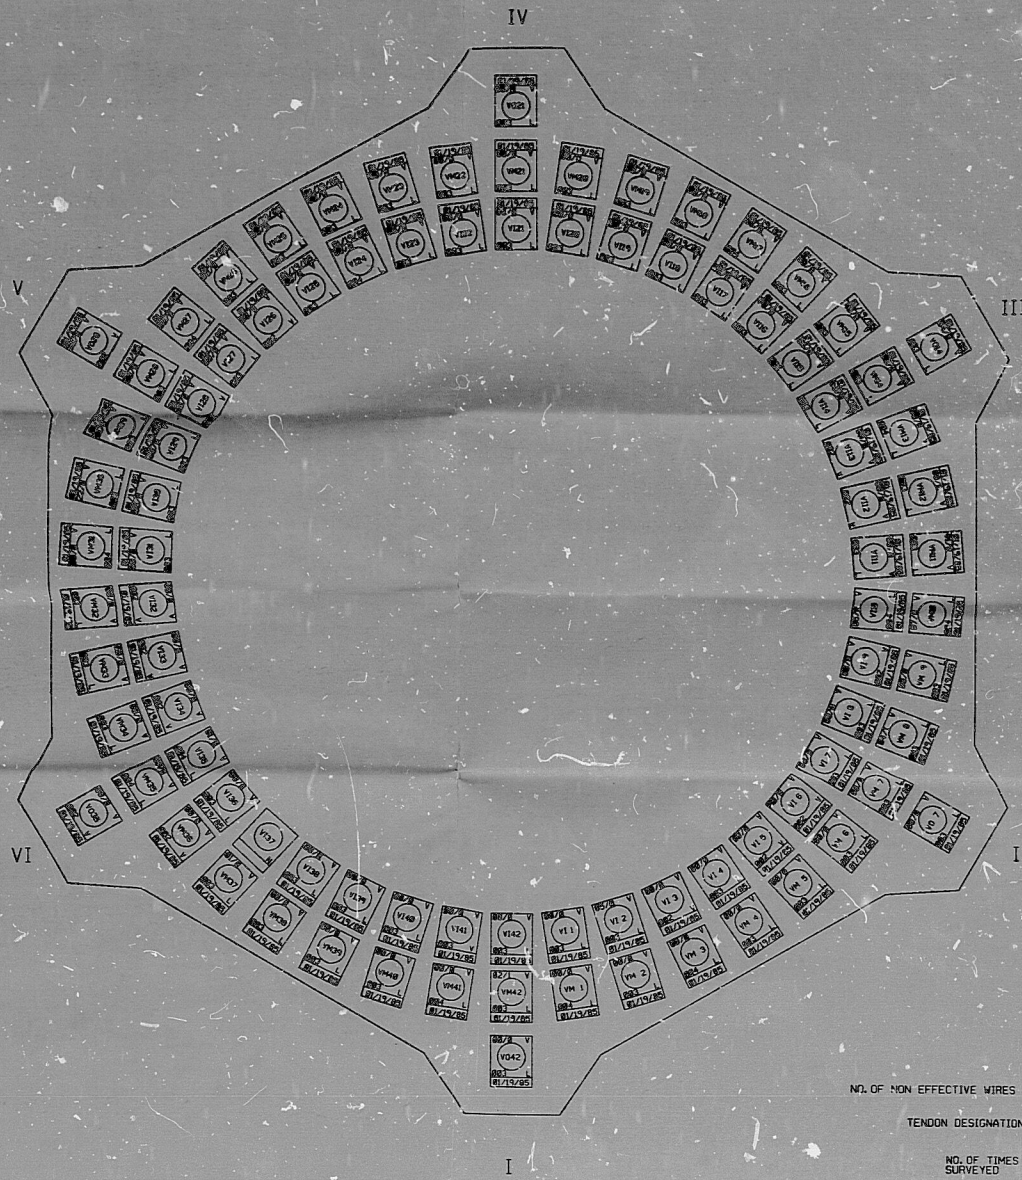


PLAN - TOP OF LONGITUDINAL TENDONS

REFLECTED PLAN - BOTTOM OF LONGITUDINAL TENDONS

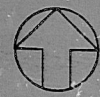

NO. OF NON EFFECTIVE WIRES
 TENDON DESIGNATION
 NO. OF TIMES SURVEYED

DATE
 XX/XX
 XXXX
 XX
 DATE

NO. WIRES FAILED SINCE LAST SURVEY
 MOST CURRENT SURVEY
 V = VISUAL
 L = LIFT
 D = DETENSIFIED

ACCESSIBILITY
 V = VISUAL ONLY
 L = VISUAL AND LIFTOFF
 N = NOT ACCESSIBLE FOR VISUAL OR LIFTOFF

DRAWING GENERATED FOR TENDON SURVEILLANCE REPORT, MARCH 1985 - APPENDIX A

APERTURE CARD

STONE & WEBSTER ENGINEERING CORPORATION DENVER, COLO.	
DRAWING NUMBER 13569.07-EC-1A	
Public Service Company of Colorado	
PCRV TENDON SURVEILLANCE PLAN SHEET 1	
E.I. ST. VRAIN	
DATE	BY

NO.	DATE	BY	CL.	REVISION

8504020/54

PDR AIDS

8504020 154

