


HEAD TENDON BLOCKOUT ELEVATION BETWEEN BUTTRESSES II RIGHT & III LEFT REFERENCE VIEW - 1
 HEAD TENDON BLOCKOUT ELEVATION BETWEEN BUTTRESSES VI RIGHT & I LEFT REFERENCE VIEW - 2

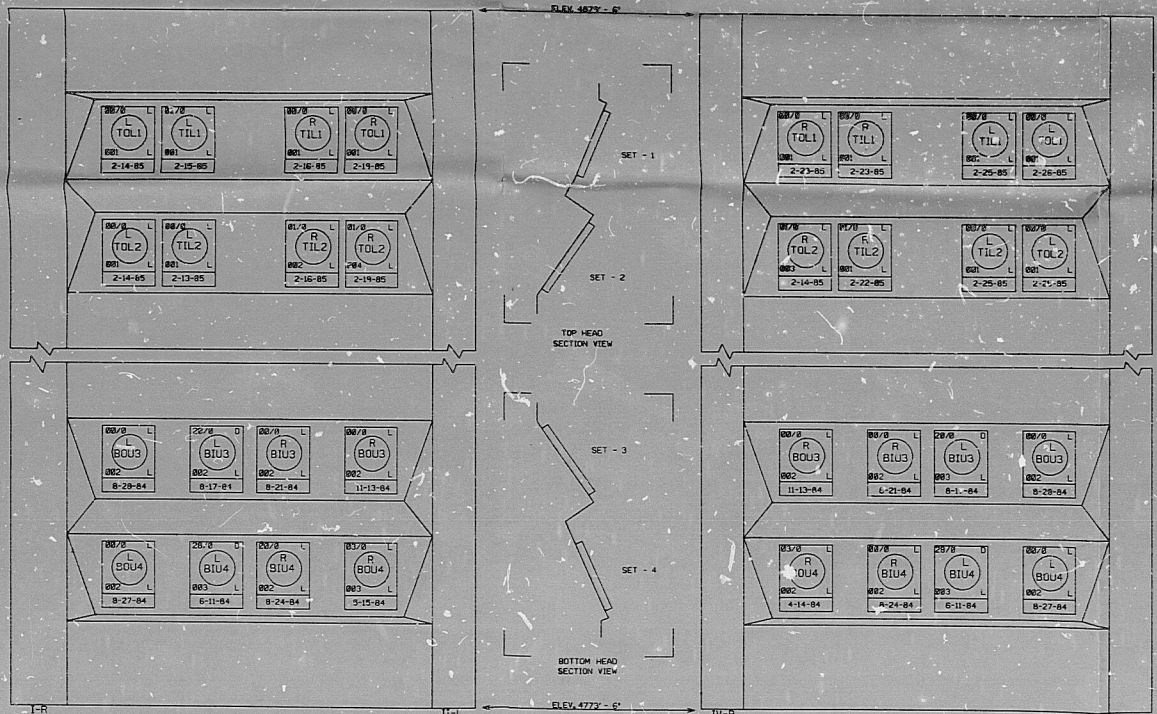

HEAD TENDON BLOCKOUT ELEVATION BETWEEN BUTTRESSES I RIGHT & II LEFT REFERENCE VIEW - 1
 HEAD TENDON BLOCKOUT ELEVATION BETWEEN BUTTRESSES IV RIGHT & V LEFT REFERENCE VIEW - 2

NO. OF NON EFFECTIVE WIRES
 TENDON DESIGNATION
 NO. OF TIMES SURVEYED

DATE
 XX/XX/XX
 XXXX
 XX
 DATE

NO. WIRES FAILED SINCE LAST SURVEY
 V = VISUAL
 L = LIFT
 D = DETENSIONED

ACCESSIBILITY
 V = VISUAL ONLY
 L = VISUAL AND LIFTOFF
 N = NOT ACCESSIBLE FOR VISUAL OR LIFTOFF

* TENDON CAN BE MADE ACCESSIBLE FOR LIFTOFF DURING PLANT SHUTDOWNS ONLY.

DRAWING GENERATED FOR TENDON SURVEILLANCE REPORT, MARCH 1985 - APPENDIX A

APERTURE CARD

8504020103

STONE & WEBSTER ENGINEERING CORPORATION
 DENVER, COLO.
 DRAWING NUMBER: 13569.07-EC-1D
 Public PCBV TENDON Service SURVEILLANCE Company PLAN of Colorado SHEET 4

APPROVALS
 E
 H
 A

DATE
 DATE
 DATE

REP. NO. ET-ST-VRAIN
 SCALE

NO.	DATE	BY	CHKD.	REVISION

PDR RIDS

85040 20163

