


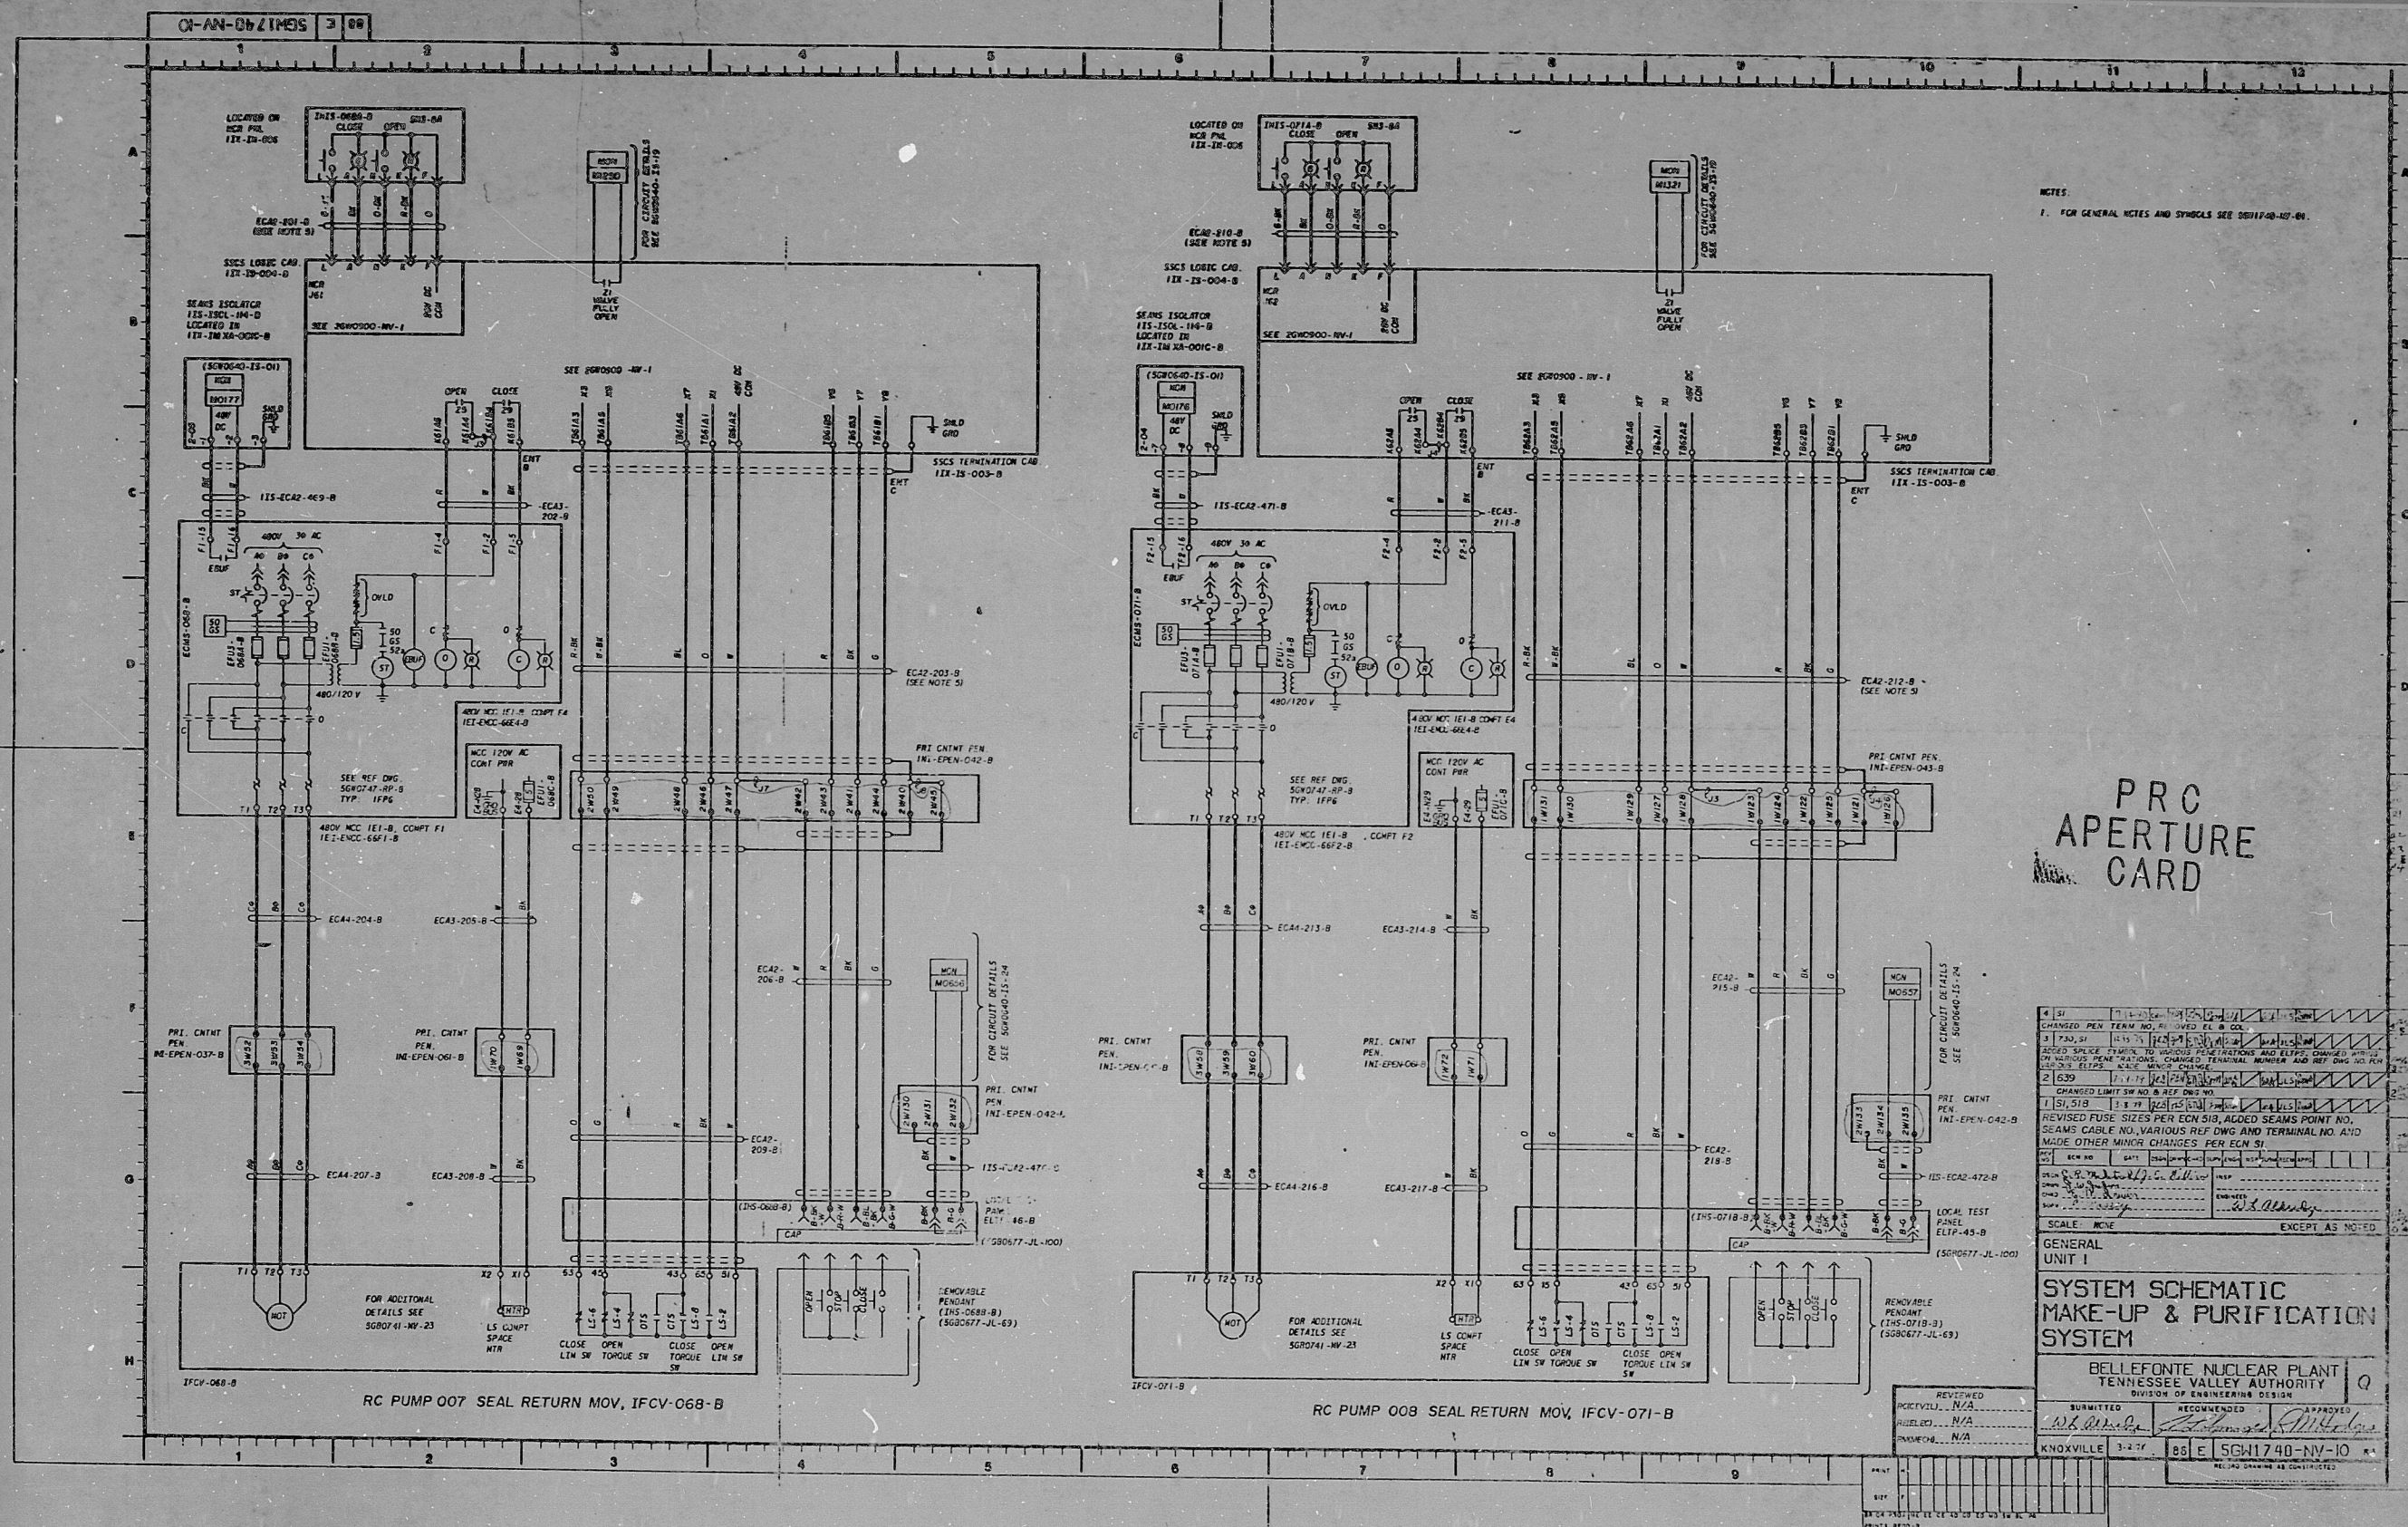

NOTES:
1. FOR GENERAL NOTES AND SYMBOLS SEE 0011740-107-00.

NO.	DESCRIPTION	DATE	BY	CHKD


RIDS

804150159

