


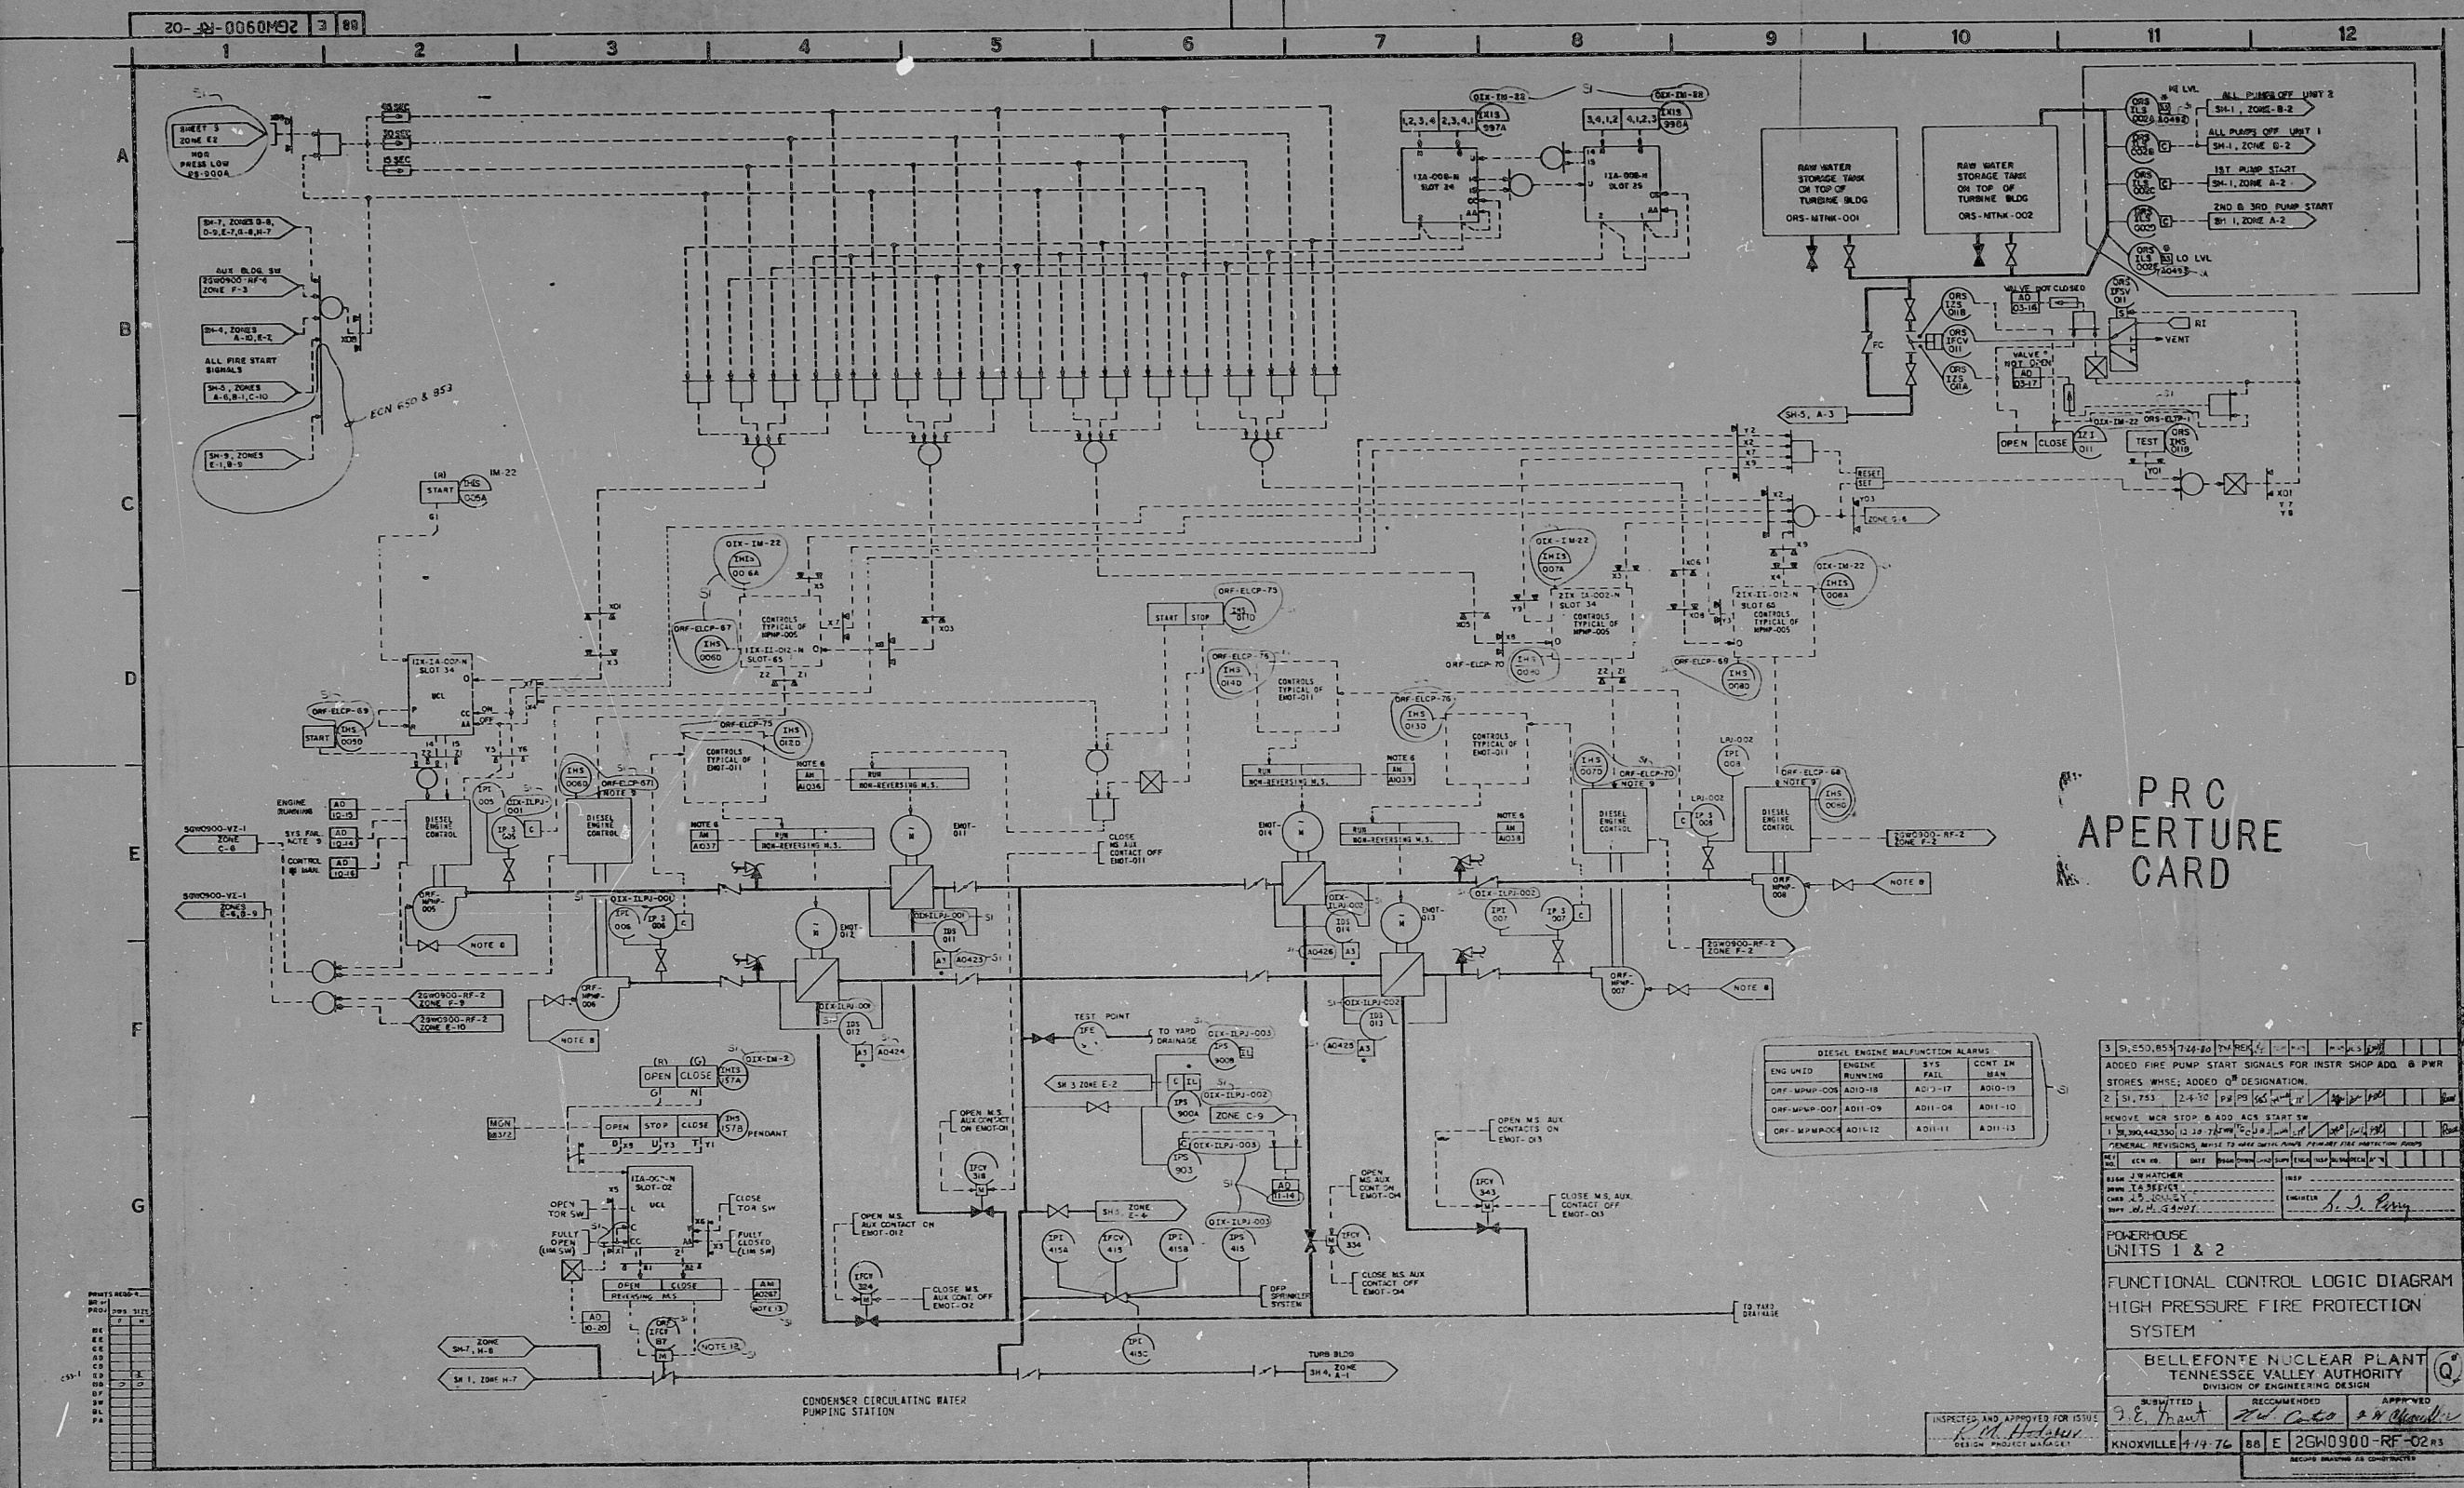



RIDS

8204150211

