


**UNCONTROLLED
DOCUMENT**

Copy Date: 5-29-90

Caution-Extended use of this document copy
may result in its inaccuracy due to subsequent
design changes and document updates

REV. 20

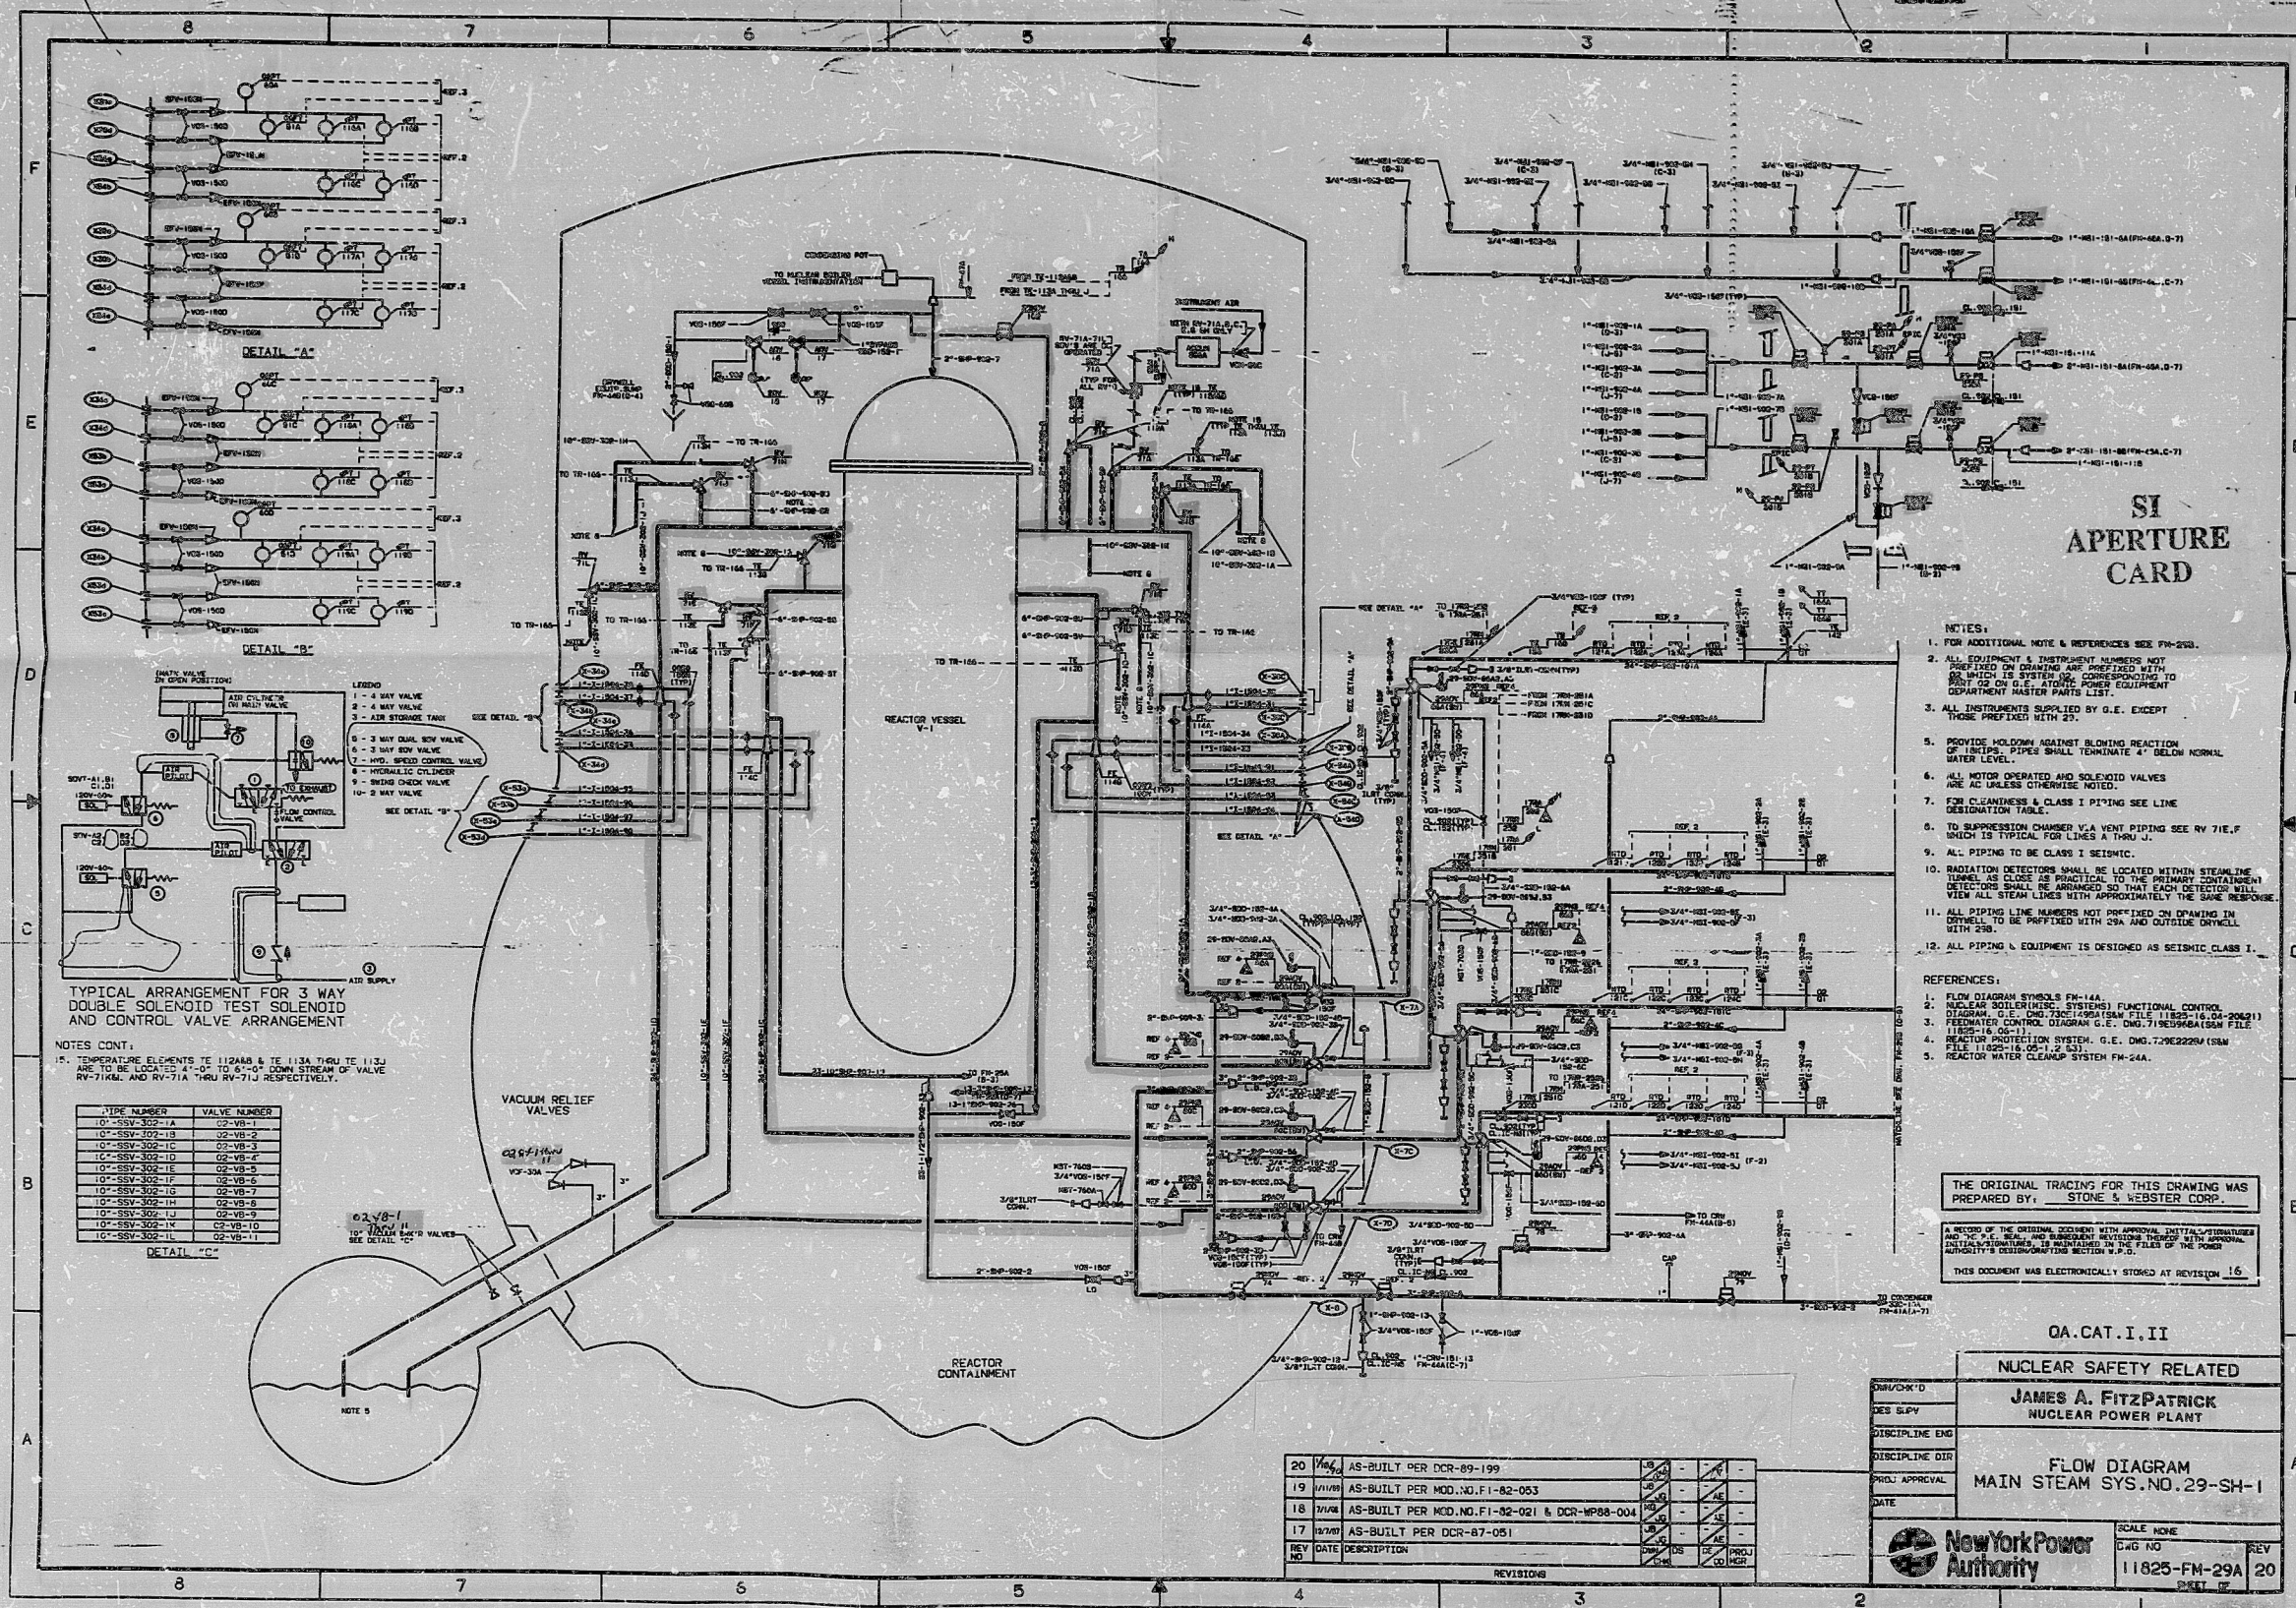

Docket # 50-333 E
Control # 100-96644-8
Date 3/22/92 of Document
REGULATORY DOCKET FILE

PDR RIDS

9006040009

