



GENERAL ELECTRIC 105D4988

CUTLINE  
HYDRAULIC CONTROL UNIT  
REF. HCL-CTI-1050 FOR CONTINUATION

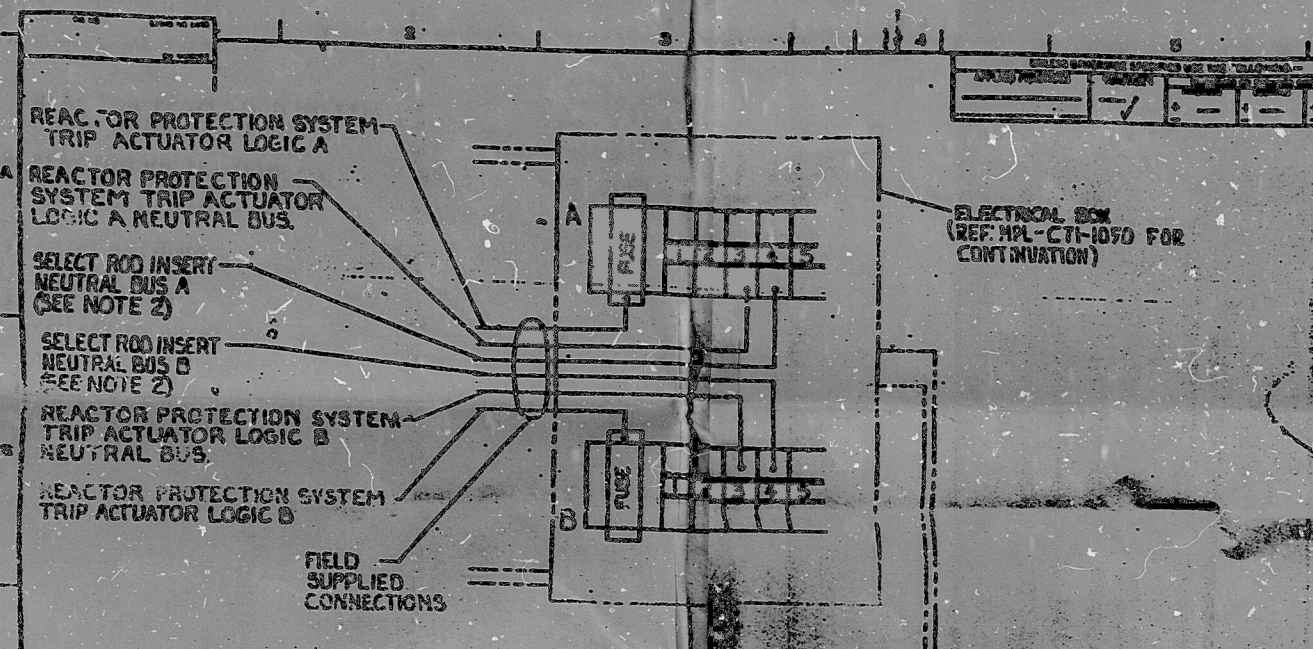


- NOTES:
1. FIELD SUPPLIED CONNECTIONS SHALL BE #18 THRU #10 WIRE (LOAD IS 15.4 WATTS AT 180 VAC). #8-32 BINDING HEAD SCREWS ARE PROVIDED ON TERMINAL BLOCK IN ELEC. BOX FOR FIELD CONNECTIONS.
  2. THESE WIRES ARE NECESSARY ONLY WHEN THE SELECT ROD INSERT OPTION IS ACCEPTED. ALL OTHER CONNECTIONS REMAIN THE SAME.

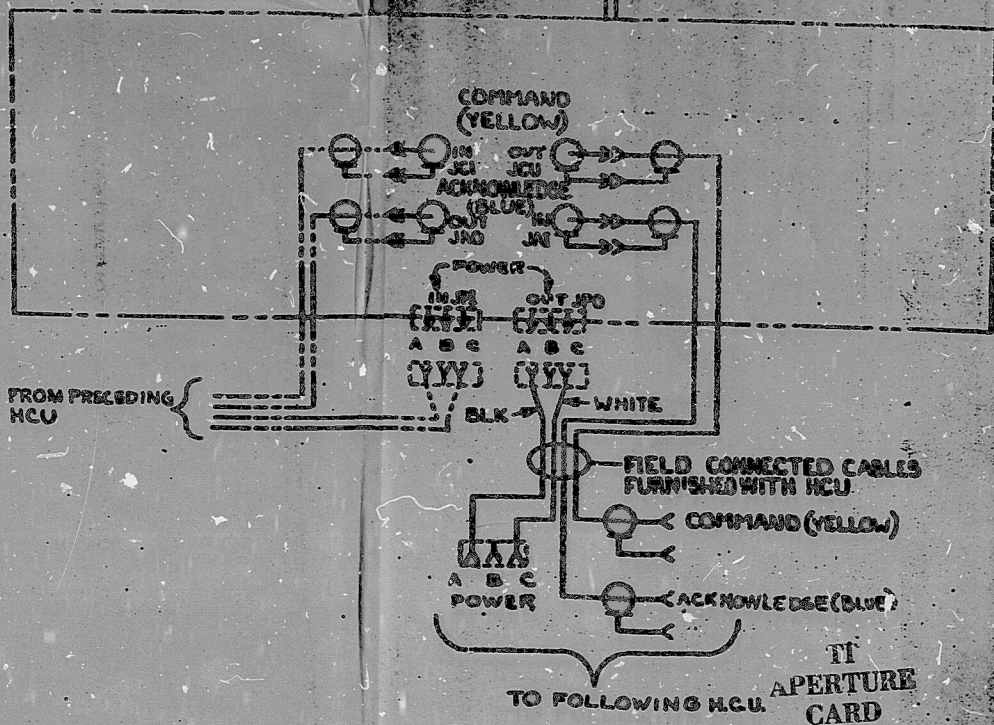

WIRING TROUGH (REF. HCL-CTI-1050 FOR CONTINUATION)

REVIEWED FOR  
 CLINTON POWER STATION  
 UNIT 1  
 SARGENT & LUNDY  
 ENGINEERS

1.  NO EXCEPTION TAKEN. CONTRACTOR MAY PROCEED WITH FABRICATION OR CONSTRUCTION IN ACCORDANCE WITH SPECIFICATION.
2.  CONTRACTOR MAY PROCEED IN ACCORDANCE WITH SPECIFICATION BASED ON MAKING REVISIONS AS NOTED AND RESENT.
3.  REVISE AS NOTED AND REWORK. HOLD FABRICATION.

ANY ACTION SHOWN ABOVE IS SUBJECT TO THE TERMS OF THE CONTRACT AND DOES NOT RELIEVE CONTRACTOR FROM HIS OBLIGATIONS UNDER THE CONTRACT, INCLUDING DESIGN AND DETAILING.

FOR OUTLINE HYDRAULIC CONTROL UNIT  
 EQUIPMENT NO. CU-2001  
 BY R. RUTHA DATE 5-11-64  
 SPEC. NO. 2801 PROJ. NO. 4536

1514405515

8504090391

105D4988

S

PDR RIDS

8504090391

