


CLASS 1 = PINK
CLASS 2 = YELLOW
CLASS 3 = GREEN
1ST COMPONENT = BLUE



PDR RIDS

9006040147

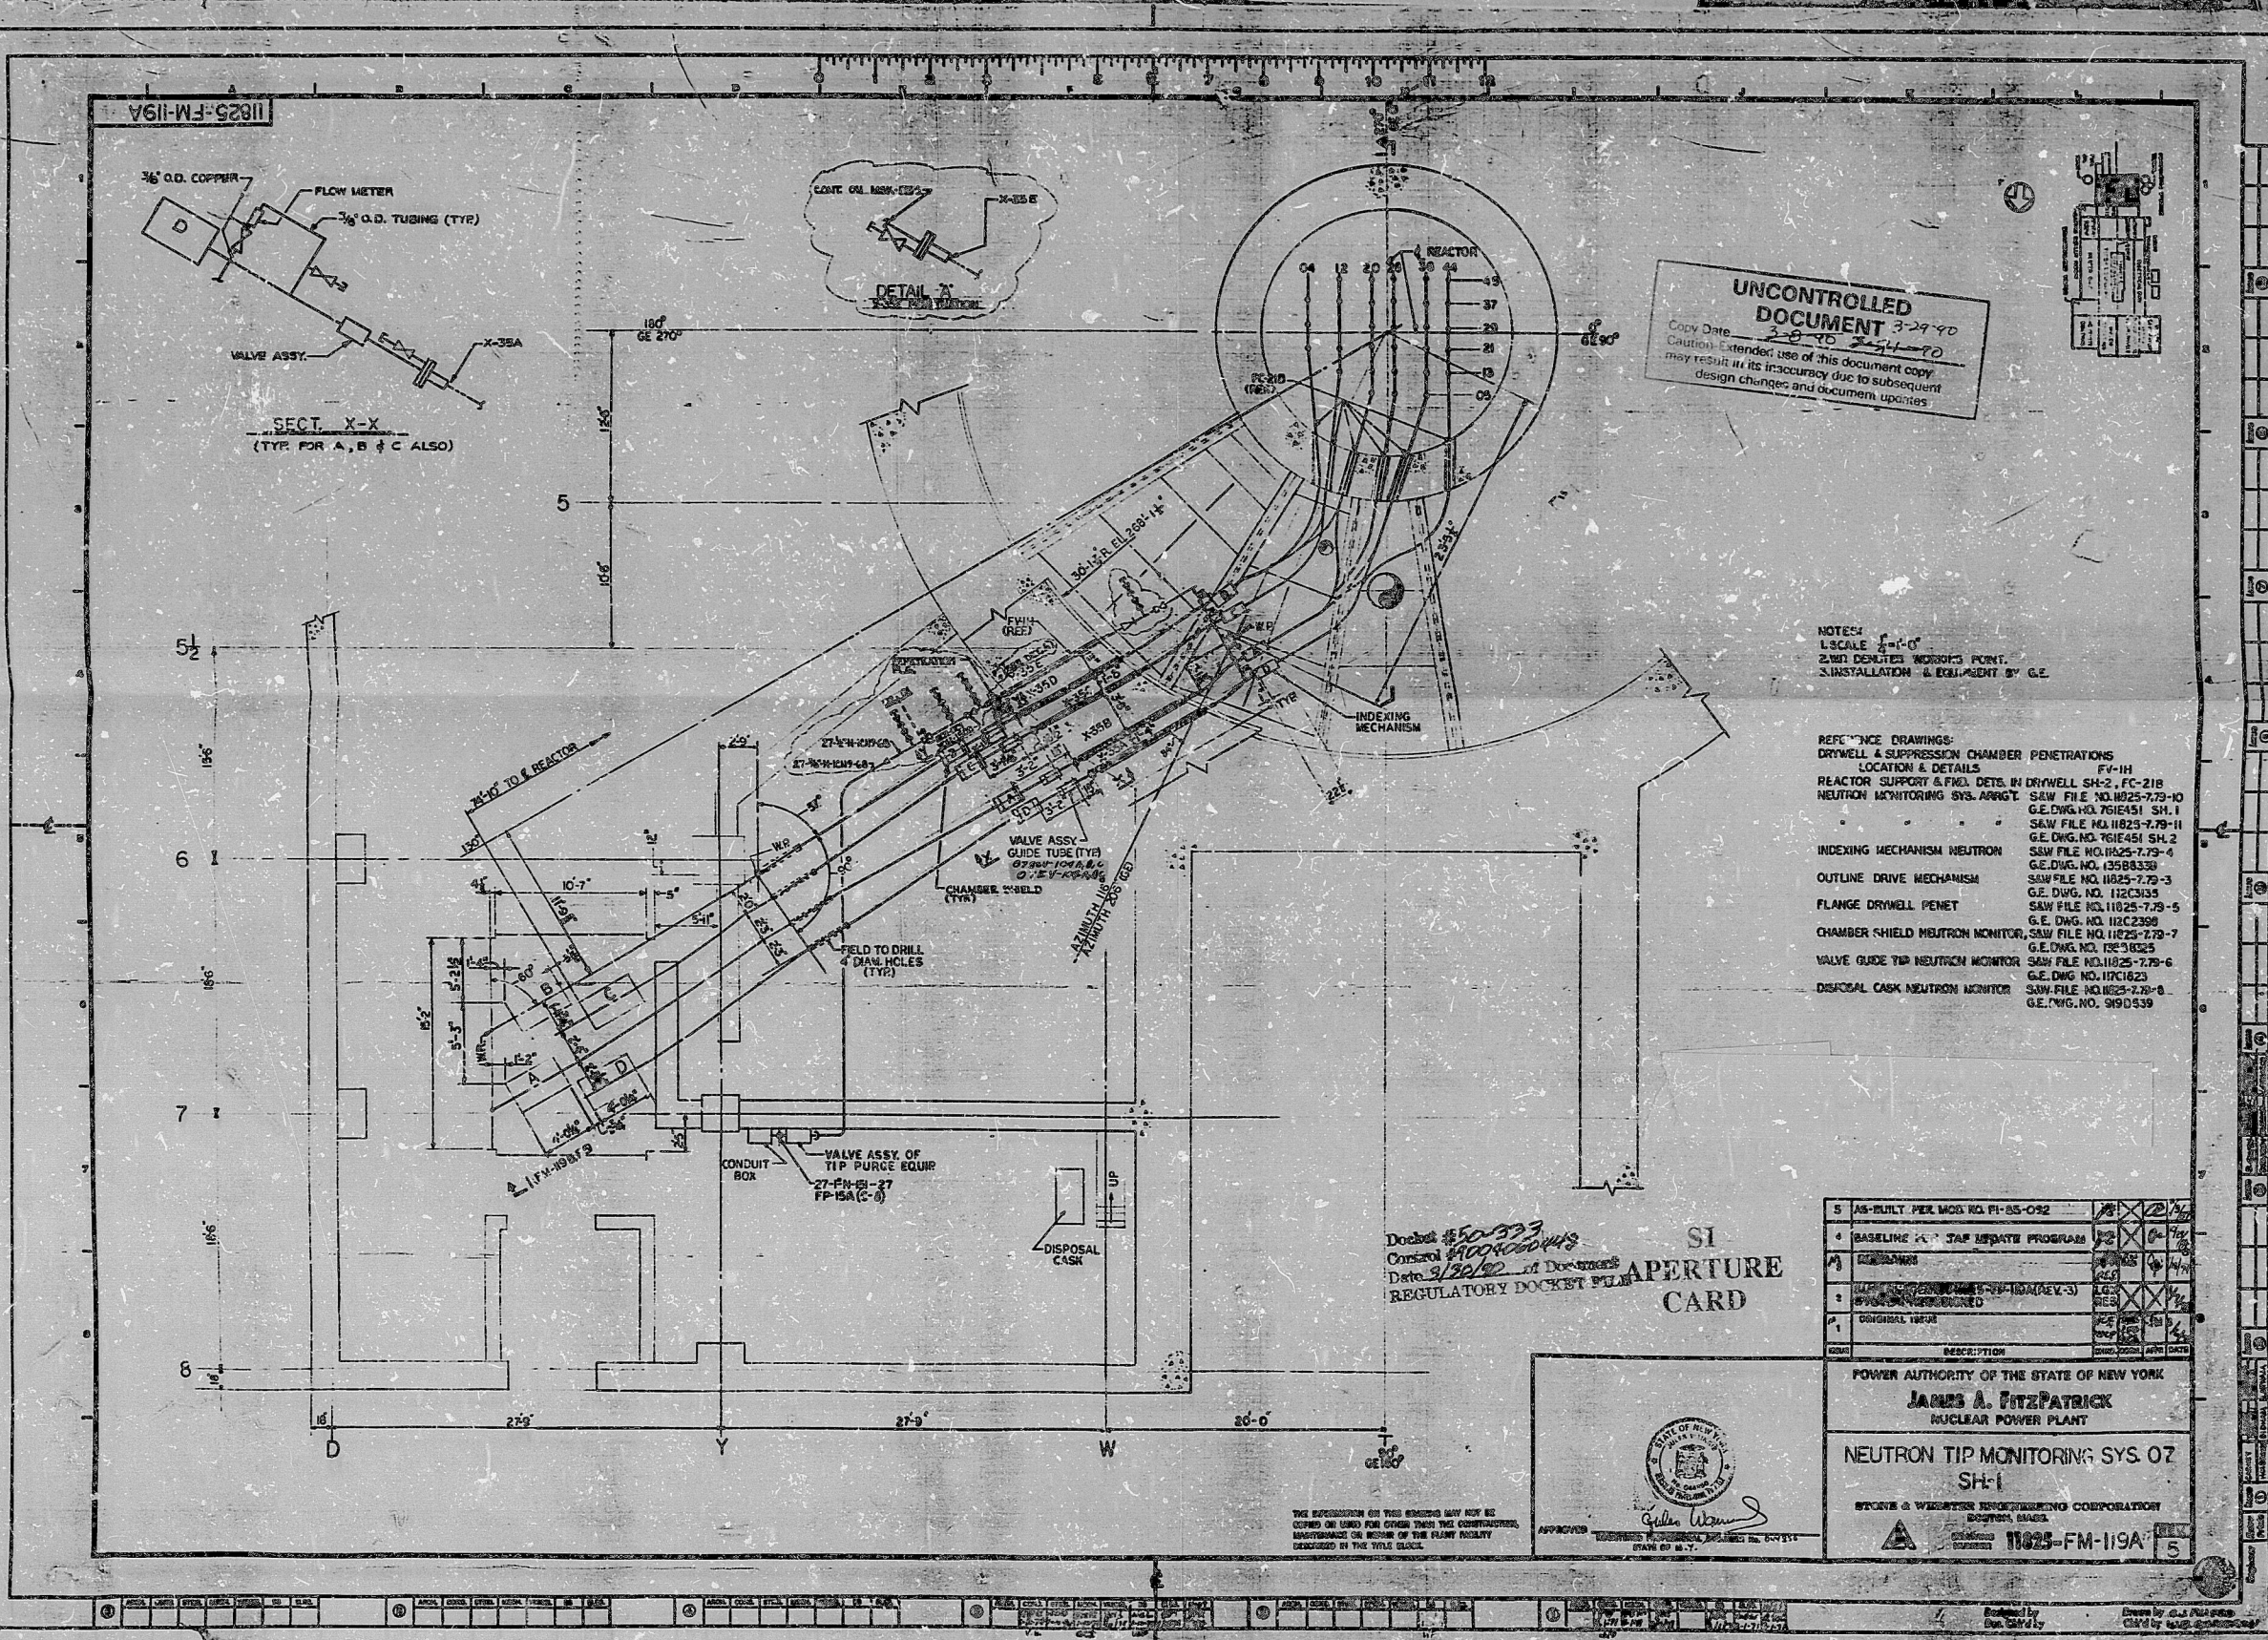