




RIDS

8308220460

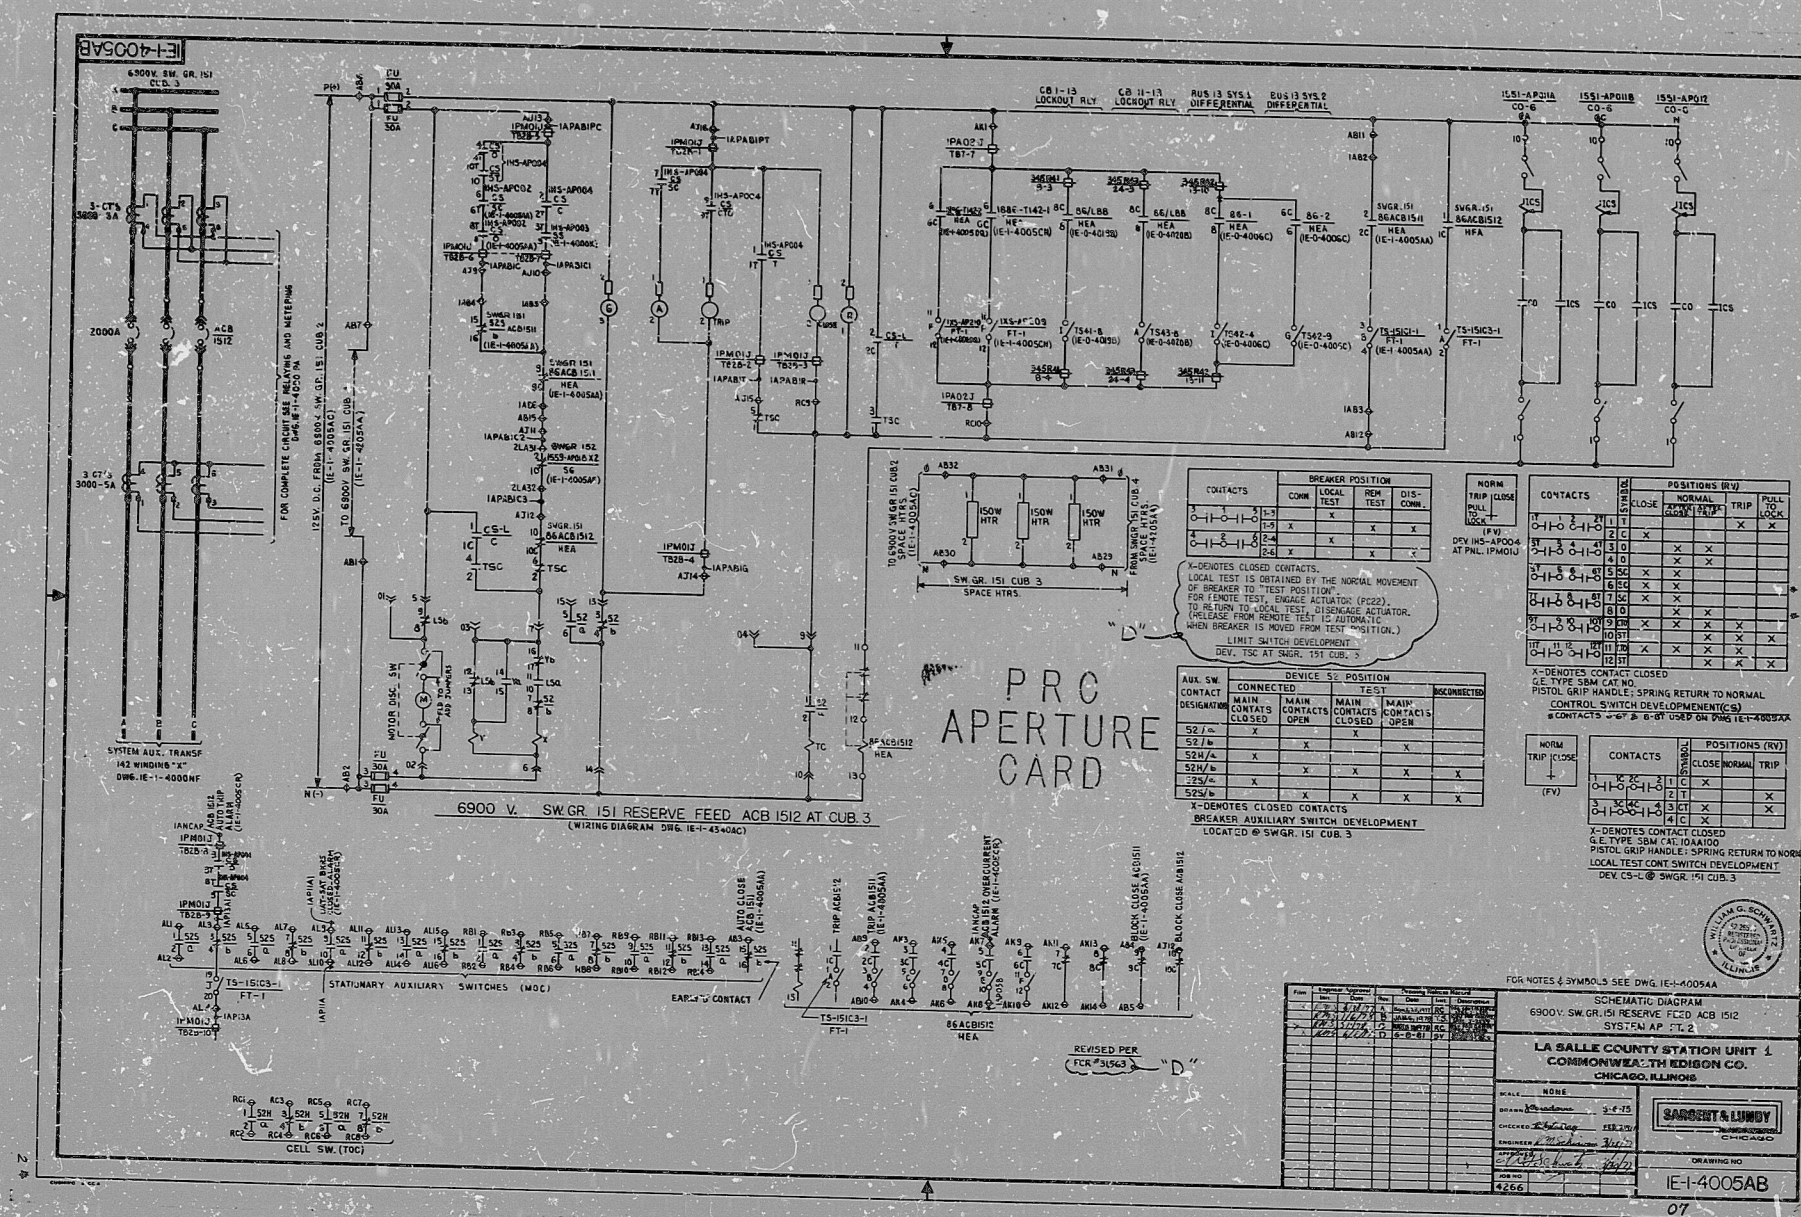