


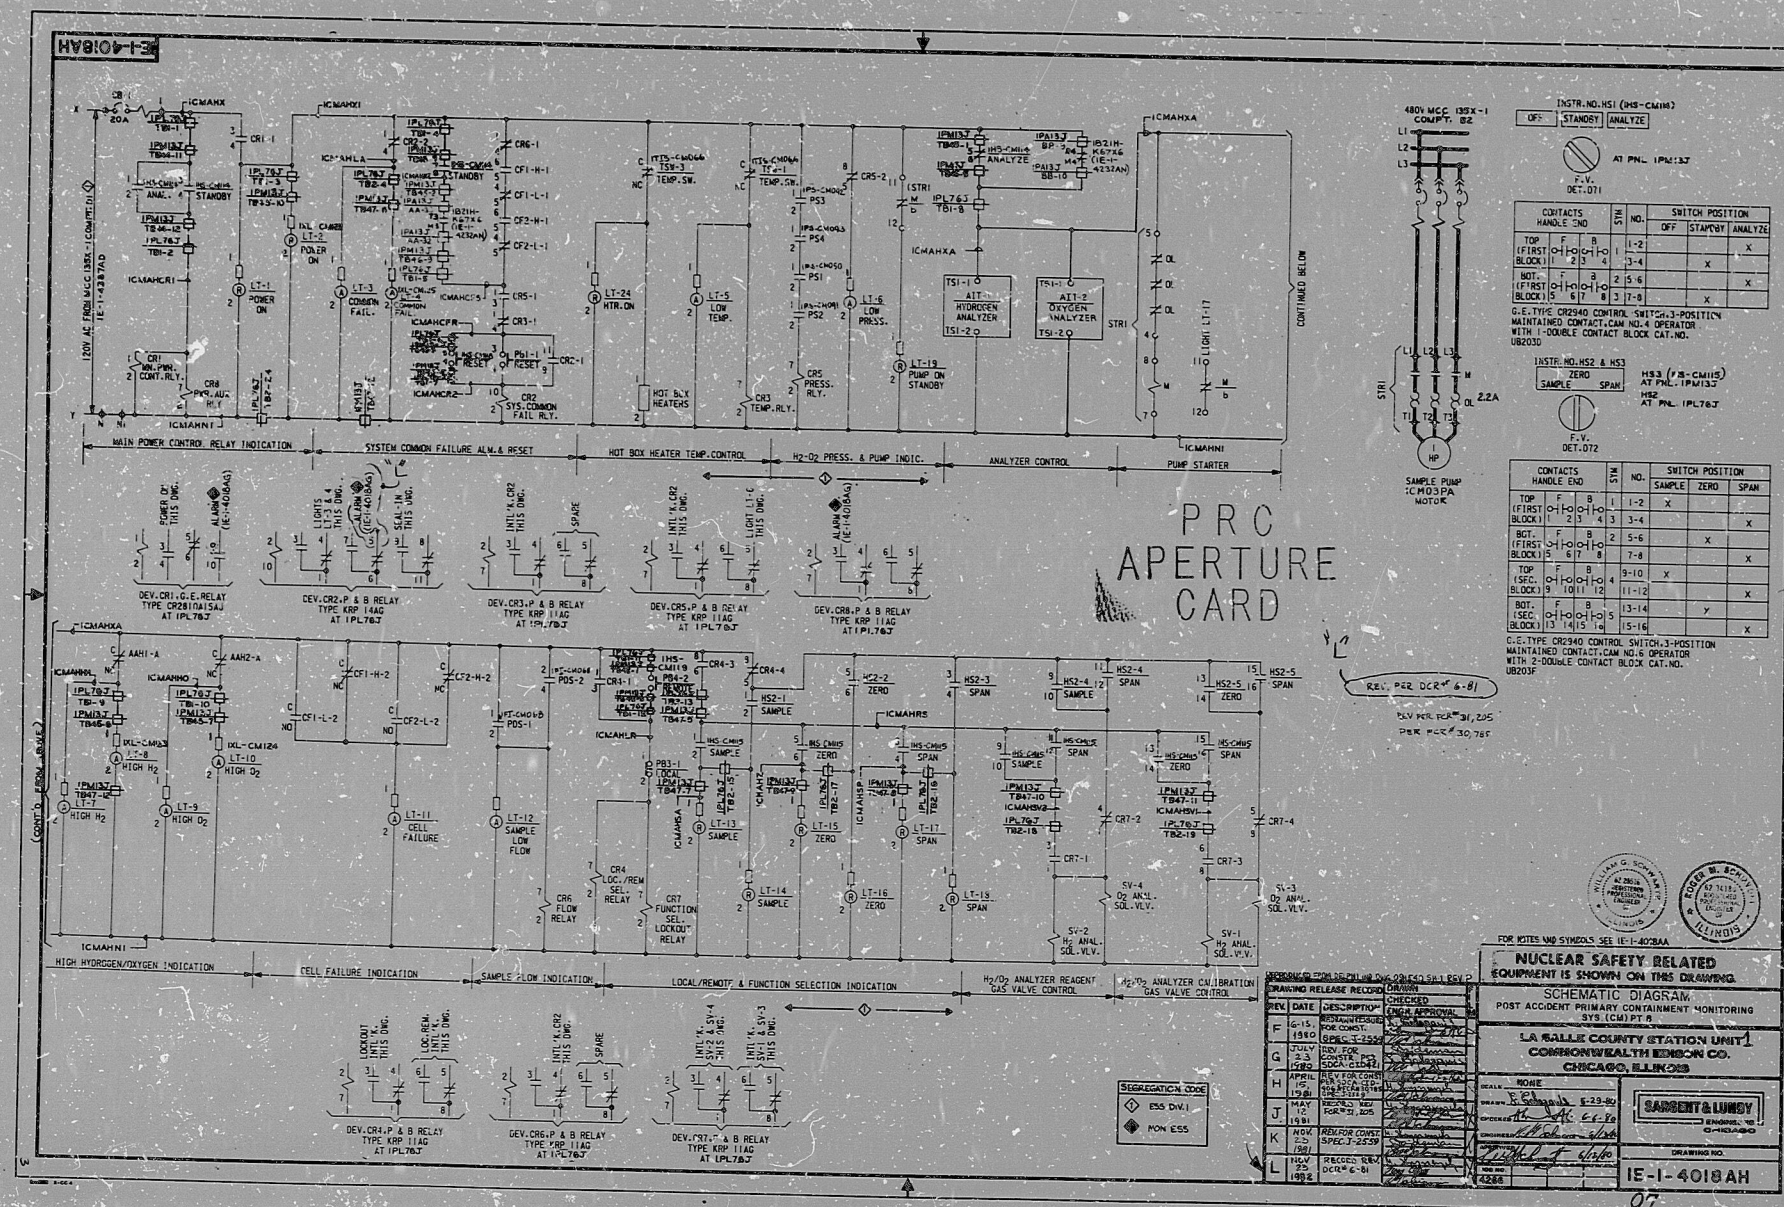

RIDS

808230600

