


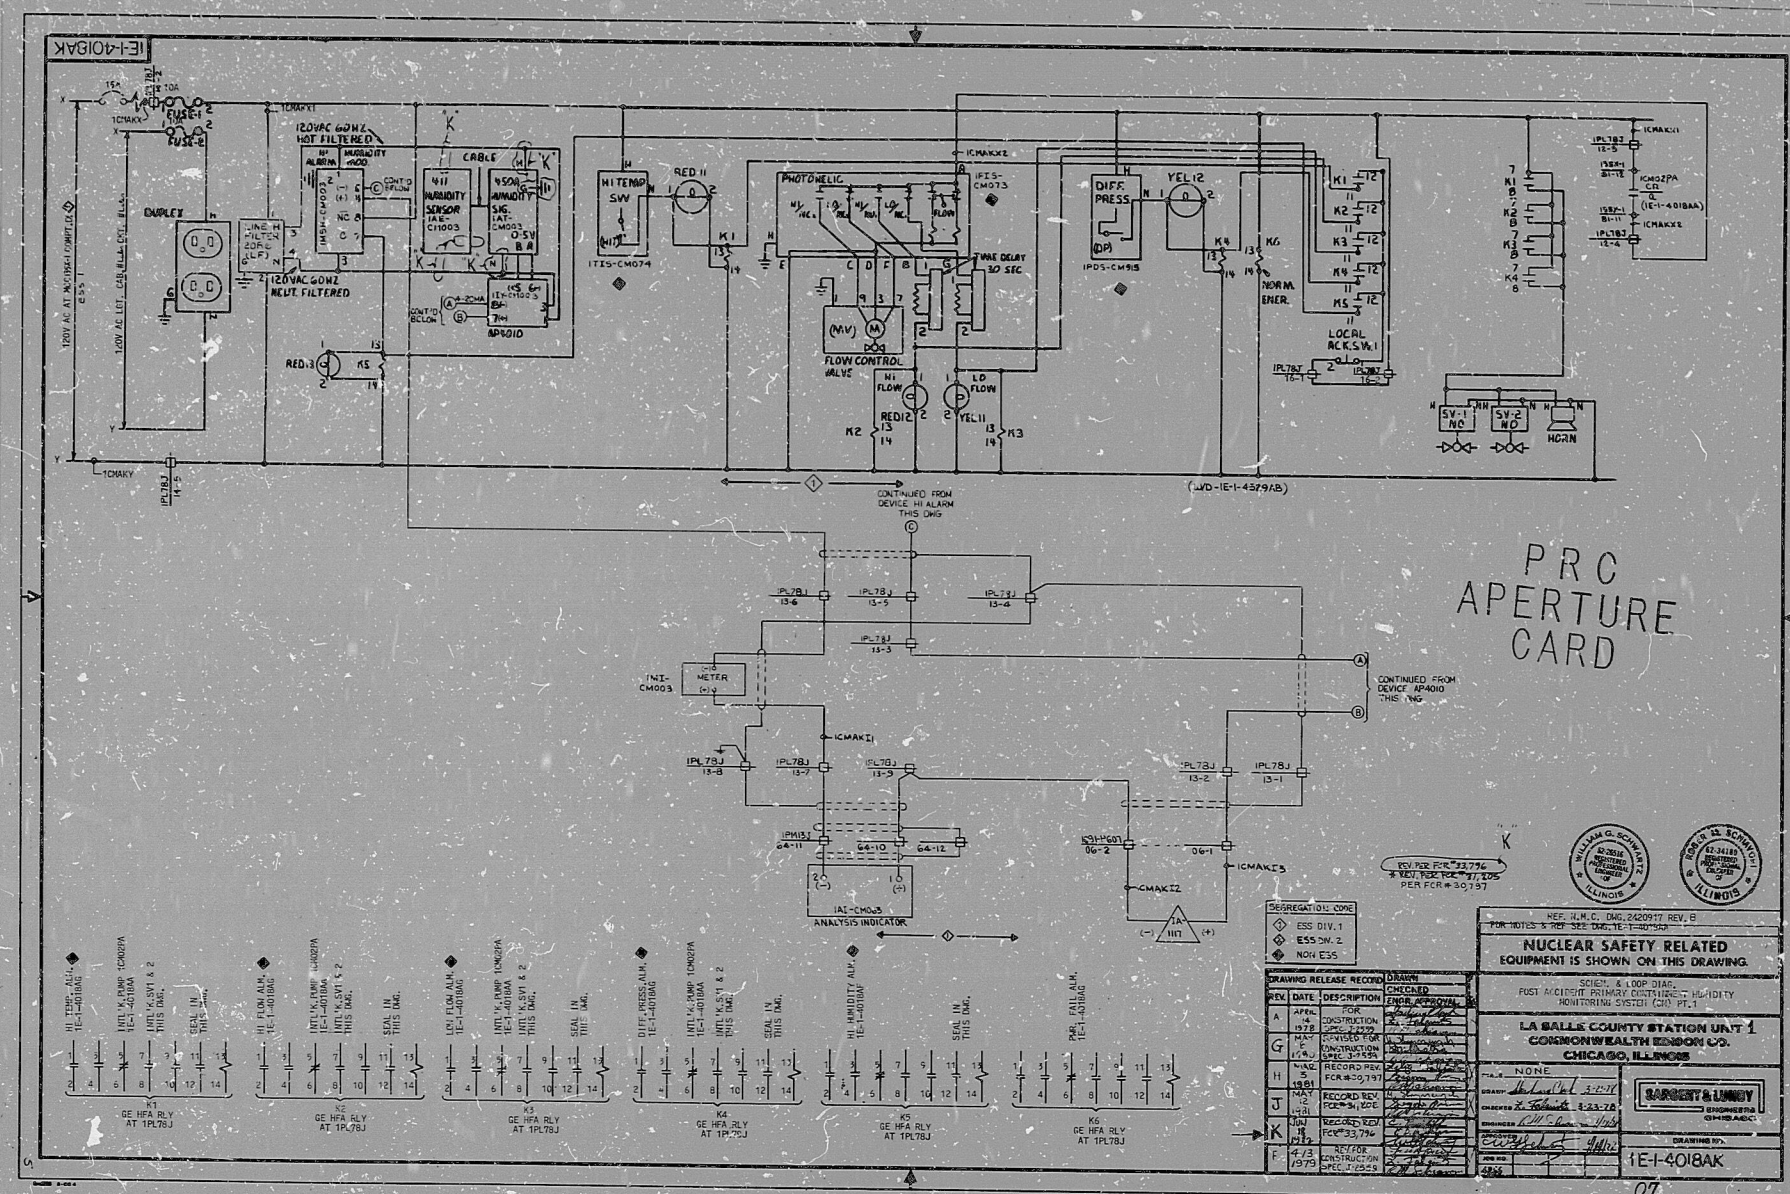



RIDS

8308230611

